



MAIN ST.

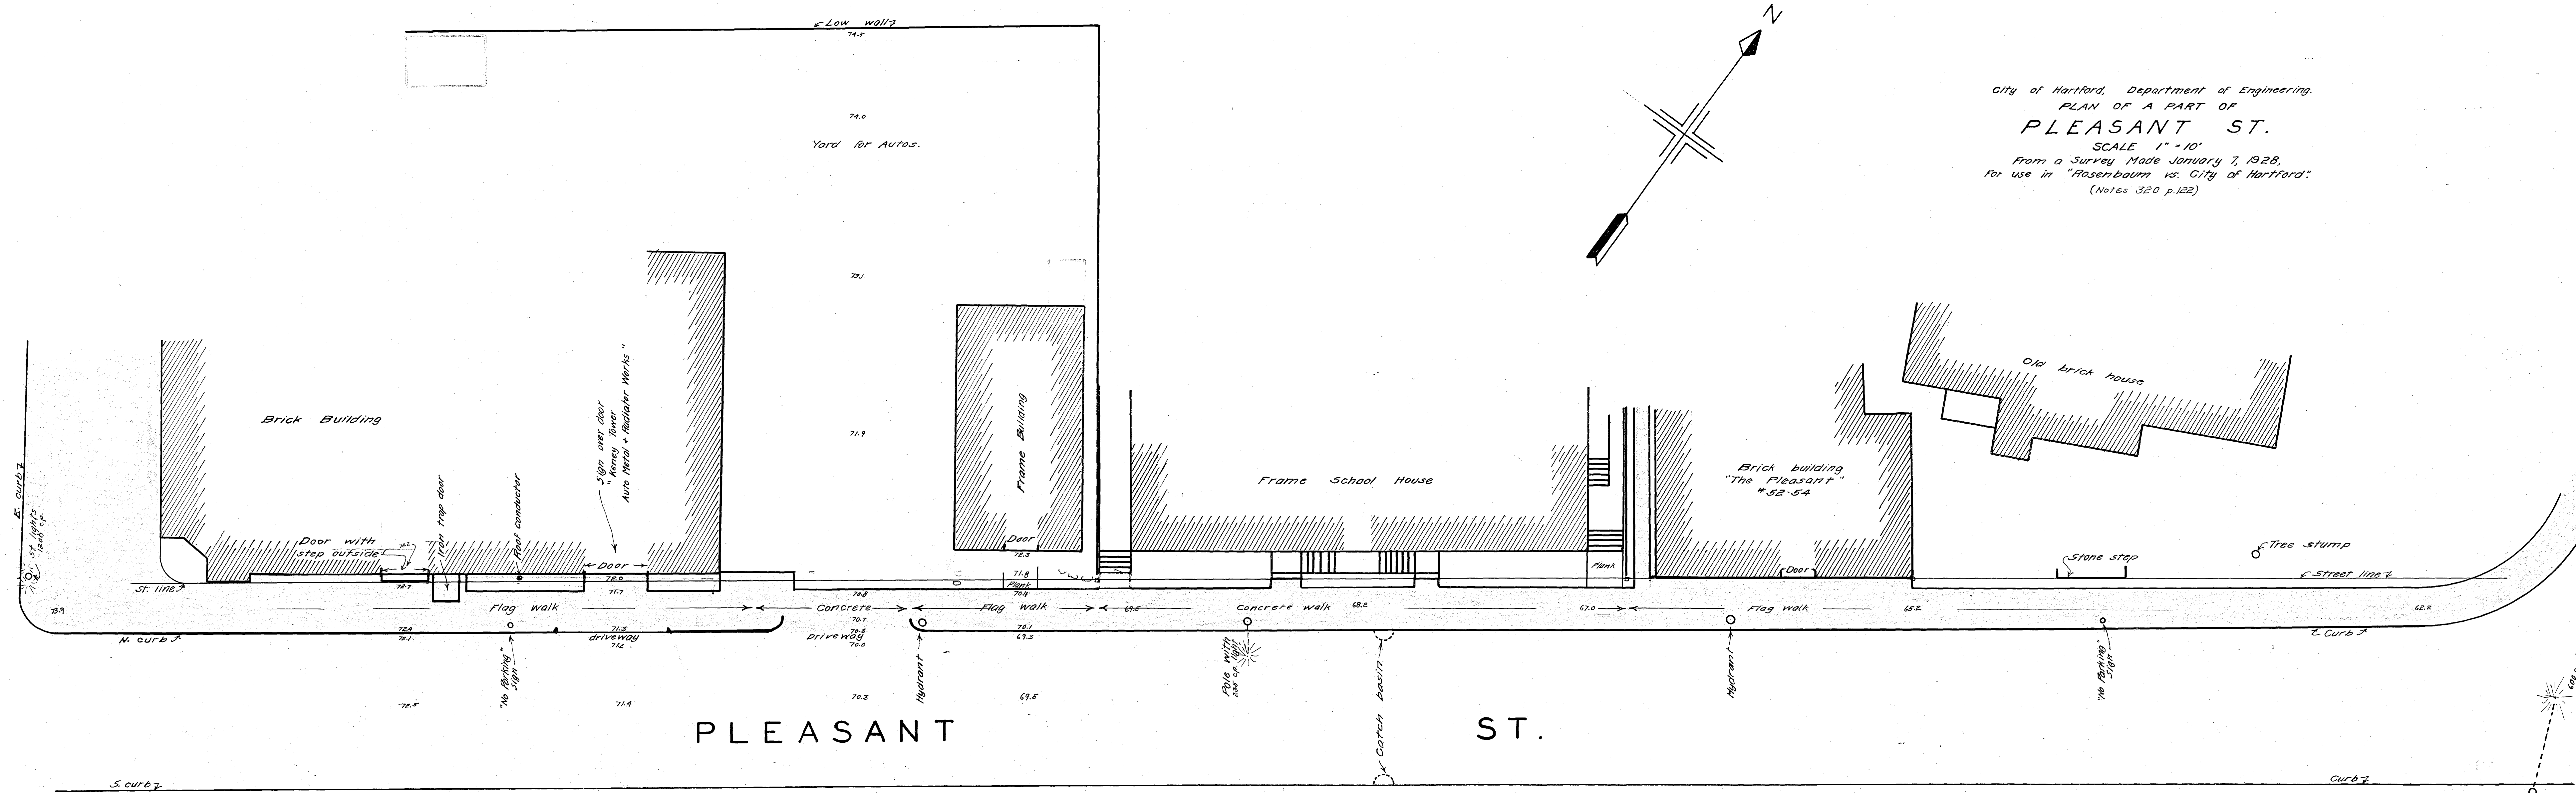

City of Hartford, Department of Engineering.
PLAN OF A PART OF
PLEASANT ST.
SCALE 1" = 10'
From a Survey Made January 7, 1928,
For use in "Rosenbaum vs. City of Hartford".
(Notes 320 p.122)

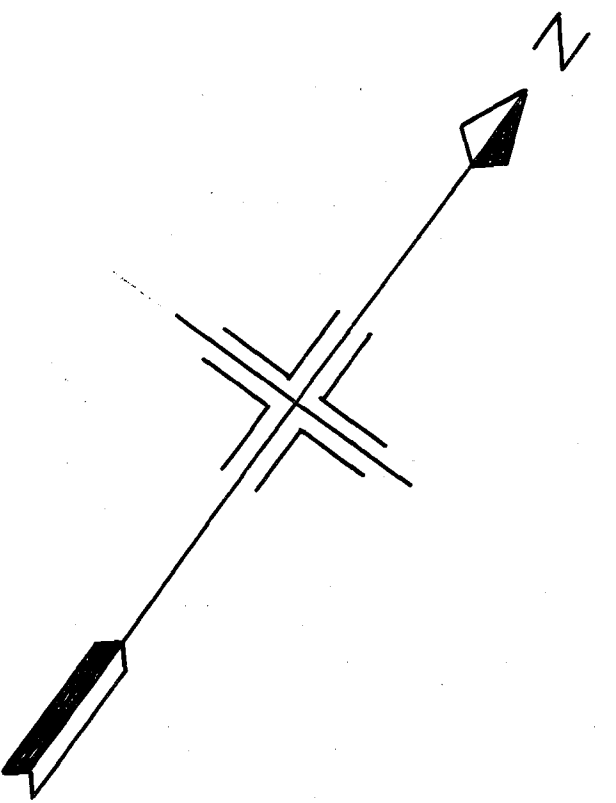

WINTHROP ST.

Illuminated bill-board here.