


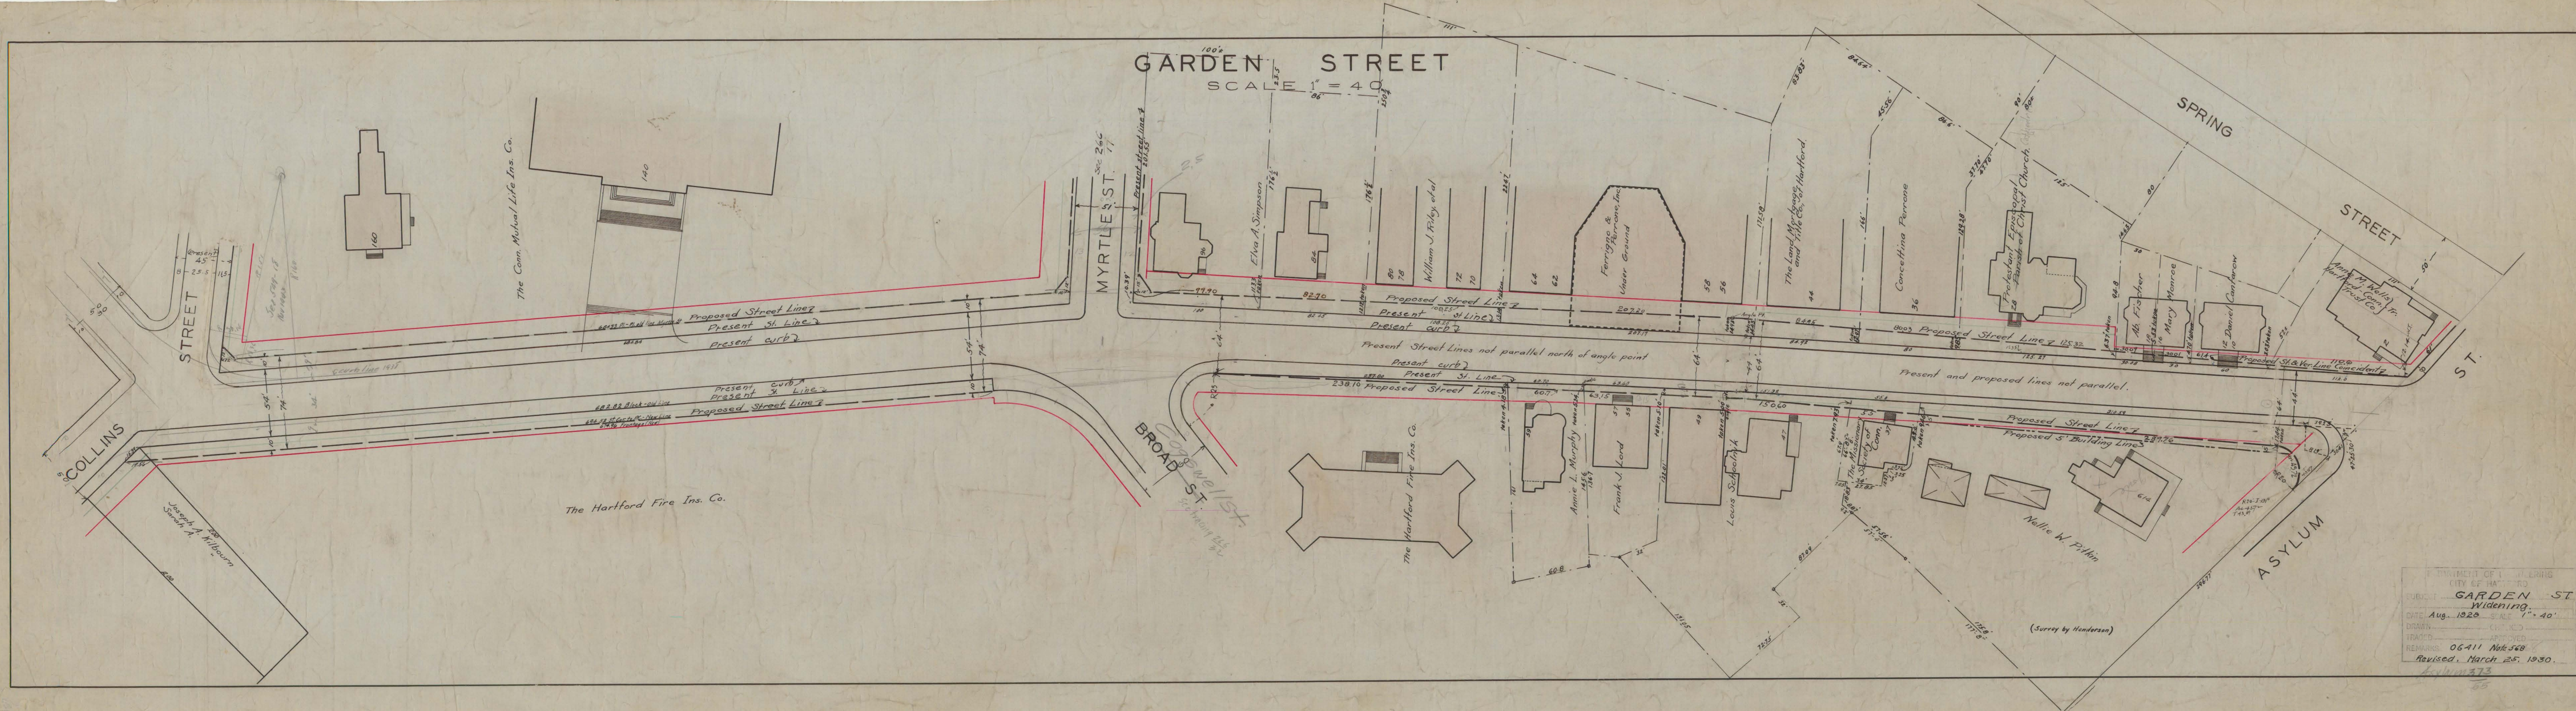

DEPARTMENT OF ENGINEERING
CITY OF HARTFORD
SUBJECT: **GARDEN ST.**
Widening.
DATE: Aug. 1928 SCALE: 1" = 40'
DRAWN: CH. KED
TRACED: APPROVED
REMARKS: 06411 Not 568
Revised, March 25, 1930.
Asylum 373
65