


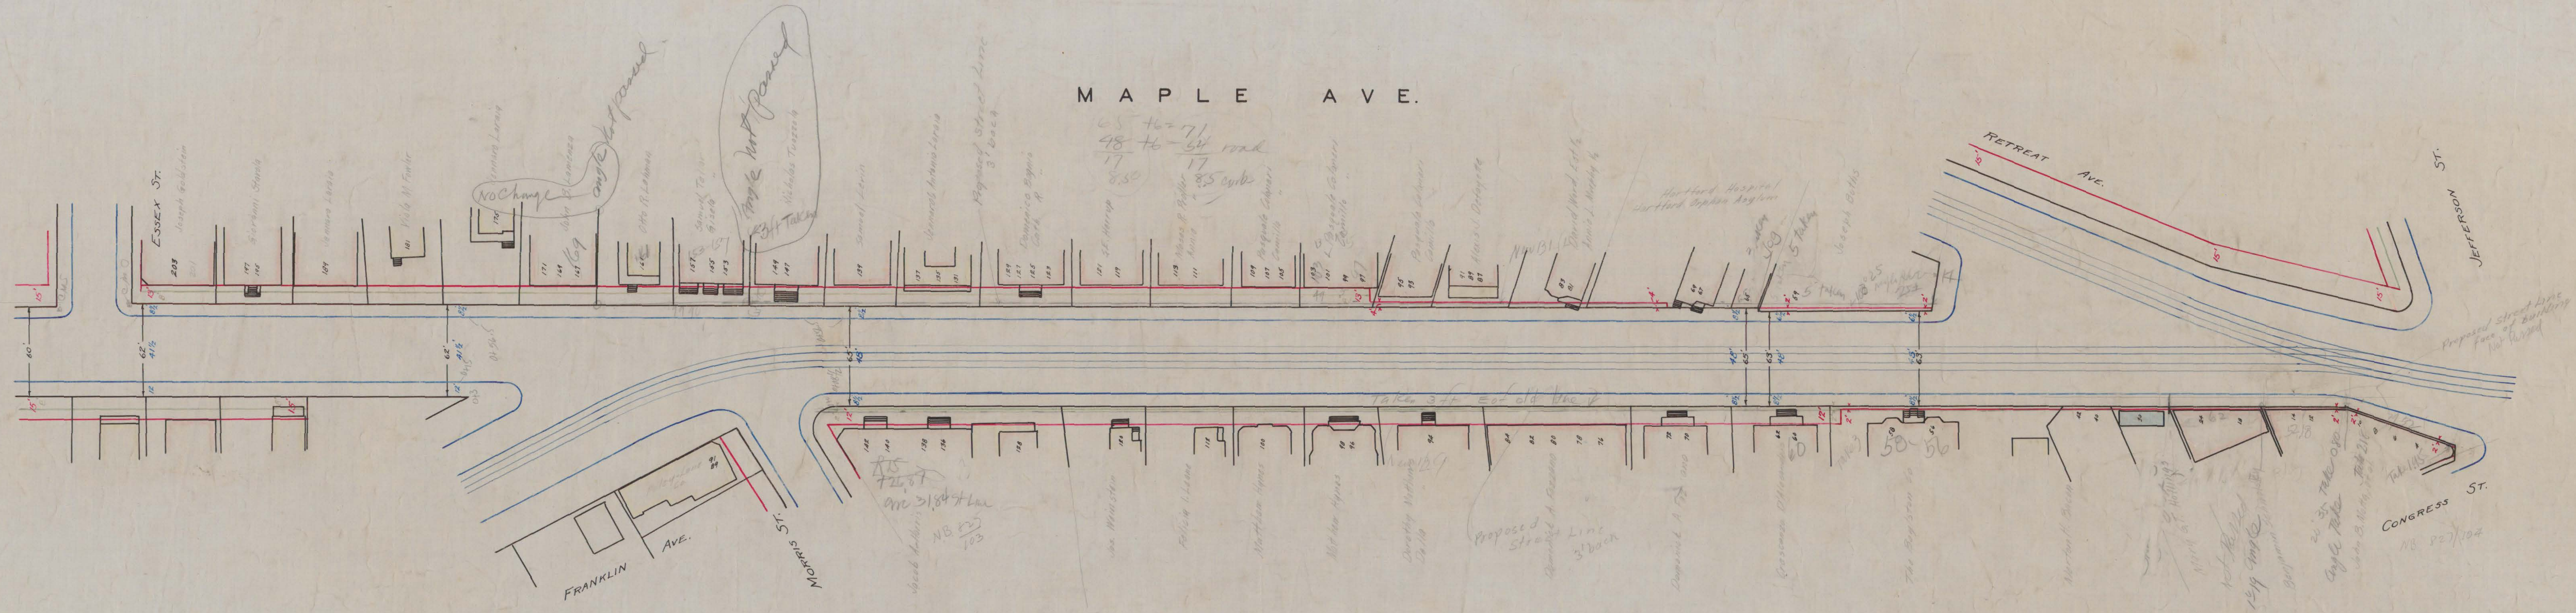

CITY OF HARTFORD
 Department of Engineering
 STUDY FOR MAPLE AVE. WIDENING.
 Scale 1"=40' April 1929.
 Day Book No. 06390.
 16-P-154