



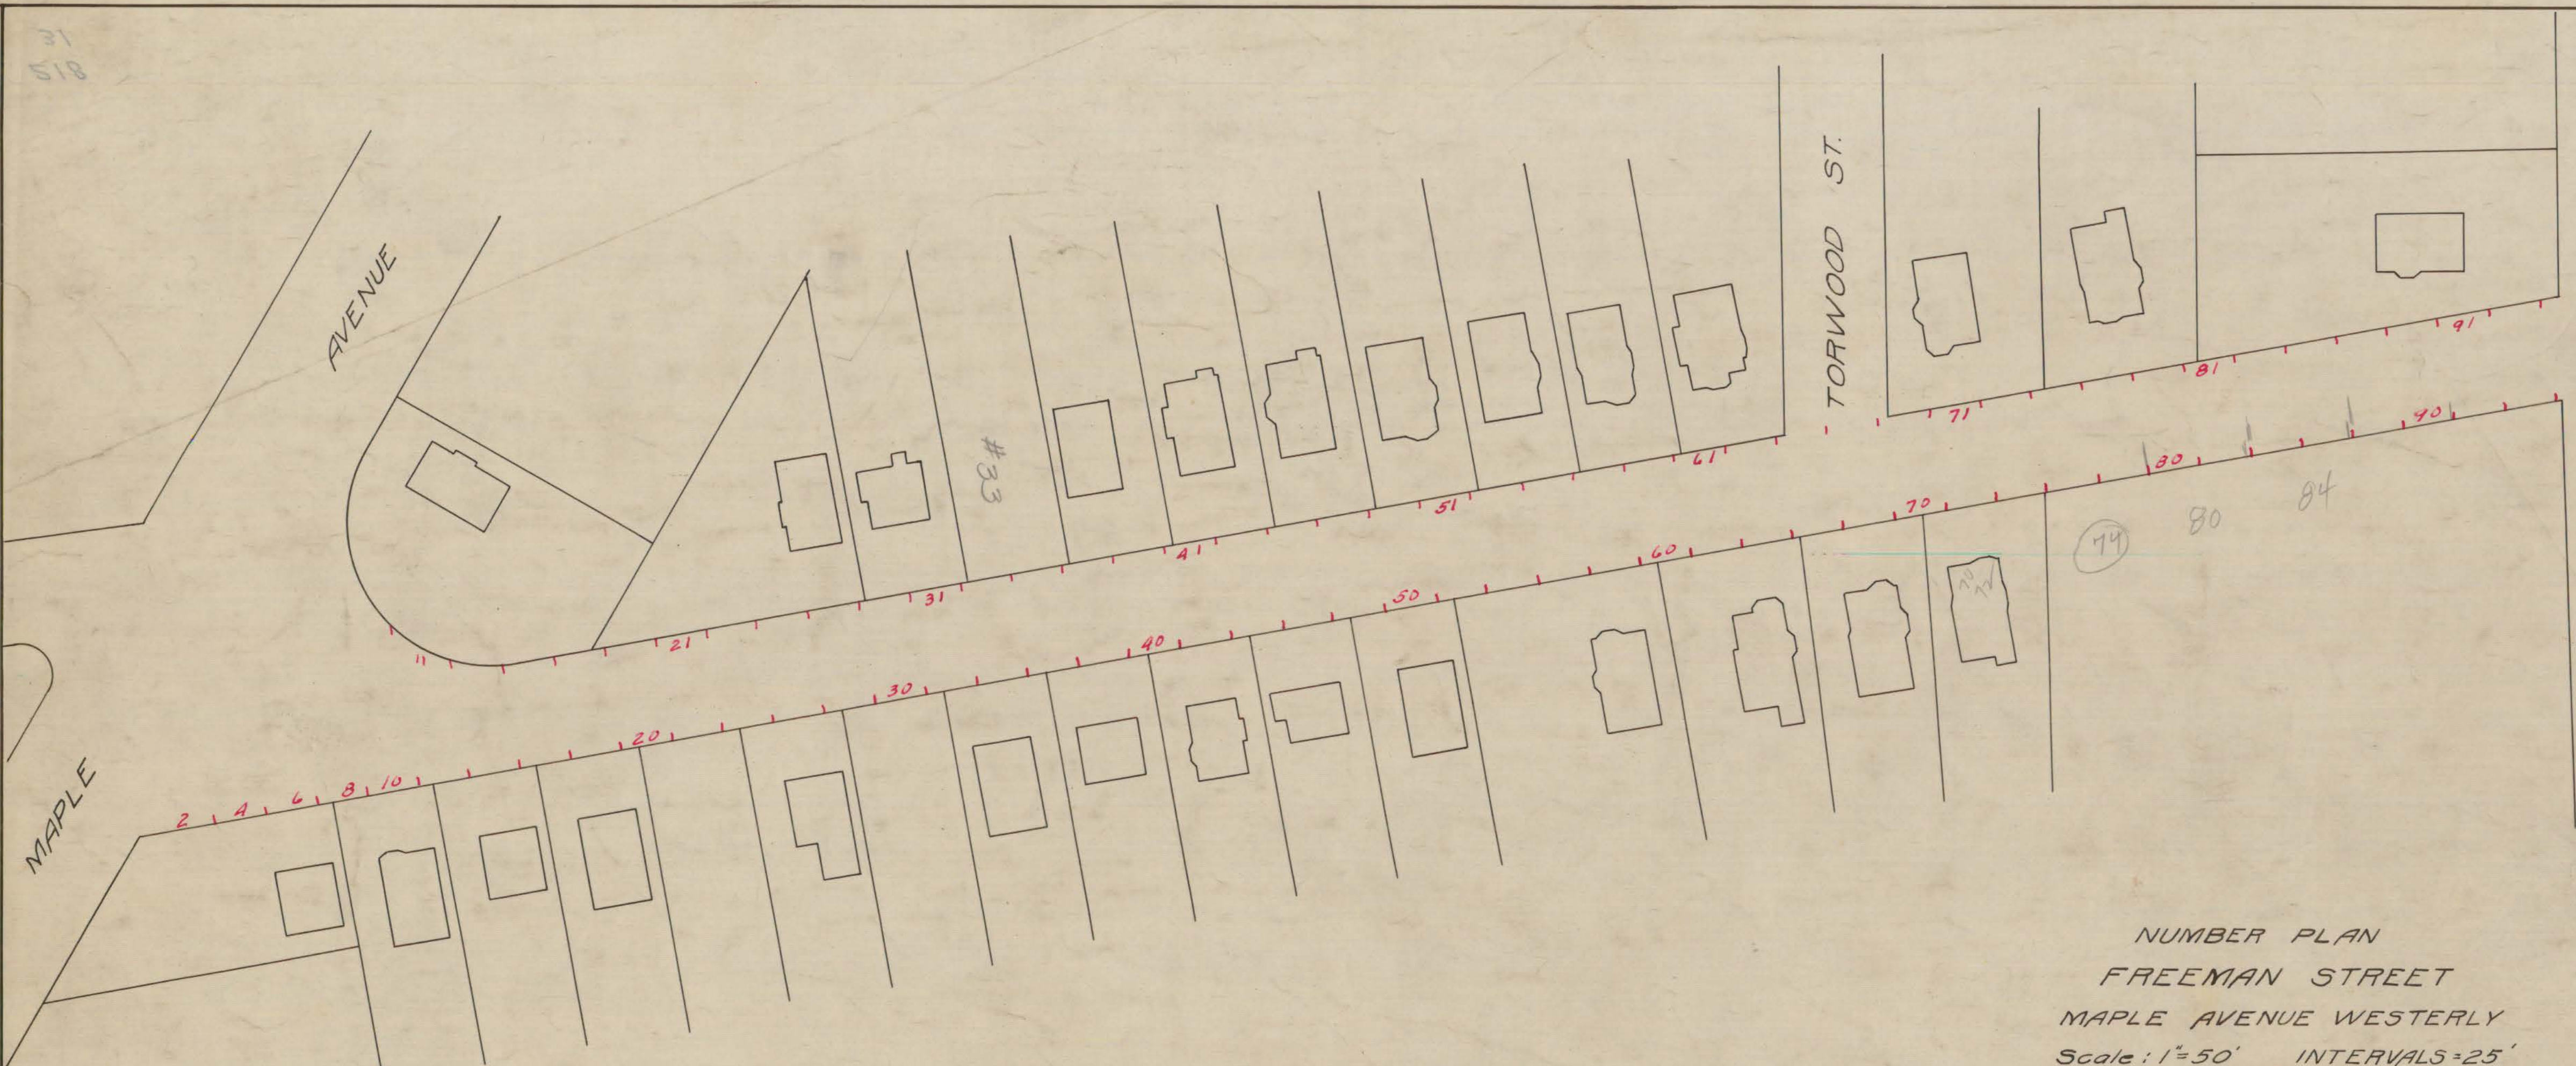

NUMBER PLAN
 FREEMAN STREET
 MAPLE AVENUE WESTERLY
 Scale: 1"=50' INTERVALS=25'
 NOV. 1923
 R. N. Clark
 City Engineer.

Daybook No. 05567
 Drawer No. 218. Sheet No. 31.

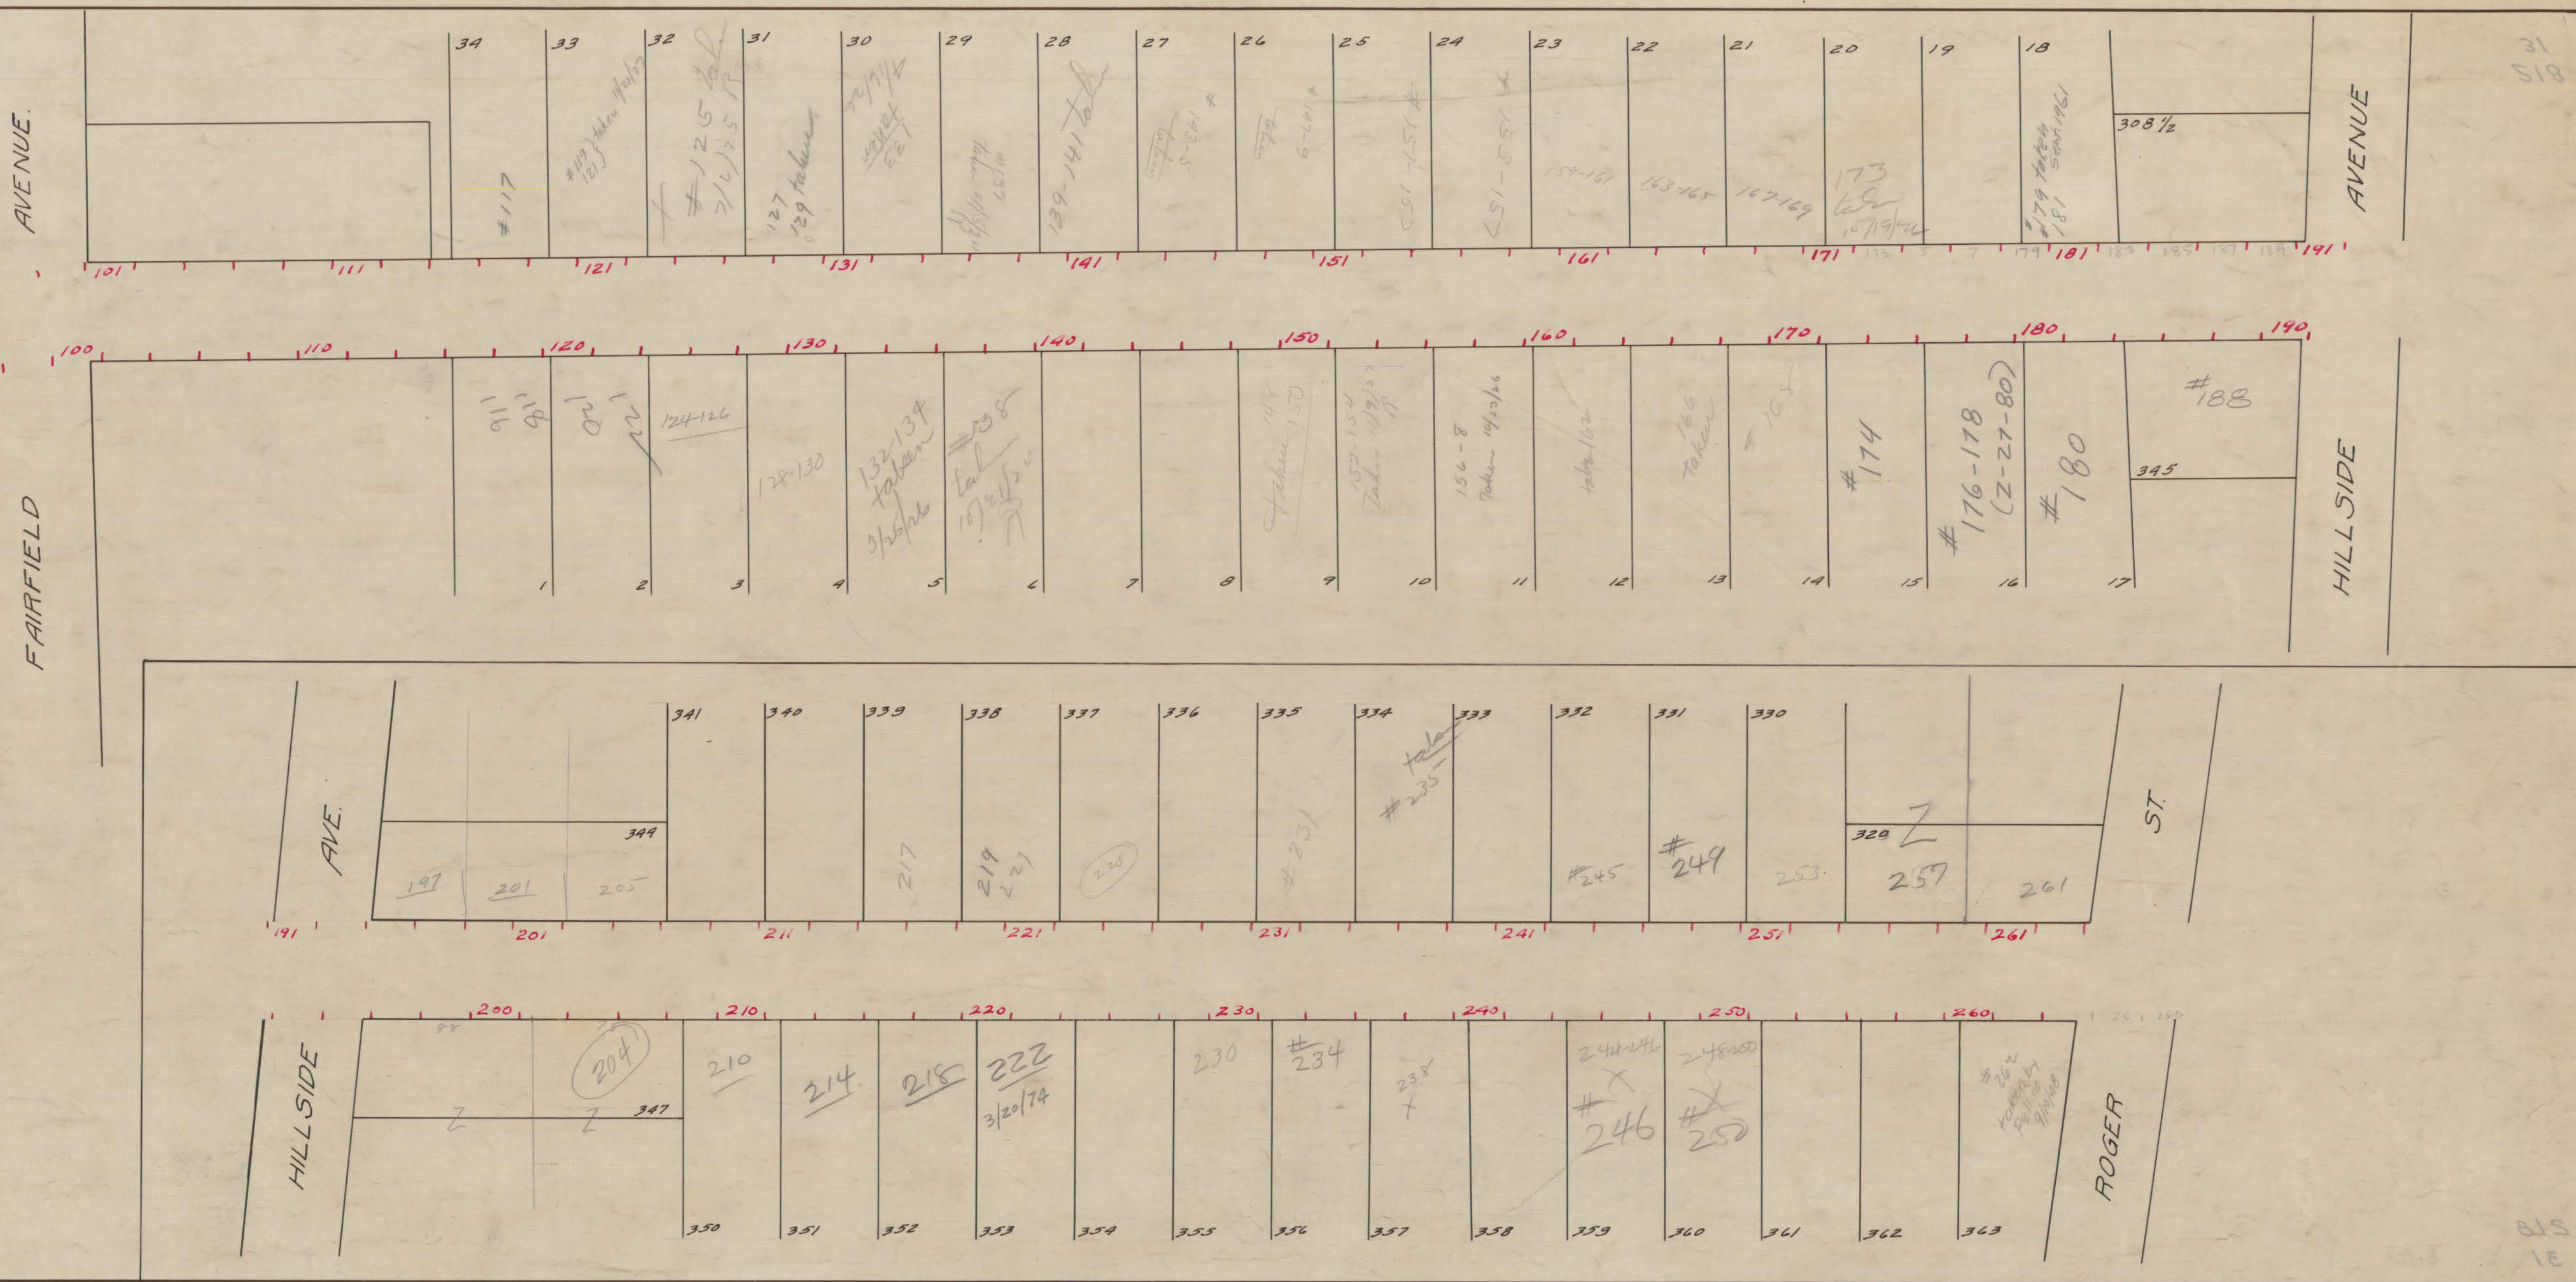

815
 18