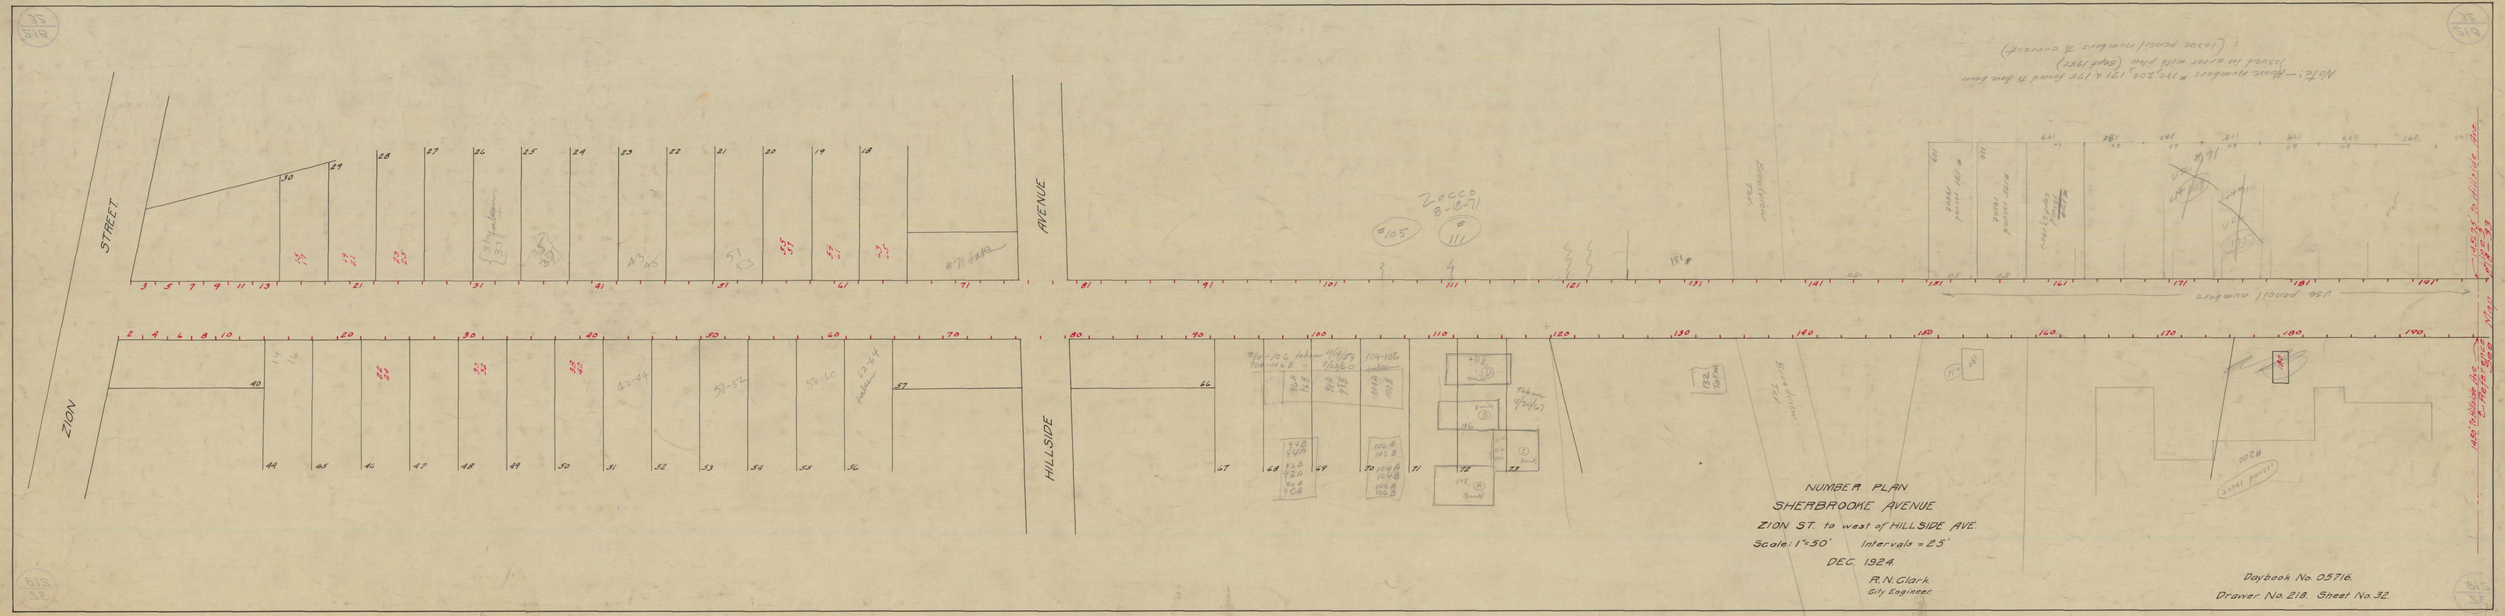
ZION STREET
HILLSIDE AVENUE
Use panel numbers
NUMBER PLAN
SHERBROOKE AVENUE
ZION ST. to west of HILLSIDE AVE.
Scale: 1"=50' Intervals = 25'
DEC. 1924
R.N. Clark.
City Engineer.
Daybook No. 05716.
Drawer No. 218. Sheet No. 32.