


1200 1100 1000 900 800 700 600 500 400 300 200 100 0 600 500 400 300 200 100 0

See (243) New Profile - 1904
~~GRANT ST.~~ EDGEWOOD ST

Scale: 1" Hori. = 100'
 1" Vert. = 10'

B.M. Bench Pit. S.W. cor. #6 Raymond St.
 El. 81.46

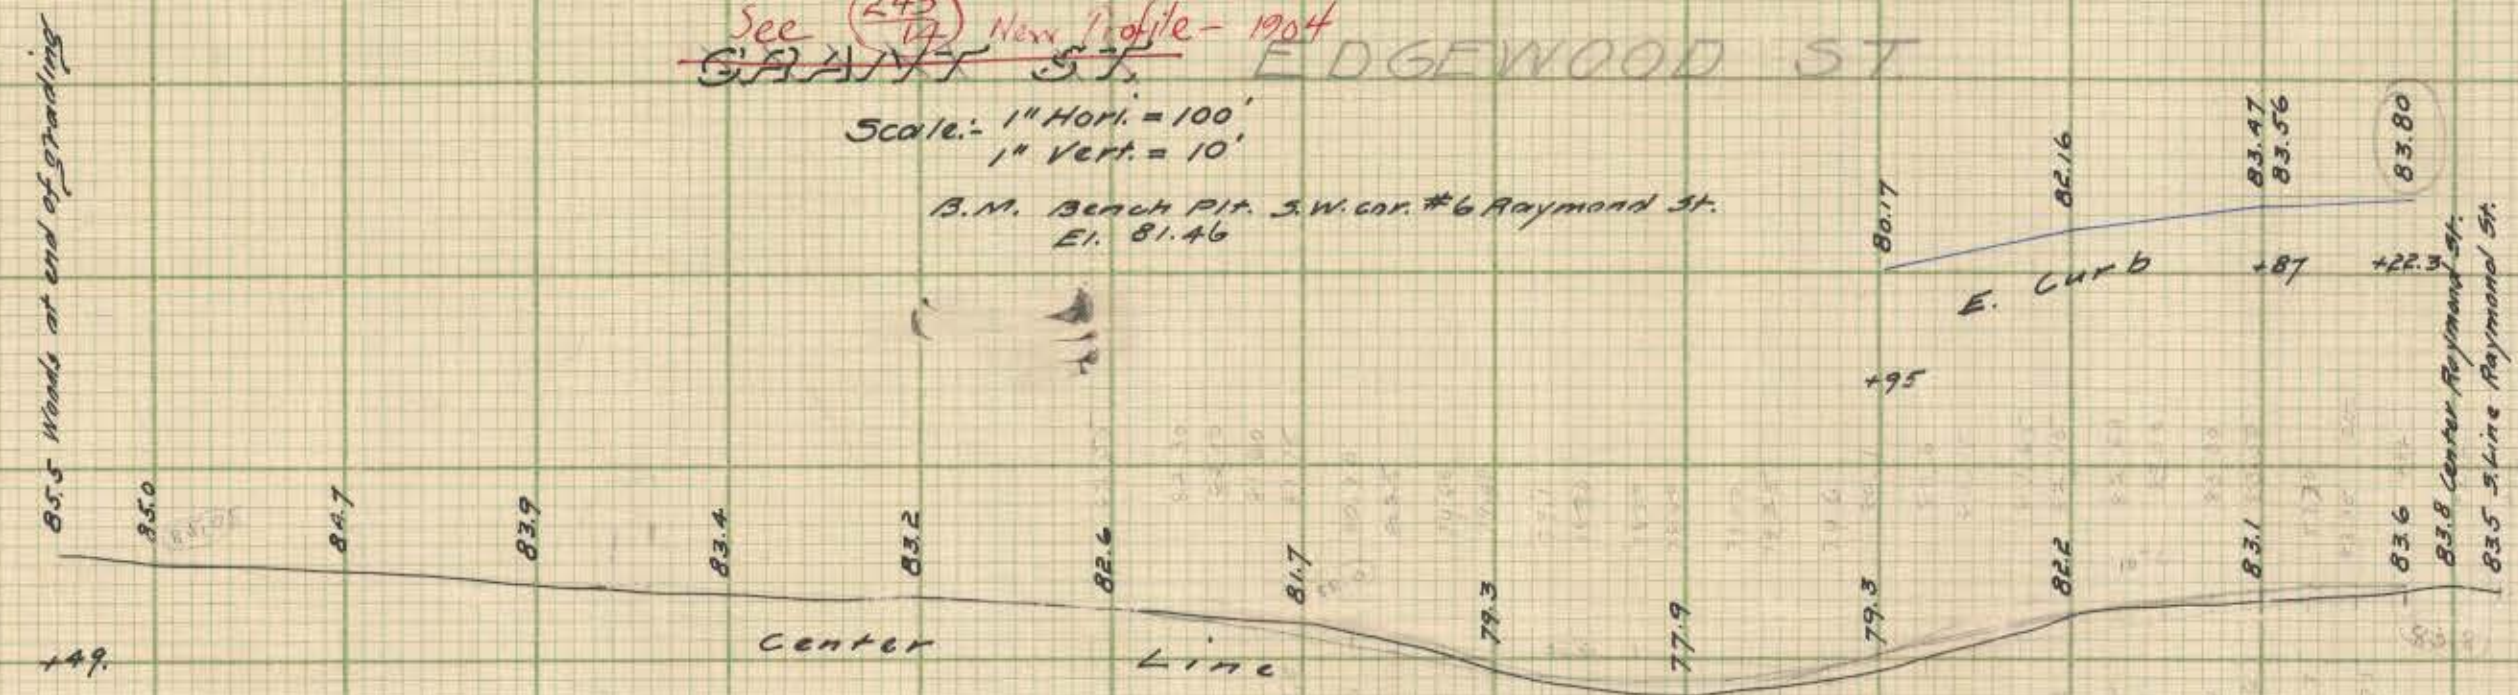

CITY ENGINEER'S OFFICE,
 HARTFORD, CONN.
 STREET & MISCELLANEOUS DEPT.

Date Nov. 2, 1901 Day Book No. 01177

Notes Vol. 167 Pgs. 80-82

City Engineer

V.5. P 49
 RAYMOND ST

Scale: 1" Hori. = 100'
 1" Vert. = 10'

B.M. Bench Pit. S.E. cor. #199 Vine St.
 Between Raymond & Capen Sts.
 El. 75.32



0+12.50 - Curb S.W. cor. #199 Vine St.
