

PROSPECT AVE.


Scale: 1" Hori. = 50'
1" Vert. = 10'

B. M. City Line Stone cor. Farmington Ave. & Prospect Ave.
Elev. 101.78

Note: Stations check with profile 181-A

See Profile 181-4 - V4 P322 1899 -> L-V5 page 74-1903

Center Farmington Ave.

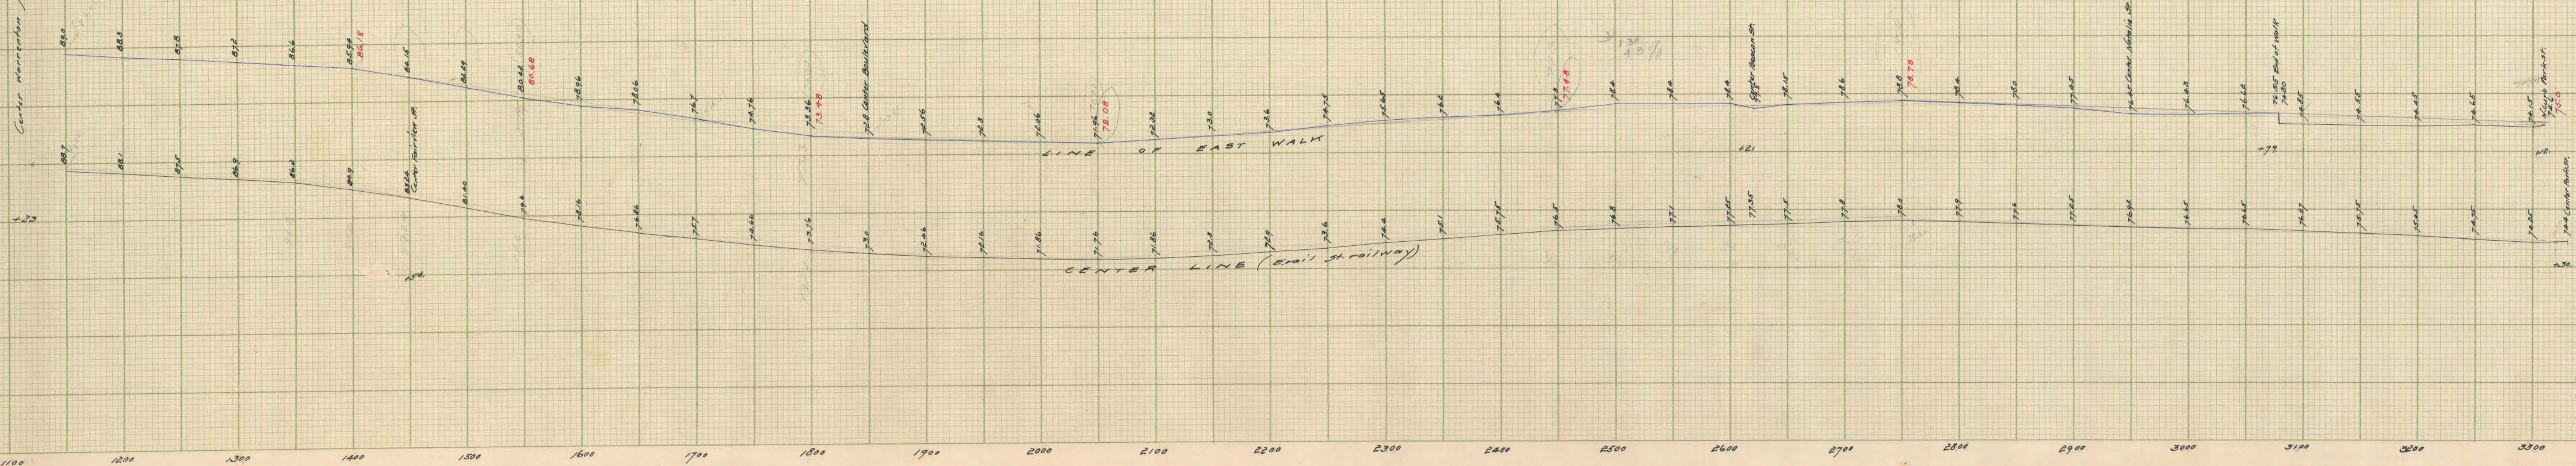

For Grade layout
see Vol. 5 p 74

CITY ENGINEER'S OFFICE,
HARTFORD, CONN.
STREET & MISCELLANEOUS DEPT.
Date Dec 3, 1901 Day Book No. 01186
Vol. 187 - 190 102-106
City Engineer