


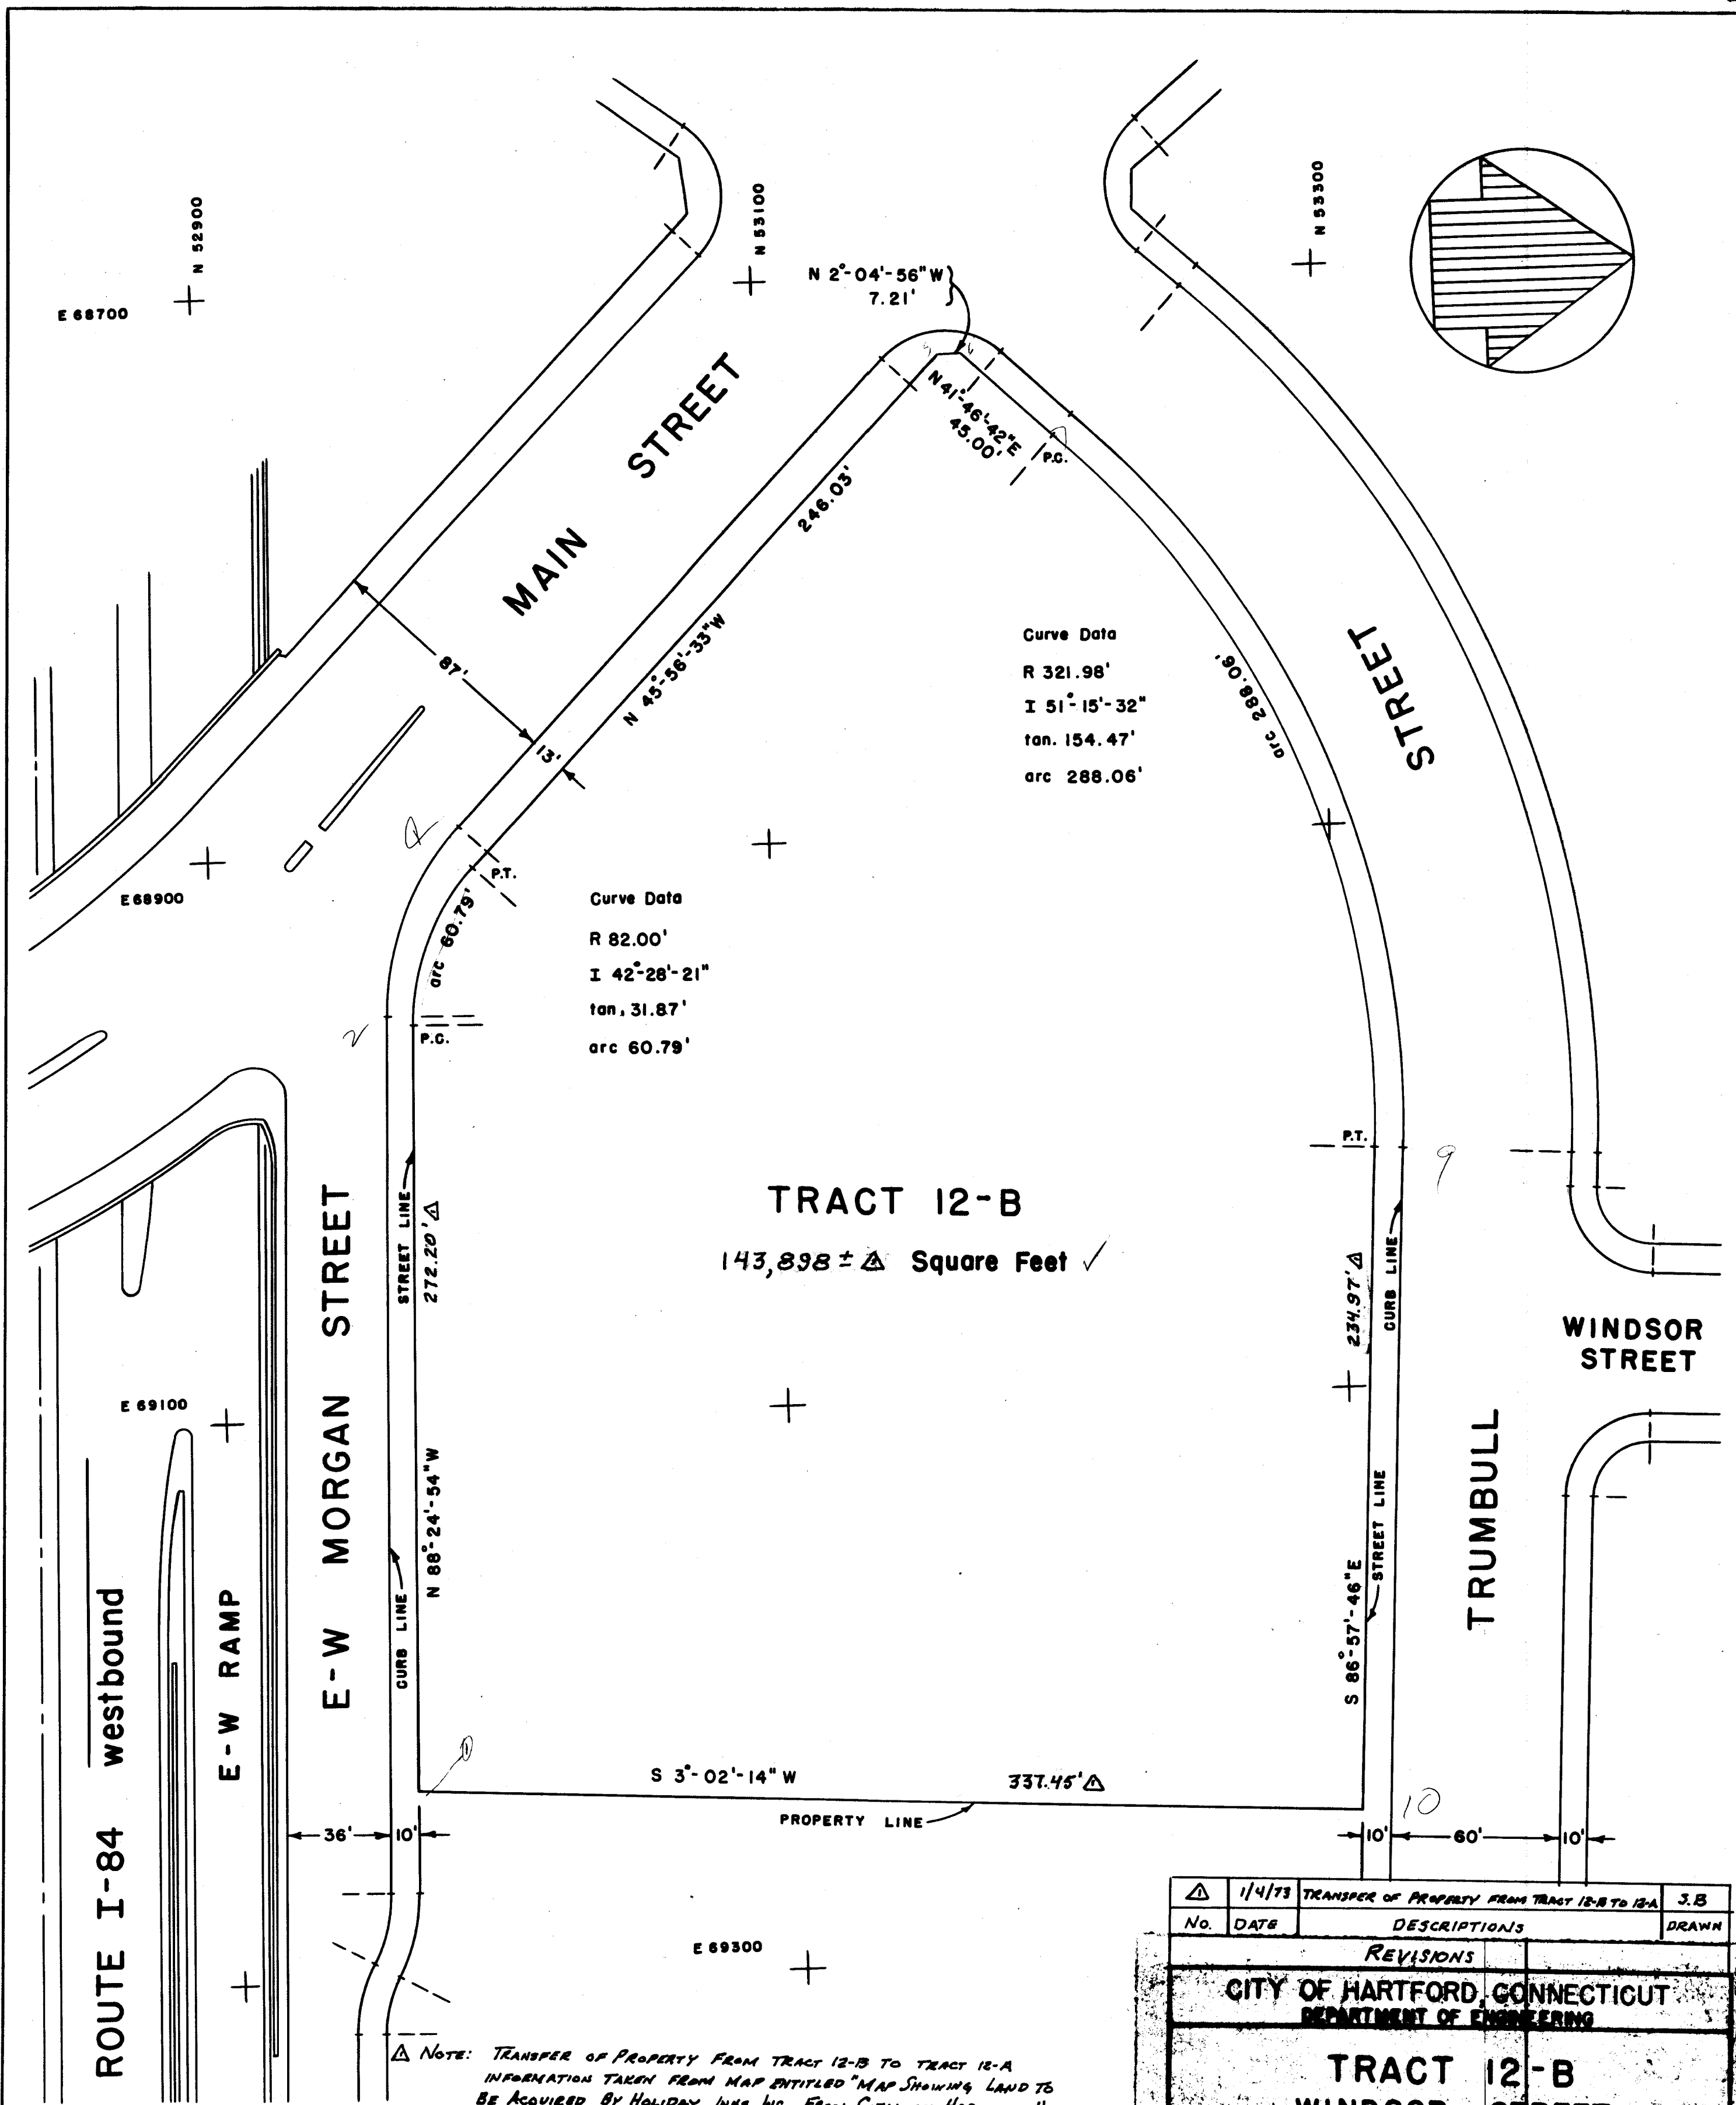

NOTE: TRANSFER OF PROPERTY FROM TRACT 12-B TO TRACT 12-A
INFORMATION TAKEN FROM MAP ENTITLED "MAP SHOWING LAND TO
BE ACQUIRED BY HOLIDAY INNS INC. FROM CITY OF HARTFORD"
PREPARED BY C.E. MAQUIRE, INC. DATED 11/13/73 SCALE: 1" = 0.4'

No.	DATE	DESCRIPTIONS	DRAWN
1	11/4/73	TRANSFER OF PROPERTY FROM TRACT 12-B TO 12-A	J.B.
REVISIONS			
CITY OF HARTFORD, CONNECTICUT DEPARTMENT OF ENGINEERING			
TRACT 12-B WINDSOR STREET REDEVELOPMENT PROJECT			
DESIGN R.L.L. DRAWN R.L.L.		DAYBOOK NO. 010003	
CHECKED R.L.L. CHECK J.L.L.		SCALE 1" = 40'	
		DATE OCTOBER 1987	