


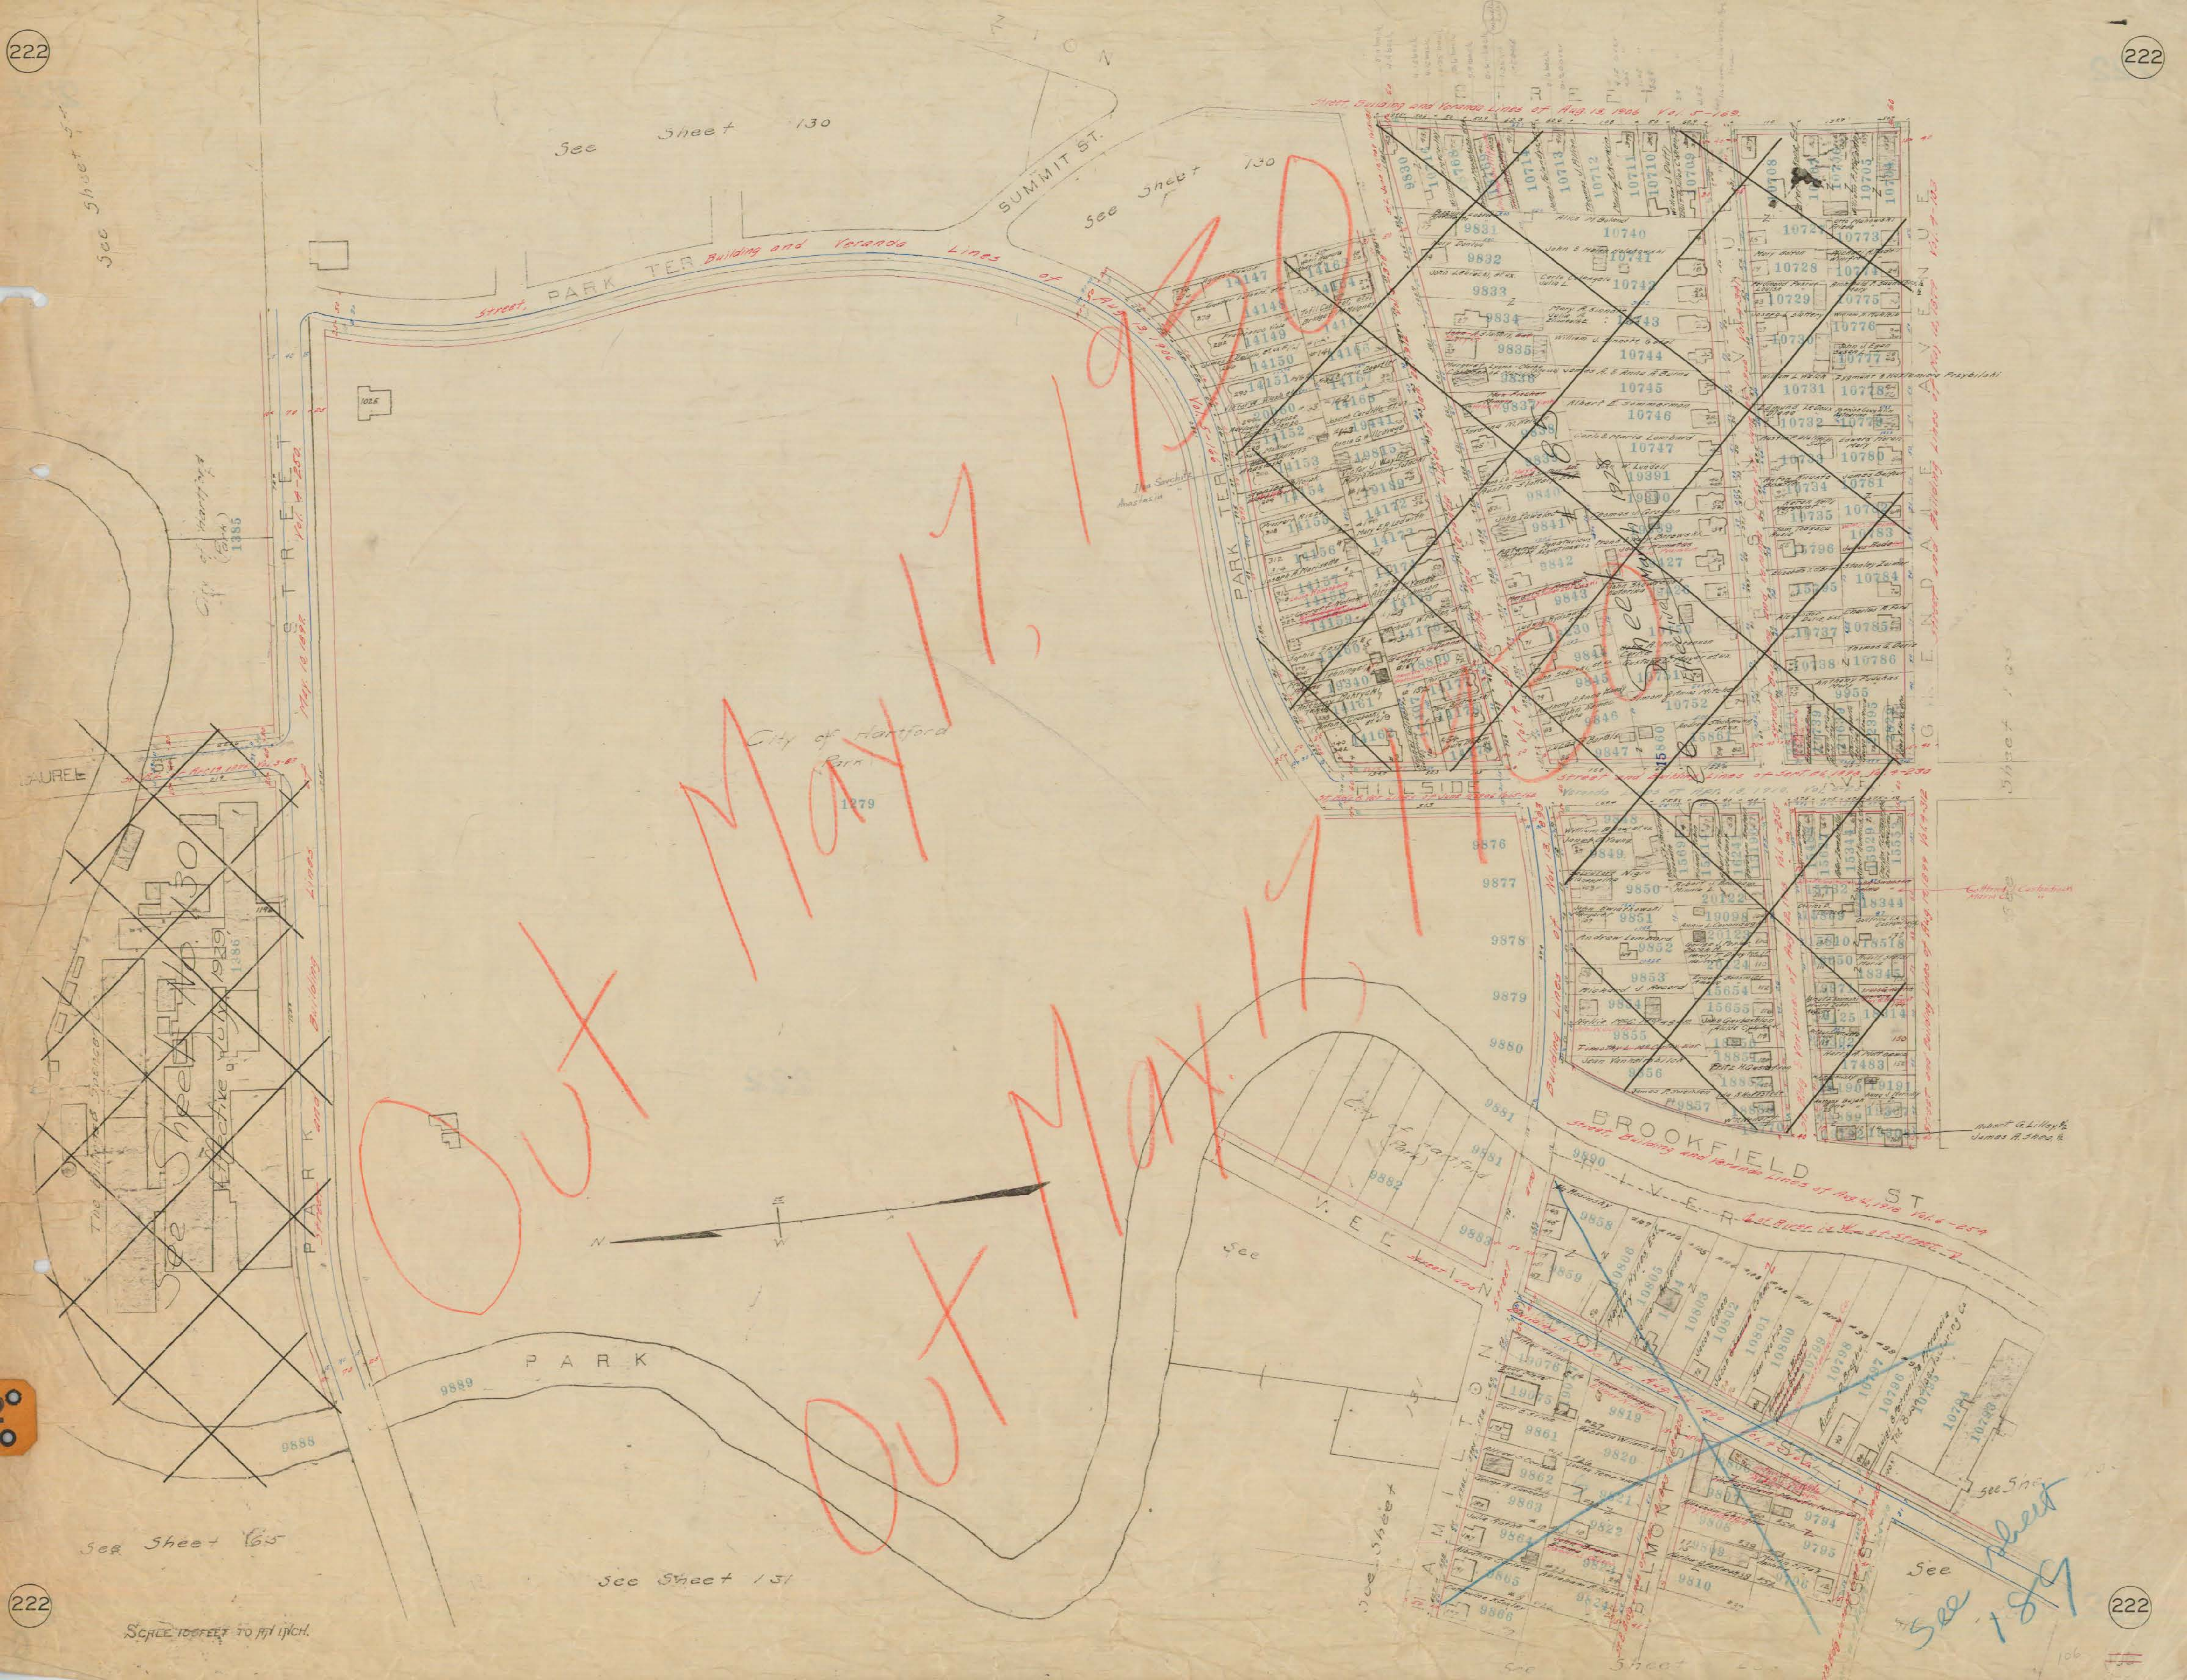

See Sheet 130

See Sheet 130

See Sheet 135

See Sheet 131

See Sheet 139

Scale 100 feet to 1 inch