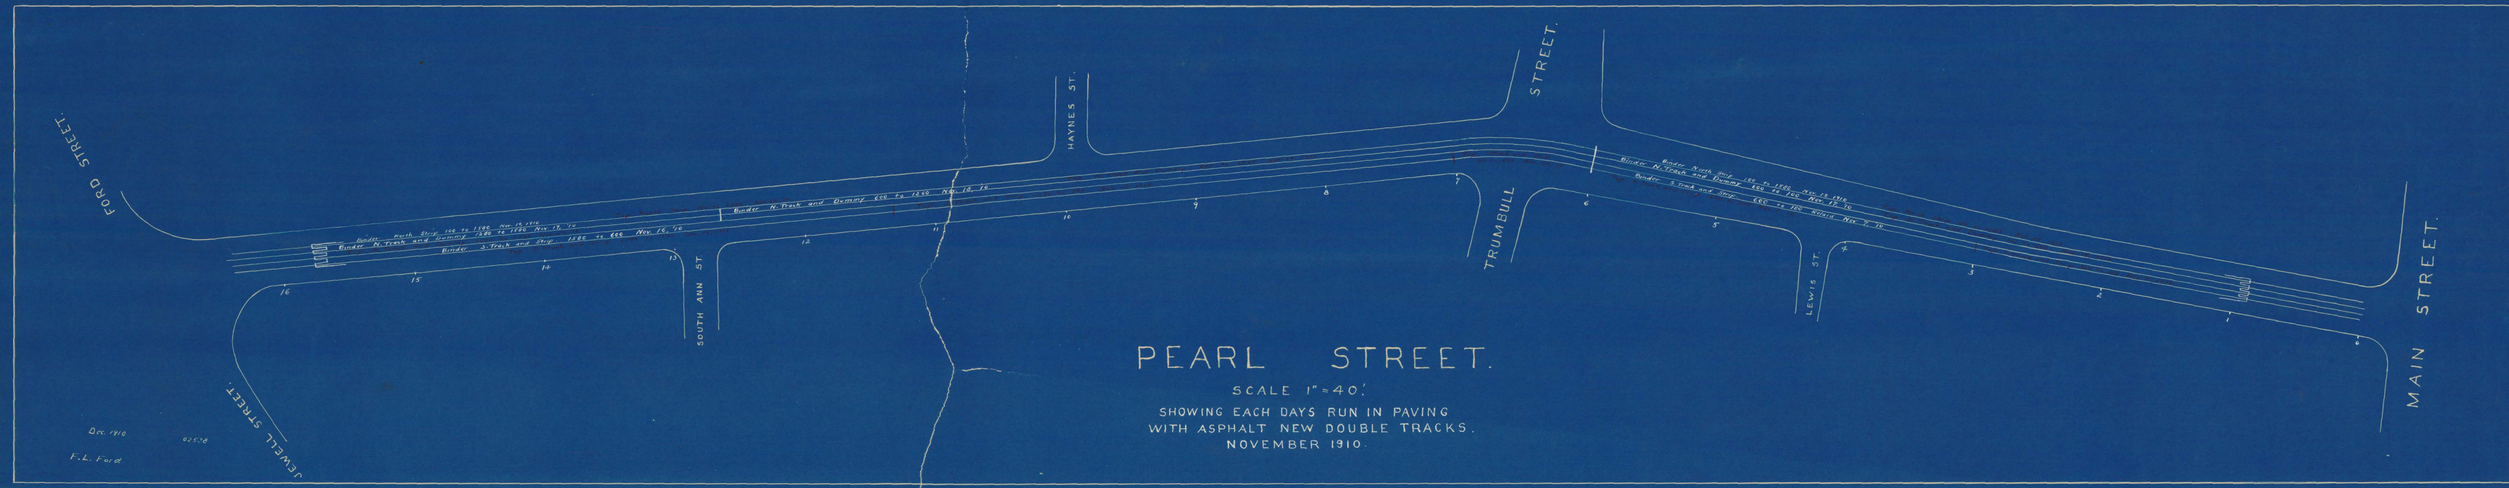

PEARL STREET.

SCALE 1" = 40'.

SHOWING EACH DAYS RUN IN PAVING
WITH ASPHALT NEW DOUBLE TRACKS.
NOVEMBER 1910.