


MAIN STREET WINDSOR STREET TO TUNNEL SCALE 1" = 40'

SHOWING DAILY RUN IN ASPHALT RESURFACING
AUGUST-OCTOBER 1911.
MAY-JUNE 1912.

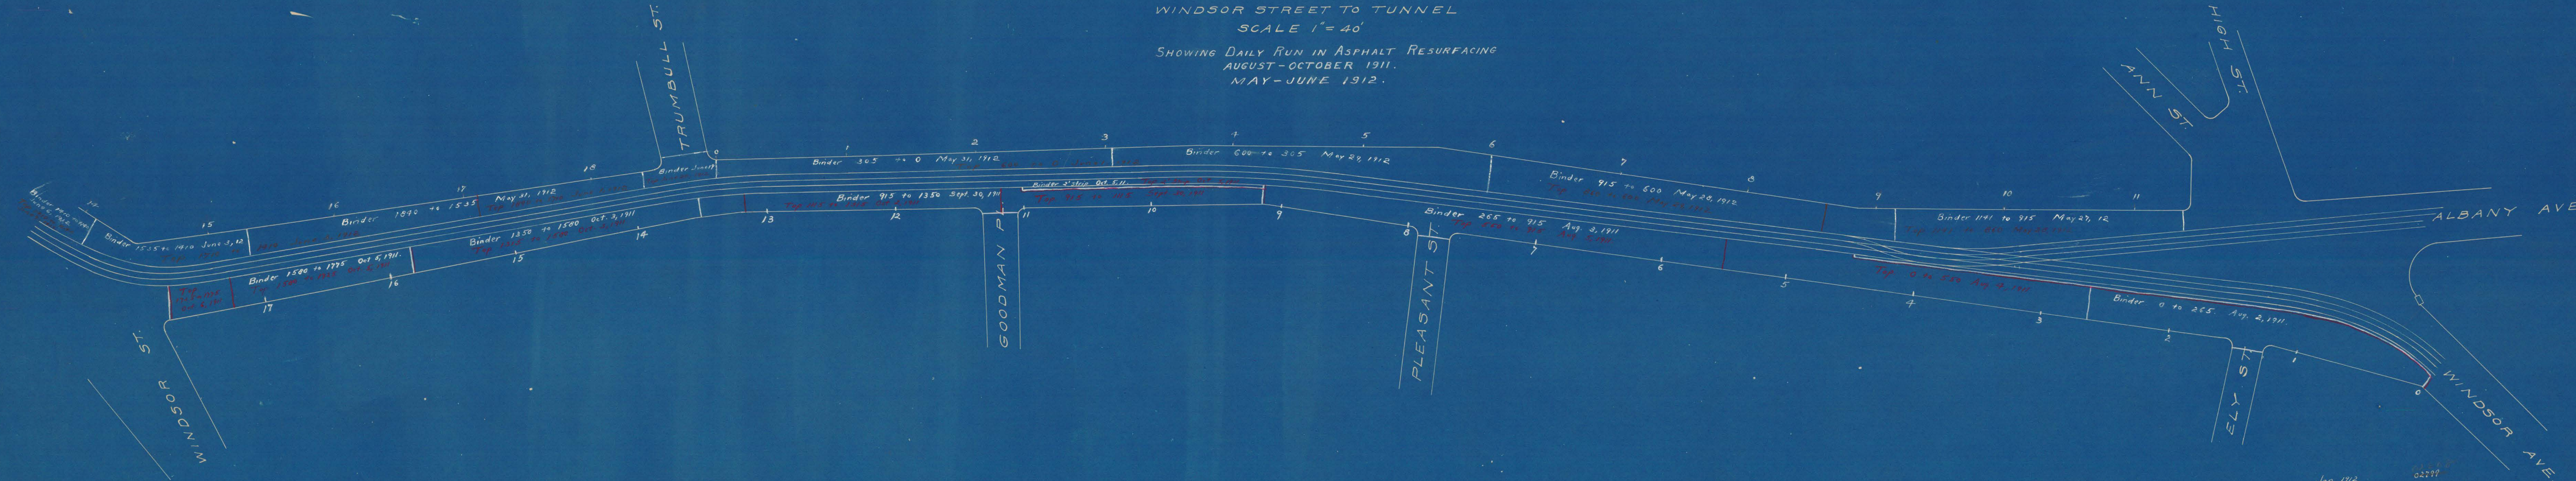

Jan. 1912

R. N. Clark

027??