


CAPITOL AVENUE.

BROAD STREET TO PARK RIVER BRIDGE.

SCALE 1"=40'.

SHOWING DAILY RUN IN ASPHALT PAVING.
JUNE-JULY 1911.

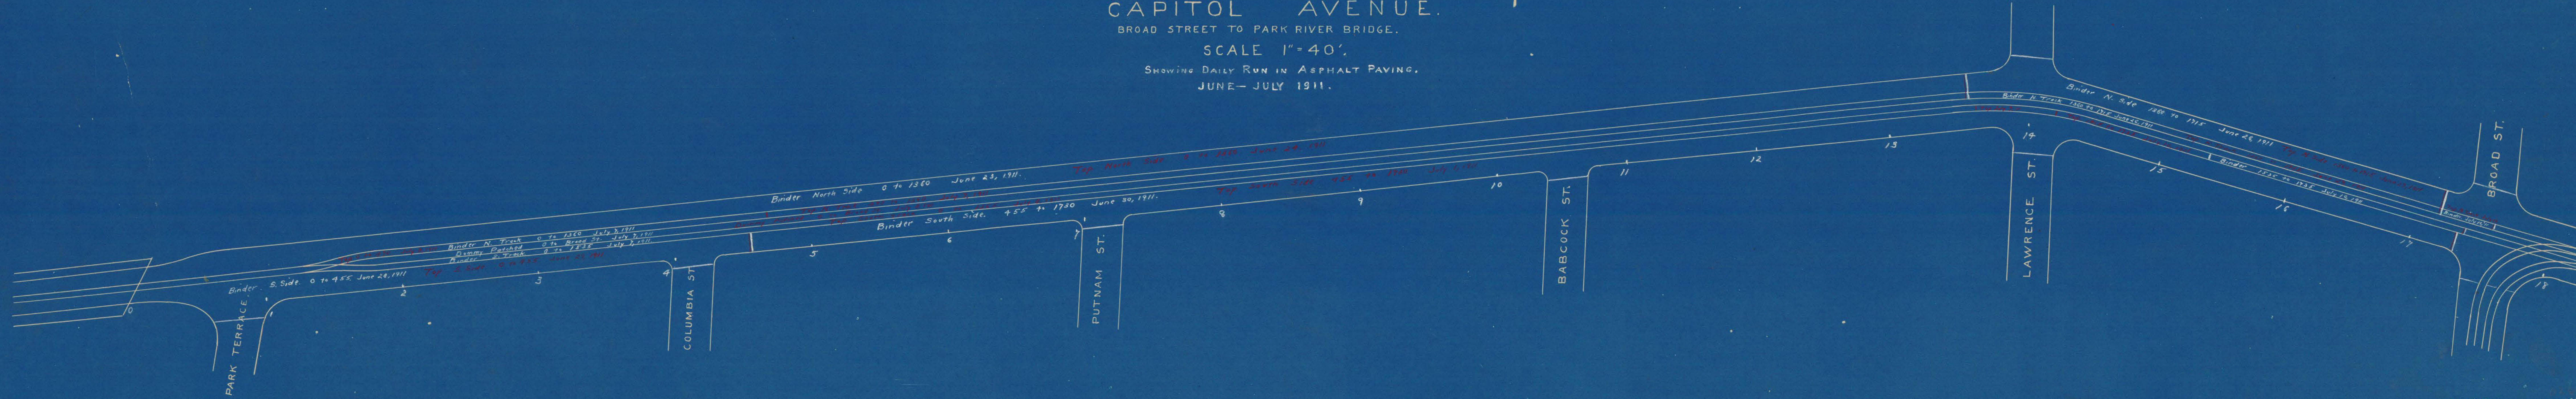

Jan 1912

R.N. Clark

54
522

223
45