


MAIN STREET

SCALE 1"=40'

SHOWING DAILY RUN IN ASPHALT RESURFACING.
JUNE - NOVEMBER 1912.

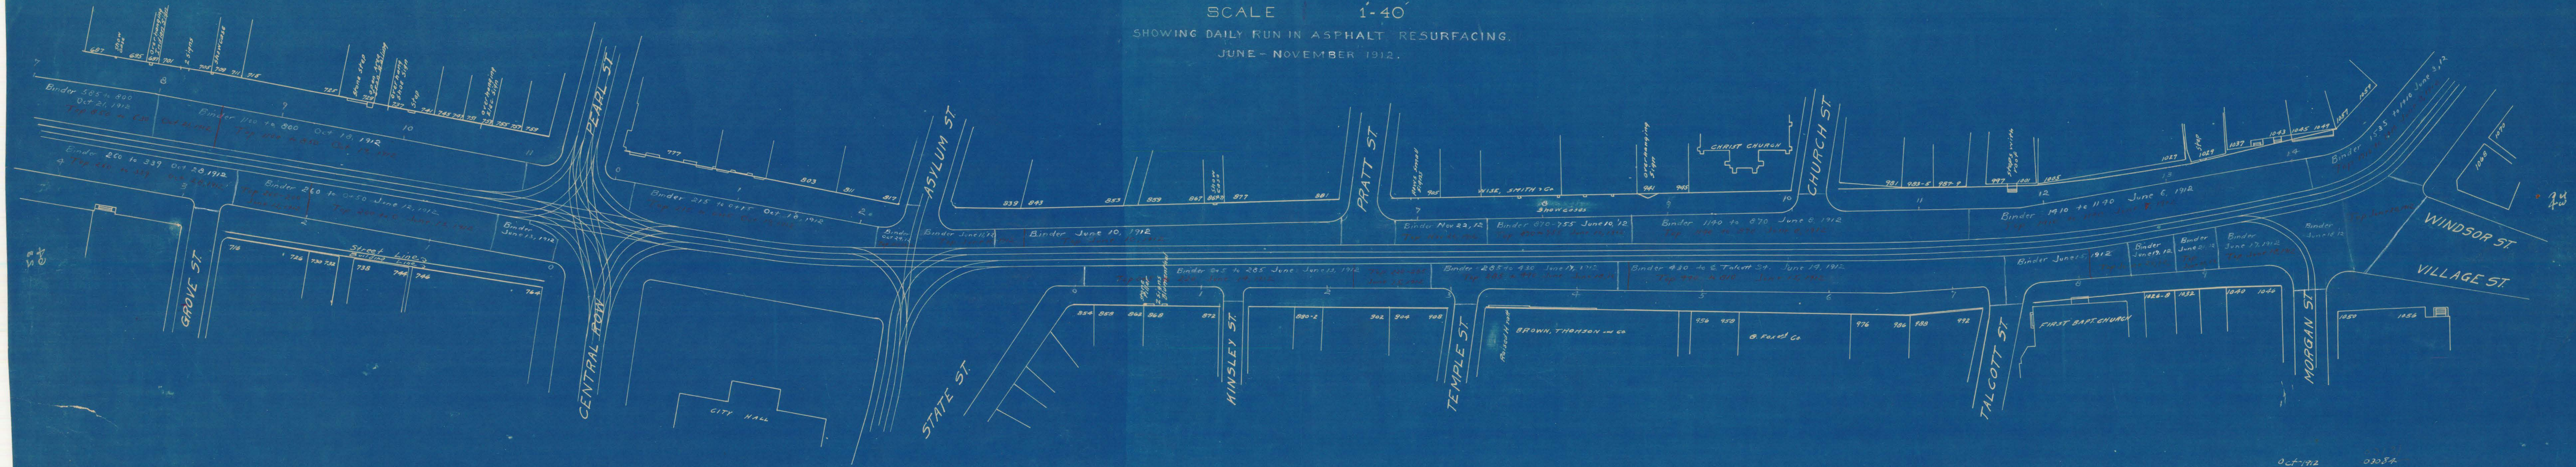

Oct 1912 030.54