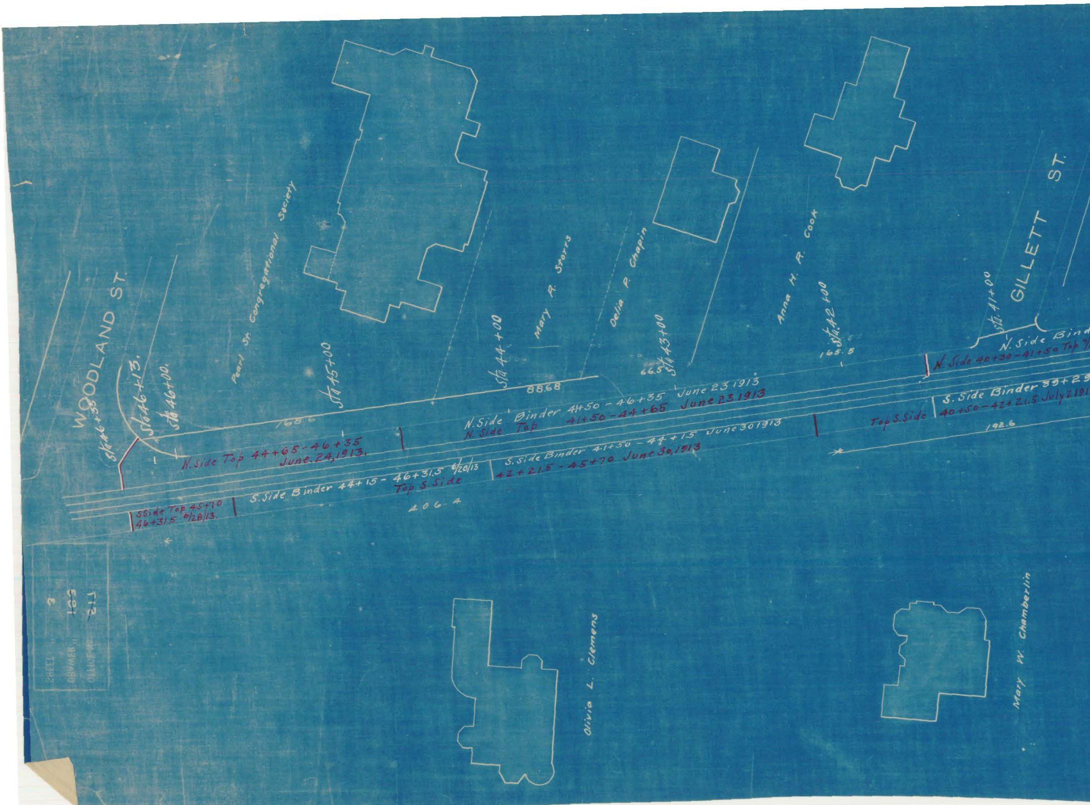
WOODLAND ST.
GILLETT ST.
Pearl St. Congregational Society
Mary R. Storrs
Delia P. Chapin
Anna H. R. Cook
Olivia L. Clemens
Mary W. Chamberlin
Sta 46+35
Sta 46+13.
Sta 46+00.
Sta 45+00
Sta 44+00
Sta 43+00
Sta 42+00
Sta. 41+00
168.6
88.68
66.5
165.5
406.4
192.6
N. Side Top 44+65 - 46+35 June. 24, 1913.
N. Side Binder 41+50 - 46+35 June 23 1913
N. Side Top 41+50 - 44+65 June 23 1913
S. Side Binder 44+15 - 46+31.5 6/20/13
Top S. Side
SSide Top 45+70 46+31.5 6/28/13.
S. Side Binder 41+50 - 44+15 June 30 1913
42+21.5 - 45+70 June 30, 1913
N. Side Bind
N. Side 40+30 - 41+50 Top 7/
Top S. Side
S. Side Binder 39+29
40+50 - 42+21.5 July 2 191

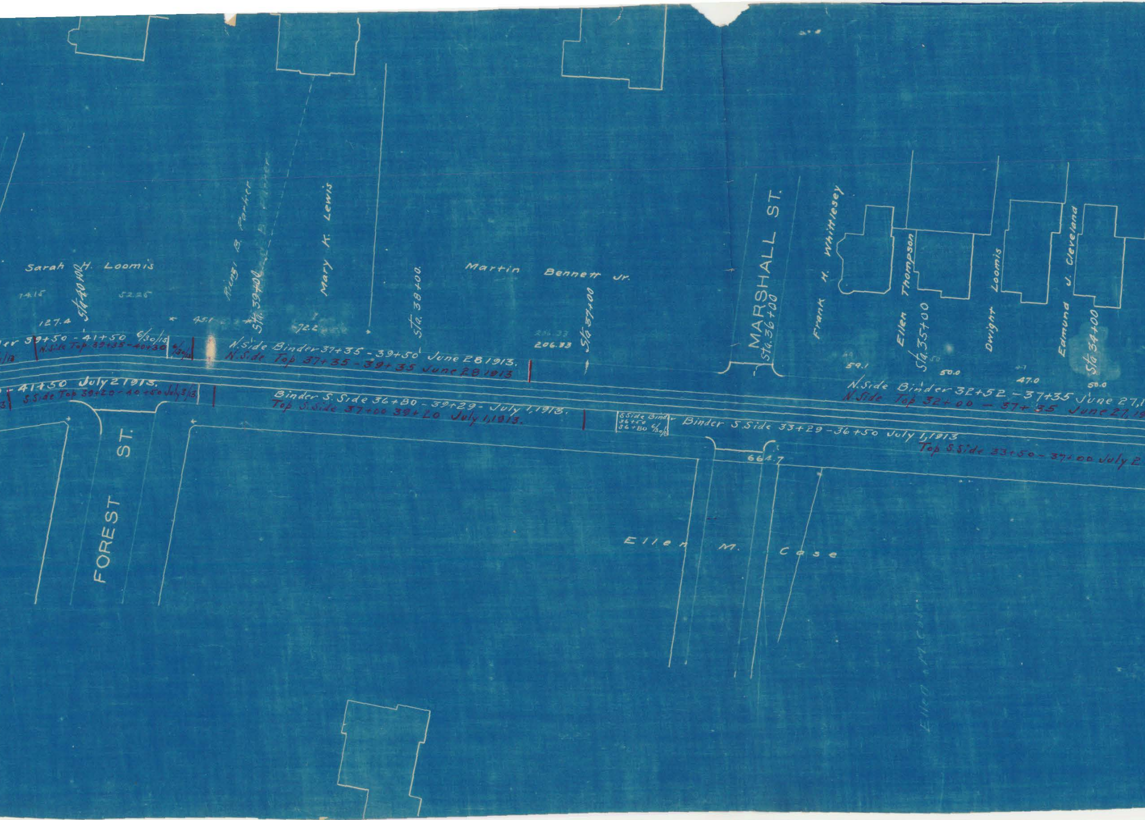
Sarah H. Loomis
74.15
52.25
127.4
Sta 40+00
45.1
Riengi B. Parker
Sta. 39+00
Mary K. Lewis
72.2
Sta. 38+00.
Martin Bennett Jr.
206.33
Sta 37+00
MARSHALL ST.
Sta. 36+00
Frank H. Whittlesey
Ellen Thompson
Sta. 35+00
Dwight Loomis
Edmund J. Cleveland
Sta 34+00
59.1
50.0
47.0
50.0
er 39+50 - 41+50 6/30/13
N. Side Top 39+35 - 40+30
6/30/13
/13
N. Side Binder 37+35 - 39+50 June 28 1913.
N. Side Top 37+35 - 39+35 June 28 1913
N. Side Binder 32+52 - 37+35 June 27,1
N. Side Top 32+00 - 37+35 June 27,19
+41+50 July 2 1913.
3
S. Side Top 39+20 - 40+50 July 3/13
Binder S. Side 36+80 - 39+29 - July 1,1913.
Top S. Side 37+00 39+20 July 1,1913.
S Side Binder 36+50 36+80 6/30/13
Binder S. Side 33+29 - 36+50 July 1,1913
Top S. Side 33+50 - 37+00 July 2
664.7
FOREST ST.
Ellen M. Case

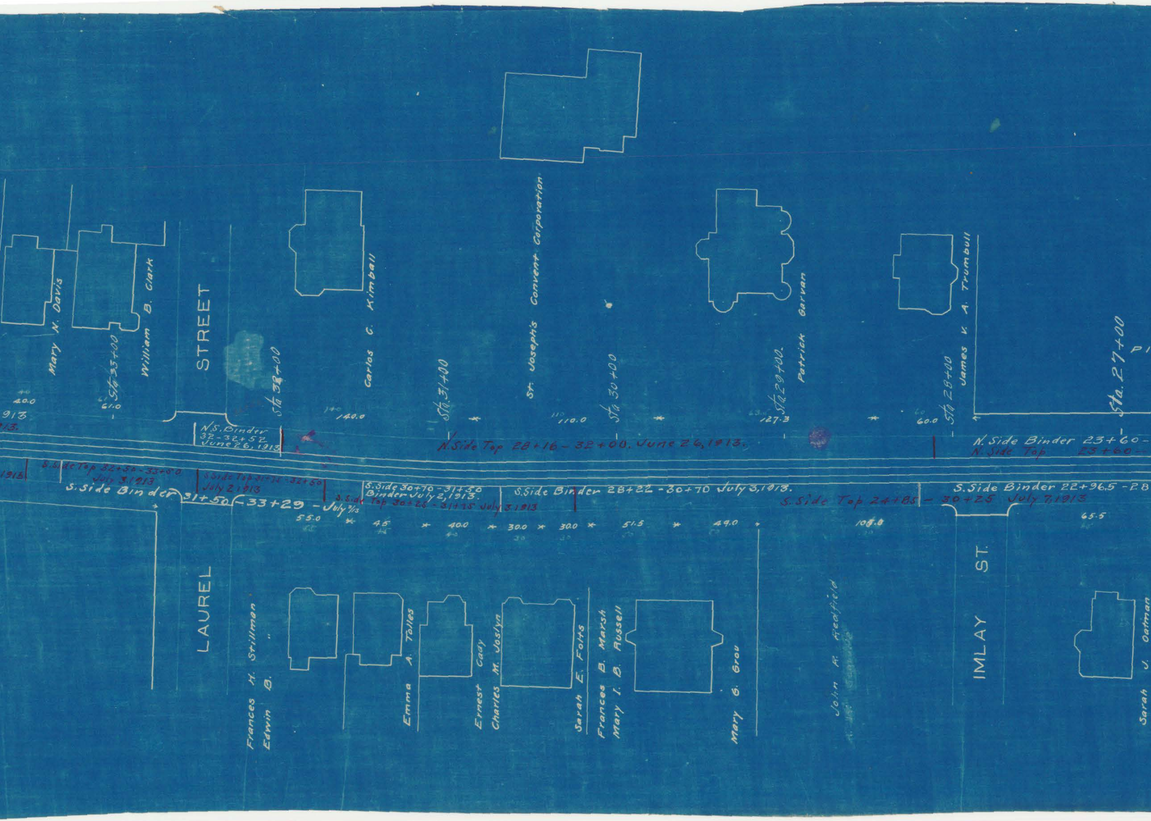
Mary N. Davis
Sta 33+00
William B. Clark
STREET
Sta 32+00
Carlos C. Kimball
Sta 31+00
St. Joseph's Convent Corporation
Sta 30+00
Sta 29+00
Patrick Garvan
Sta 28+00
James V. A. Trumbull
Sta. 27+00
P
40.0
61.0
140.0
110.0
127.3
60.0
913
13.
N.S. Binder
32 - 32+52
June 26, 1913
N. Side Top 28+16 - 32+00. June 26, 1913.
N. Side Binder 23+60 -
N. Side Top 23+60 -
1913
S. Side Top 32+50 - 33+00
July 3, 1913
S. Side Top 31+75 - 32+50
July 2 1913
S. Side Binder 31+50 - 33+29 - July 2/13
S. Side 30+70 - 31+50
Binder July 2, 1913.
S. Side Top 30+25 - 31+75 July 3 1913
S. Side Binder 28+22 - 30+70 July 3, 1913.
S. Side Binder 22+96.5 - 28
S. Side Top 24+85 - 30+25 July 7, 1913
55.0
45
40.0
30.0
30.0
51.5
49.0
108.8
65.5
LAUREL
Frances H. Stillman
Edwin B. "
Emma A. Tolles
Ernest Cady
Charles M. Joslyn
Sarah E. Folts
Frances B. Marsh
Mary I. B. Russell
Mary G. Grou
John R. Redfield
IMLAY ST.
Sarah J. Oatman

# FARMINGTON AVENUE
## ASYLUM ST. TO WOODLAND ST.
SCALE-1"=40'

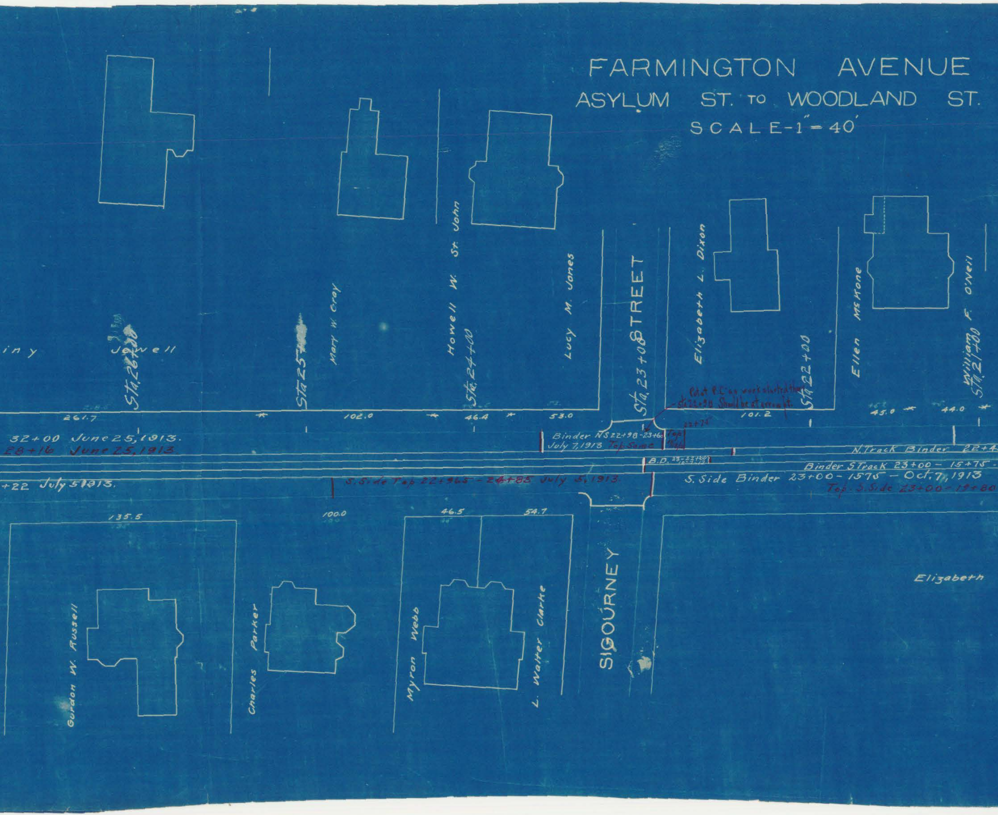

iny
Jewell
Sta. 26+00
Sta 25
Mary W Gray
Howell W. St. John
Sta. 24+00
Lucy M. Jones
STREET
Sta. 23+00
Elizabeth L. Dixon
Sta 22+00
Ellen McKone
William F. O'Neil
Sta. 21+00
261.7
102.0
46.4
53.0
101.2
45.0
44.0
Cut at P.C. as work started there Sta 22+90 Should be at arrow pt.
22+75
32+00 June 25, 1913.
28+16 June 25, 1913
Binder NS 22+98-23+60 July 7, 1913 Top Same
Top
N. Track Binder 22+4
B.D. 23-22+60 10-7-13
Binder S Track 23+00 - 15+75 -
+22 July 5 1913.
S. Side Top 22+965 - ~~24~~+85 July 5, 1913.
S. Side Binder 23+00 - 1575 - Oct. 7, 1913
Top - S. Side 23+00 - 19+80
135.5
100.0
46.5
54.7
Gordon W. Russell
Charles Parker
Myron Webb
L. Walter Clarke
SIGOURNEY
Elizabeth

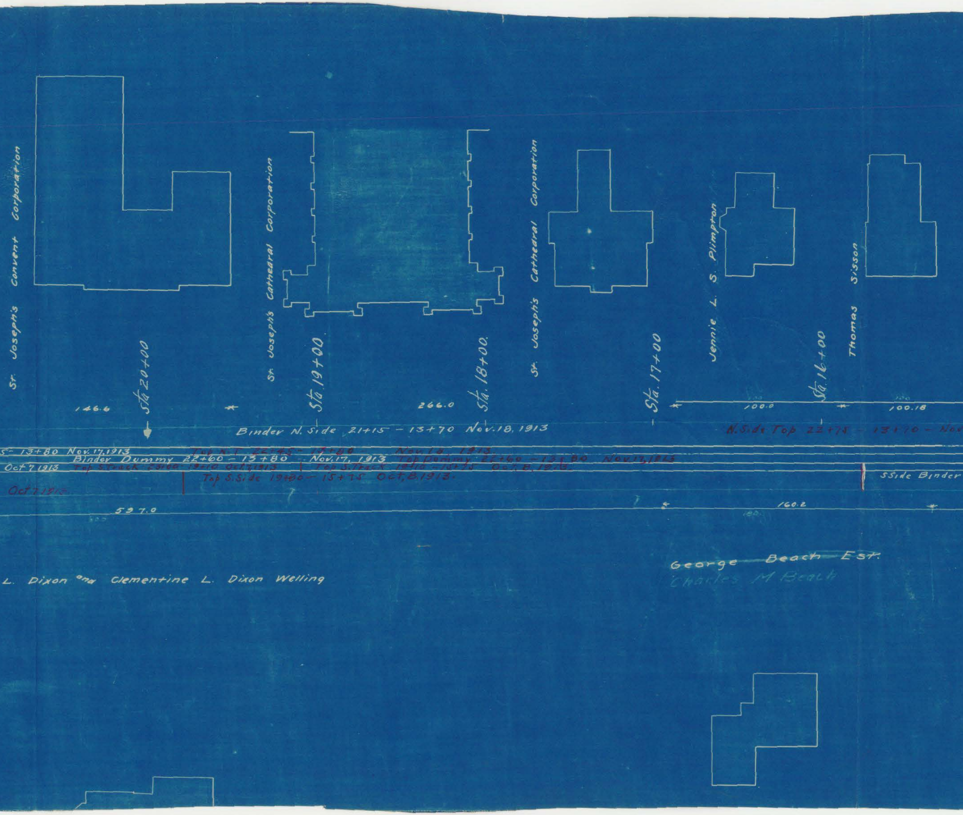
St. Joseph's Convent Corporation
St. Joseph's Cathedral Corporation
St. Joseph's Cathedral Corporation
Jennie L. S. Plimpton
Thomas Sisson
Sta 20+00
Sta 19+00
Sta. 18+00.
Sta. 17+00
Sta. 16+00
146.6
266.0
100.0
100.18
Binder N. Side 21+15 - 13+70 Nov. 18, 1913
N. Side Top 22+75 - 13+70 - Nov
5- 13+80 Nov. 17, 1913
Top N.T 22+45 - 17+80 - Nov 18, 1913.
Binder Dummy 22+60 - 13+80 - Nov. 17, 1913
Top Dummy 22+60 - 13+80 Nov 17, 1913
Oct 7 1913
Top S. Track 23+00 - 19+10 Oct. 7, 1913
Top S. Track 19+10 - 15+75 Oct. 8, 1913.
Top S. Side 19+80 - 15+75 Oct, 8, 1913.
Oct 7 1913
S Side Binder
597.0
160.2
L. Dixon and Clementine L. Dixon Welling
George ~~Beach Est.~~
Charles M Beach

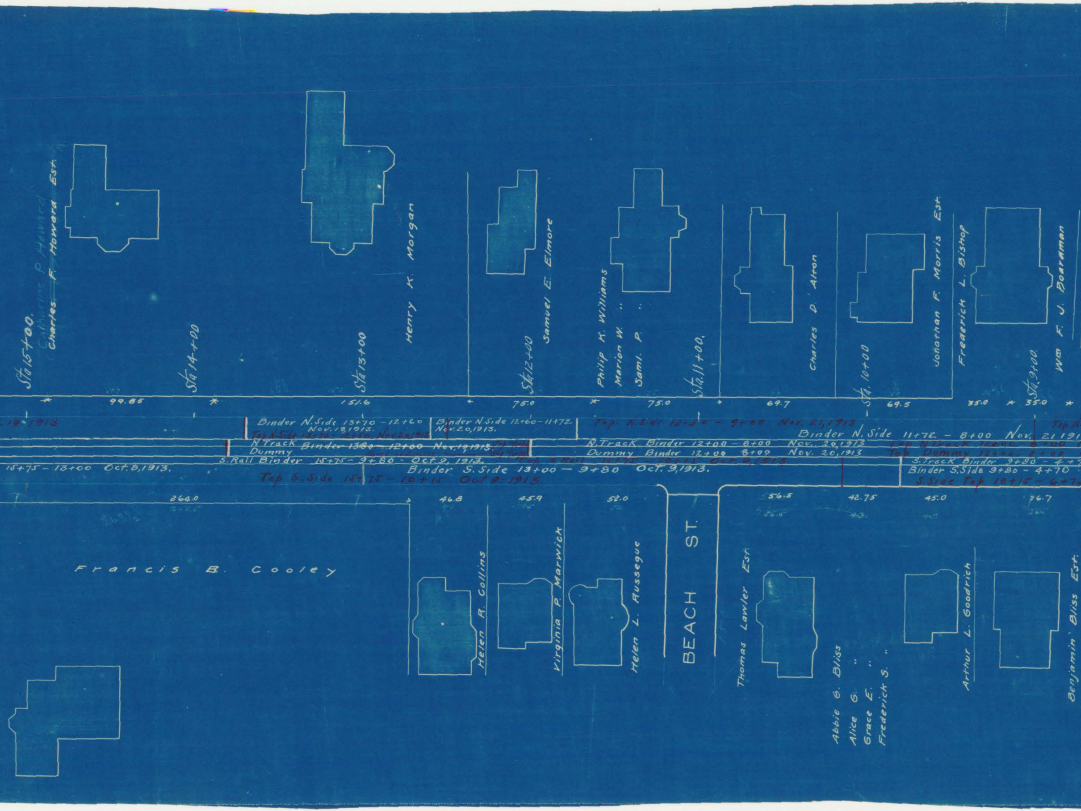
Sta 15+00.
Catharine P. Howard
Charles F. Howard Est.
Sta 14+00
Sta 13+00
Henry K. Morgan
Sta 12+00
Samuel E. Elmore
Philip K. Williams
Marion W. "
Saml. P. "
Sta 11+00.
Charles D. Alton
Sta. 10+00
Jonathan F. Morris Est.
Frederick L. Bishop
Sta. 9+00
Wm F. J. Boardman
99.85
151.6
75.0
75.0
69.7
69.5
35.0
35.0
.19 1913
Binder N. Side 13+70 - 12+60 Nov. 19, 1913.
Top N. Side 13+70 - 12+50 Nov. 20, 1913
Binder N Side 12+60 - 11+72 Nov. 20, 1913.
Top N. Side 12+50 - 9+00 Nov. 21, 1913
Binder N. Side 11+72 - 8+00 Nov. 21 191
Top N
N Track
Dummy
Binder 13+80 - 12+00 Nov. 19, 1913
N. Track Binder 12+00 - 8+00 Nov. 20, 1913
Dummy Binder 12+00 8+00 Nov. 20, 1913
Top N Track 12+00 - 8+00
Top Dummy 12+00 - 8+00
S. Rail Binder 15+75 - 9+80 - Oct. 9, 1913.
Top S Rail - 15+75 - 10+15 Oct. 9, 1913
S. Track Binder 9+80 - 4+7
15+75 - 13+00 Oct. 8, 1913.
Binder S. Side 13+00 - 9+80 Oct. 9, 1913.
Binder S. Side 9+80 - 4+70
Top S. Side 15+75 - 10+15 Oct 9 - 1915.
S. Side Top 10+15 - 6+7
264.0
46.8
45.9
52.0
56.5
42.75
45.0
76.7
Francis B. Cooley
Helen R. Collins
Virginia P. Marwick
Helen L. Russegue
BEACH ST.
Thomas Lawler Est.
Abbie G. Bliss
Alice G. "
Grace E. "
Frederick S. "
Arthur L. Goodrich
Benjamin Bliss Est.

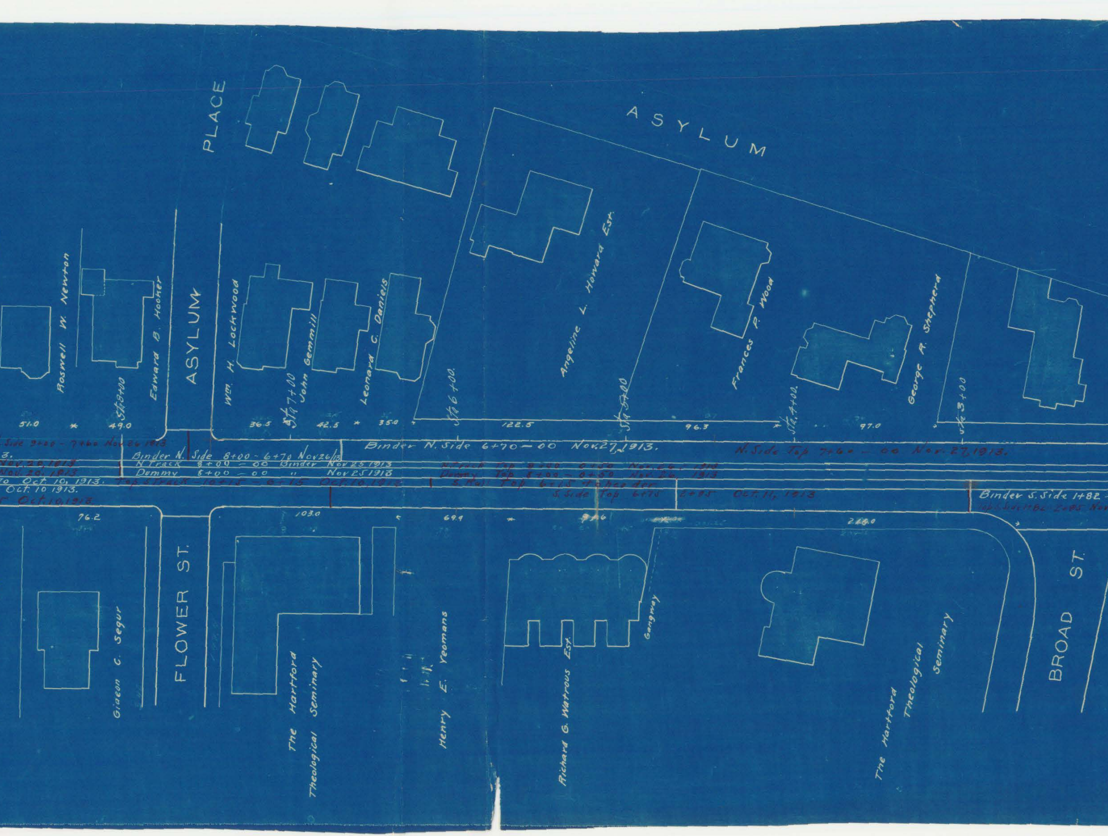
PLACE
ASYLUM
ASYLUM
Roswell W. Newton
Edward B. Hooker
Wm. H. Lockwood
John Gemmill
Leonard C. Daniels
Angeline L. Howard Est.
Frances P. Wood
George R. Shepherd
Sta 8+00
Sta 7+00
Sta 6+00
Sta 5+00
Sta 4+00
Sta 3+00
51.0
49.0
36.5
42.5
35.0
122.5
96.3
97.0
Side 9+00 - 7+60 Nov 26 1913
Binder N. Side 8+00 - 6+70 Nov26/13
N Track 8+00 - 00 Binder Nov 25 1913
Dummy 8+00 - 00 " Nov 25 1913
Binder N. Side 6+70 - 00 Nov. 27, 1913.
N. Side Top 7+60 - 00 Nov. 27, 1913.
3.
Nov. 20, 1913
Nov. 20, 1913
to Oct. 10, 1913.
Oct. 10 1913.
Oct. 10, 1913.
Top S Track - 10+15 - 6+15 Oct. 10, 1913
N Track Top 9+00 - 0+50 Nov. 26, 1913
Dummy Top 8+00 - 0+50 Nov. 26, 1913
S. Rail Top 6+15 to header
S. Side Top 6+75
2+85 Oct. 11, 1913
Binder S. Side 1+82 -
Top S. Side 1+82 2+85 Nov
76.2
103.0
69.4
91.6
248.0
FLOWER ST.
BROAD ST.
Gideon C. Segur
The Hartford Theological Seminary
Henry E. Yeomans
Richard G. Watrous Est.
Gangway
The Hartford Theological Seminary

Aug 26, 1899 0643

# Farmington Ave. and Asylum Hill.

Daily run of Asphalt 1913

Scale 1" = [illegible]

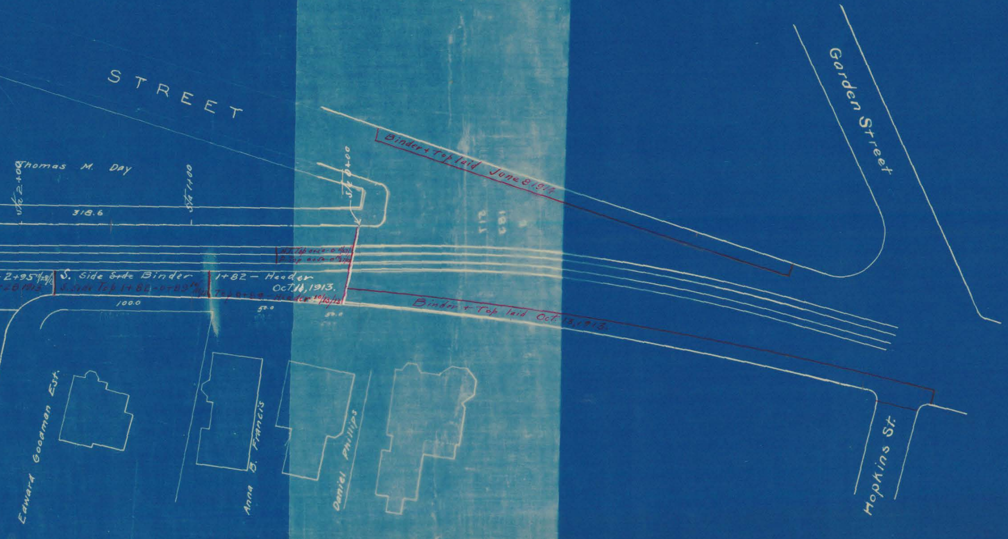
STREET
Thomas M. Day
Sta 2+00
Sta 1+00
Sta 0+00
318.6
Binder + Top laid June 8 1914
N.T. Top 0+50 – 0 11/27/13
P. Top 0+50 – 0 11/27/13
2+95 11/28/13
28 1913
S. Side ~~Side~~ Binder
S. Side Top 1+82 – 0+89 11/28/13
1+82 – Header
Oct. 11, 1913.
Top 0+89 – Header 10/13/13
100.0
50.0
50.0
Binder + Top laid Oct. 13, 1913.
Garden Street
Hopkins St.
Edward Goodman Est.
Anna B. Francis
Daniel Phillips

3
183