


10
e

TRINITY ST.

Scale 1" = 40'
PROGRESS MAP - PAVING.

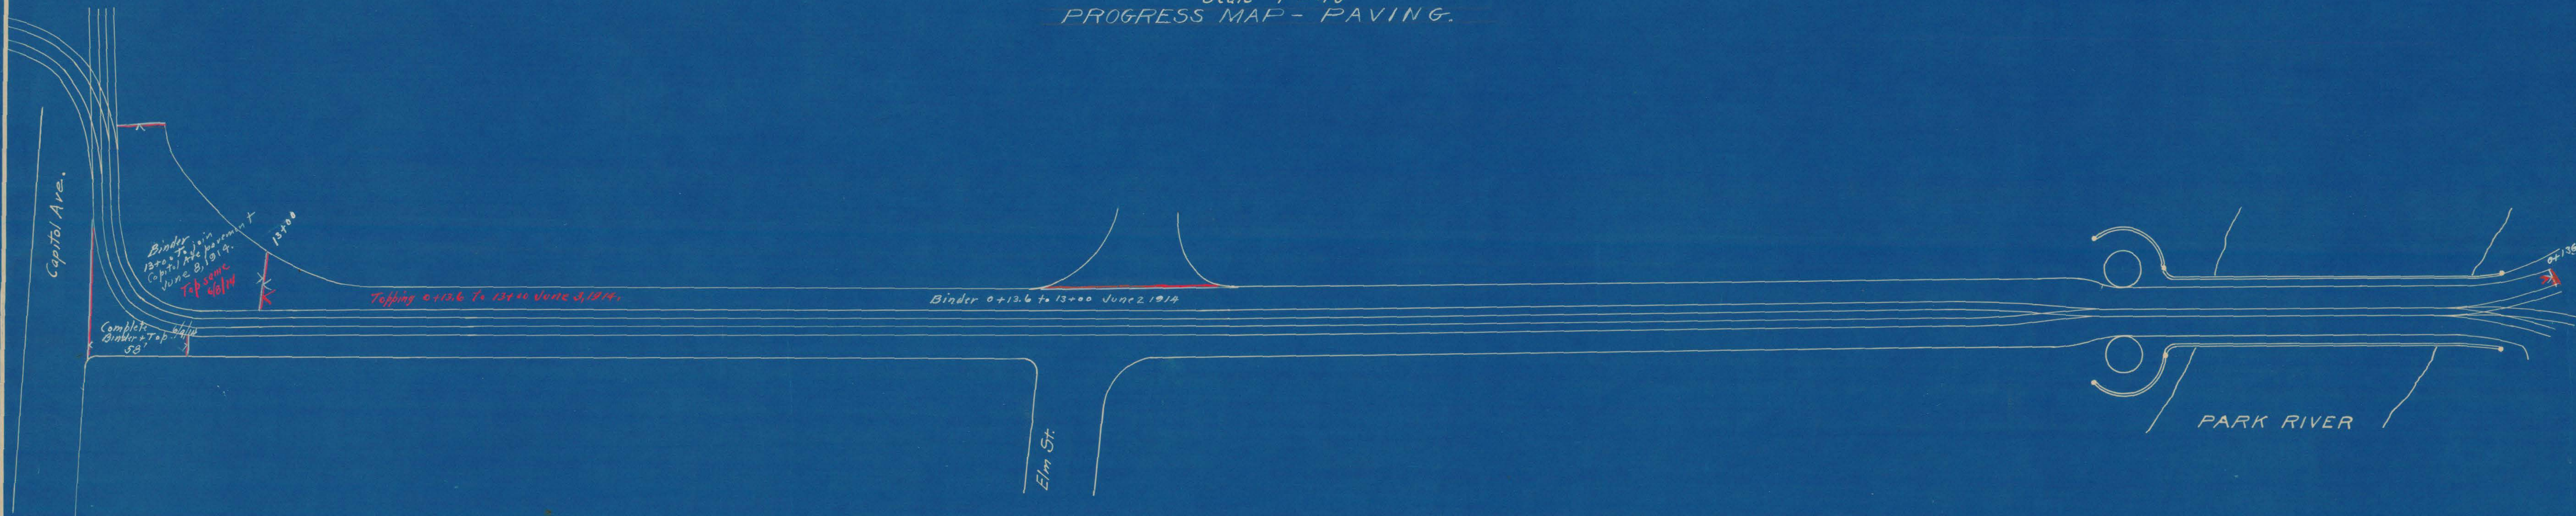

Jan. 1915

R.N. Clark

03643

10
e