



WASHINGTON STREET

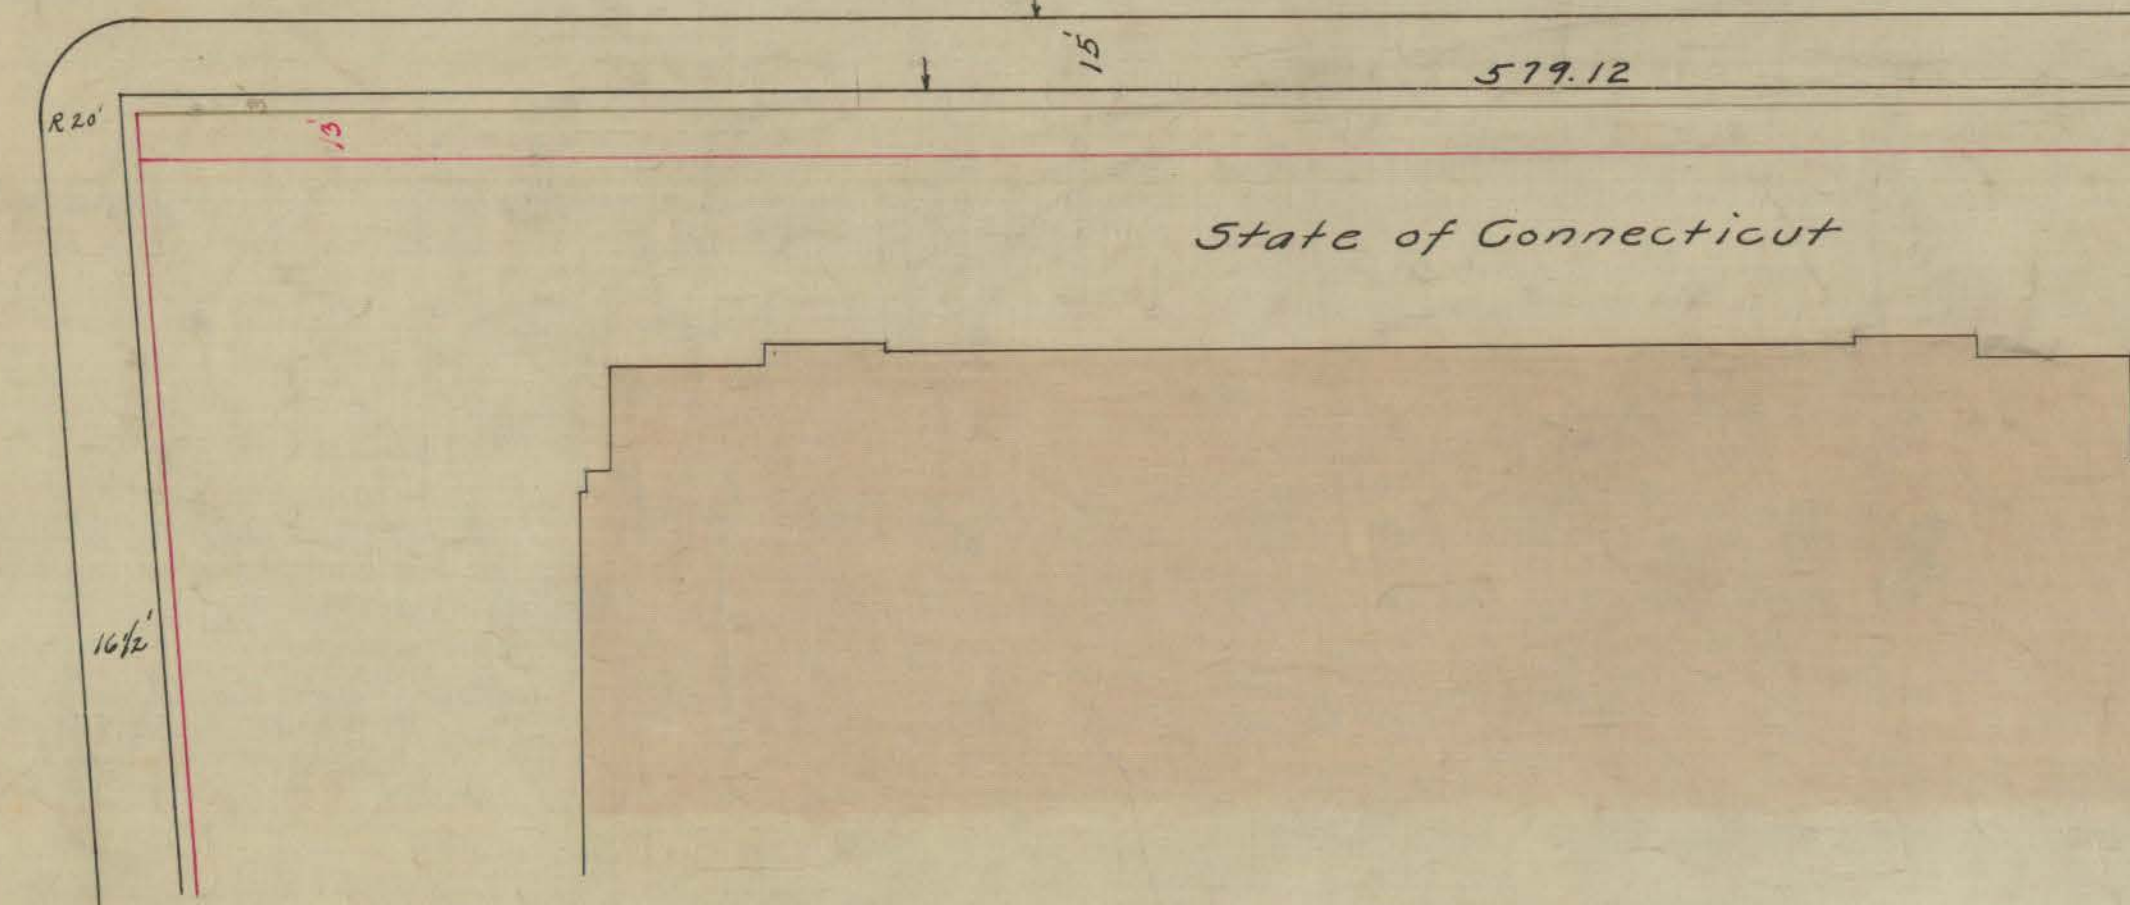


TRINITY STREET

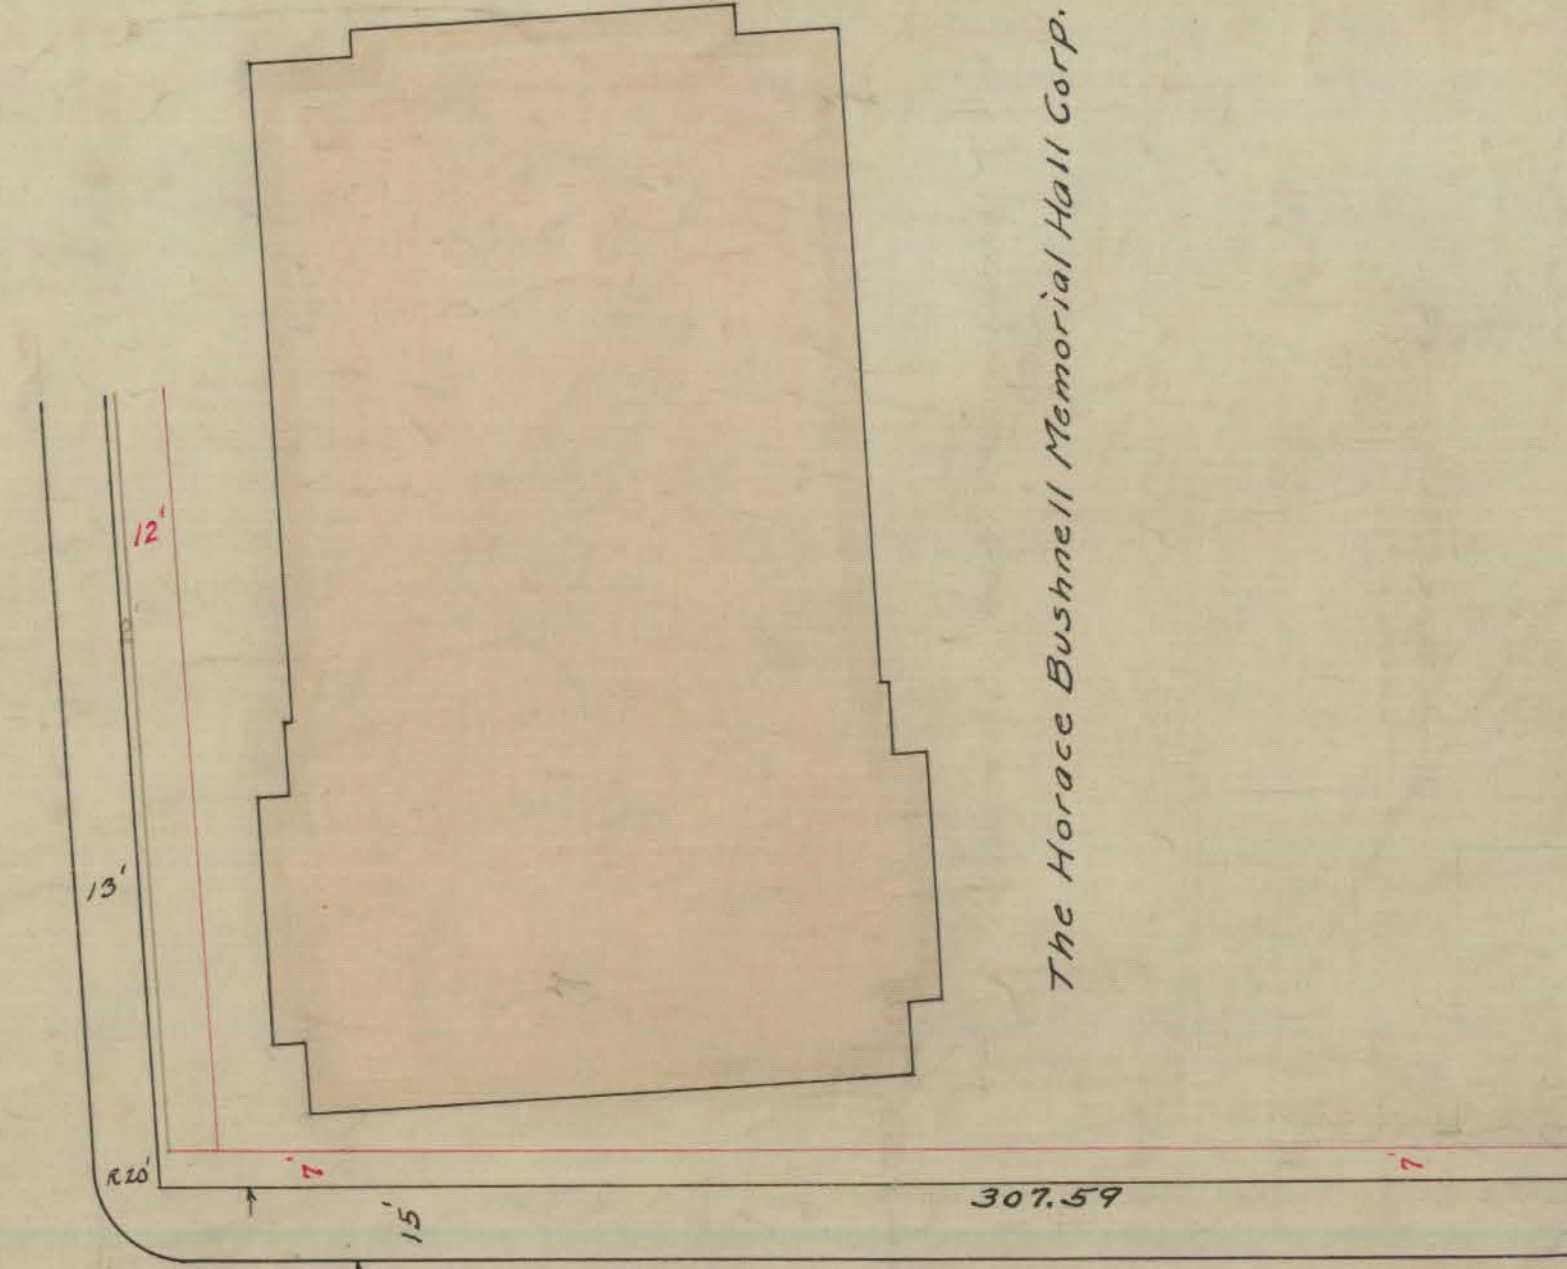

The Horace Bushnell Memorial Hall Corp.

CLINTON STREET

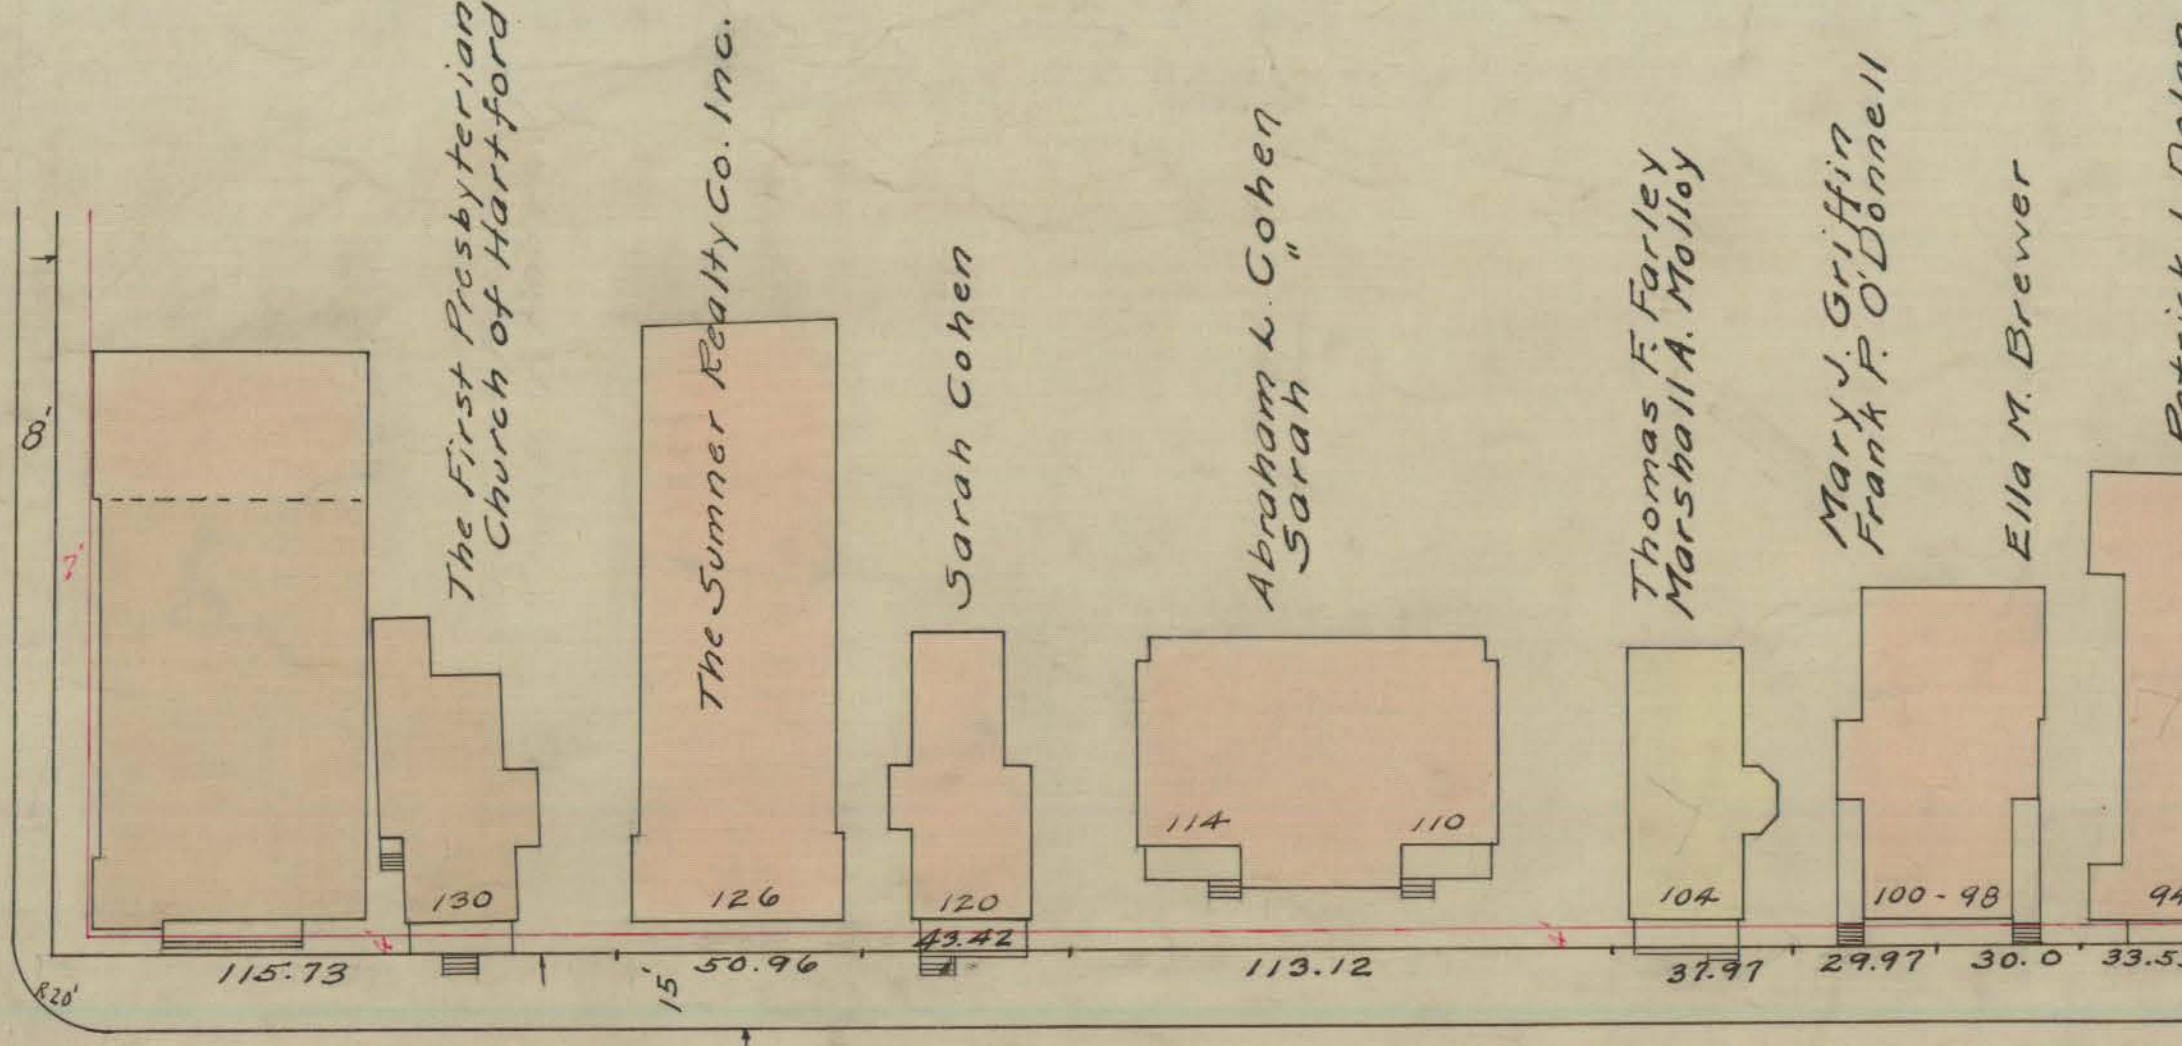

The First Presbyterian Church of Hartford

The Sumner Realty Co. Inc.

Sarah Cohen

Abraham L. Cohen Sarah

Thomas F. Farley Marshall A. Molloy

Mary J. Griffin Frank F. O'Donnell

Ella M. Brewer

Patrick J. Dolan


STREET



Louis Greenspon Harry

Connecticut General Life Insurance Co.

STREET

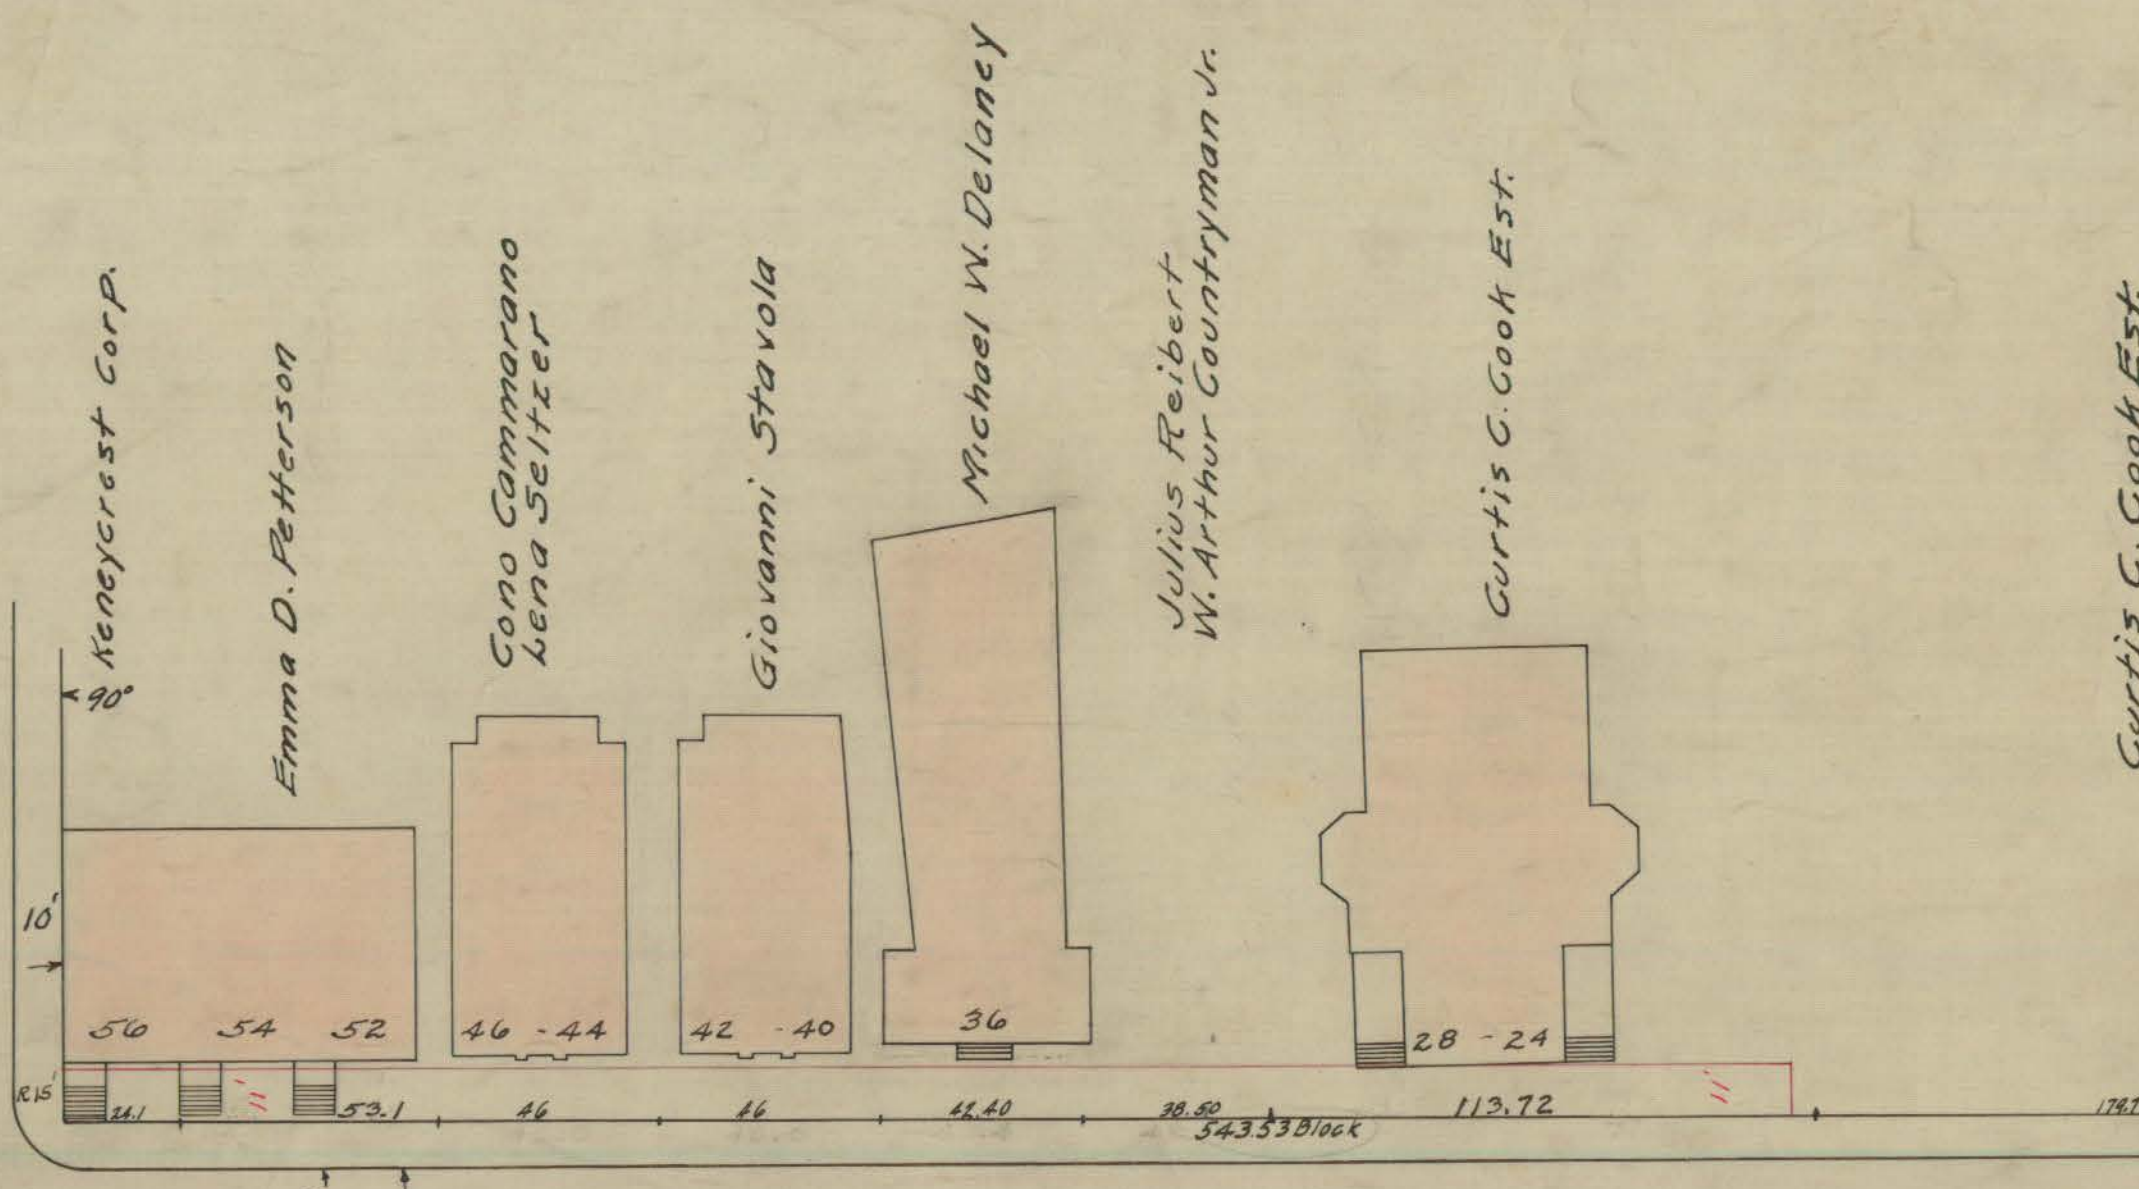

Emma D. Patterson

Cono Cammarano Lena Seltzer

Giovanni Stavola


Michael W. Delaney

Julius Reibert W. Arthur Countryman Jr.

Curtis C. Cook Est.


STREET

WASHINGTON STREET

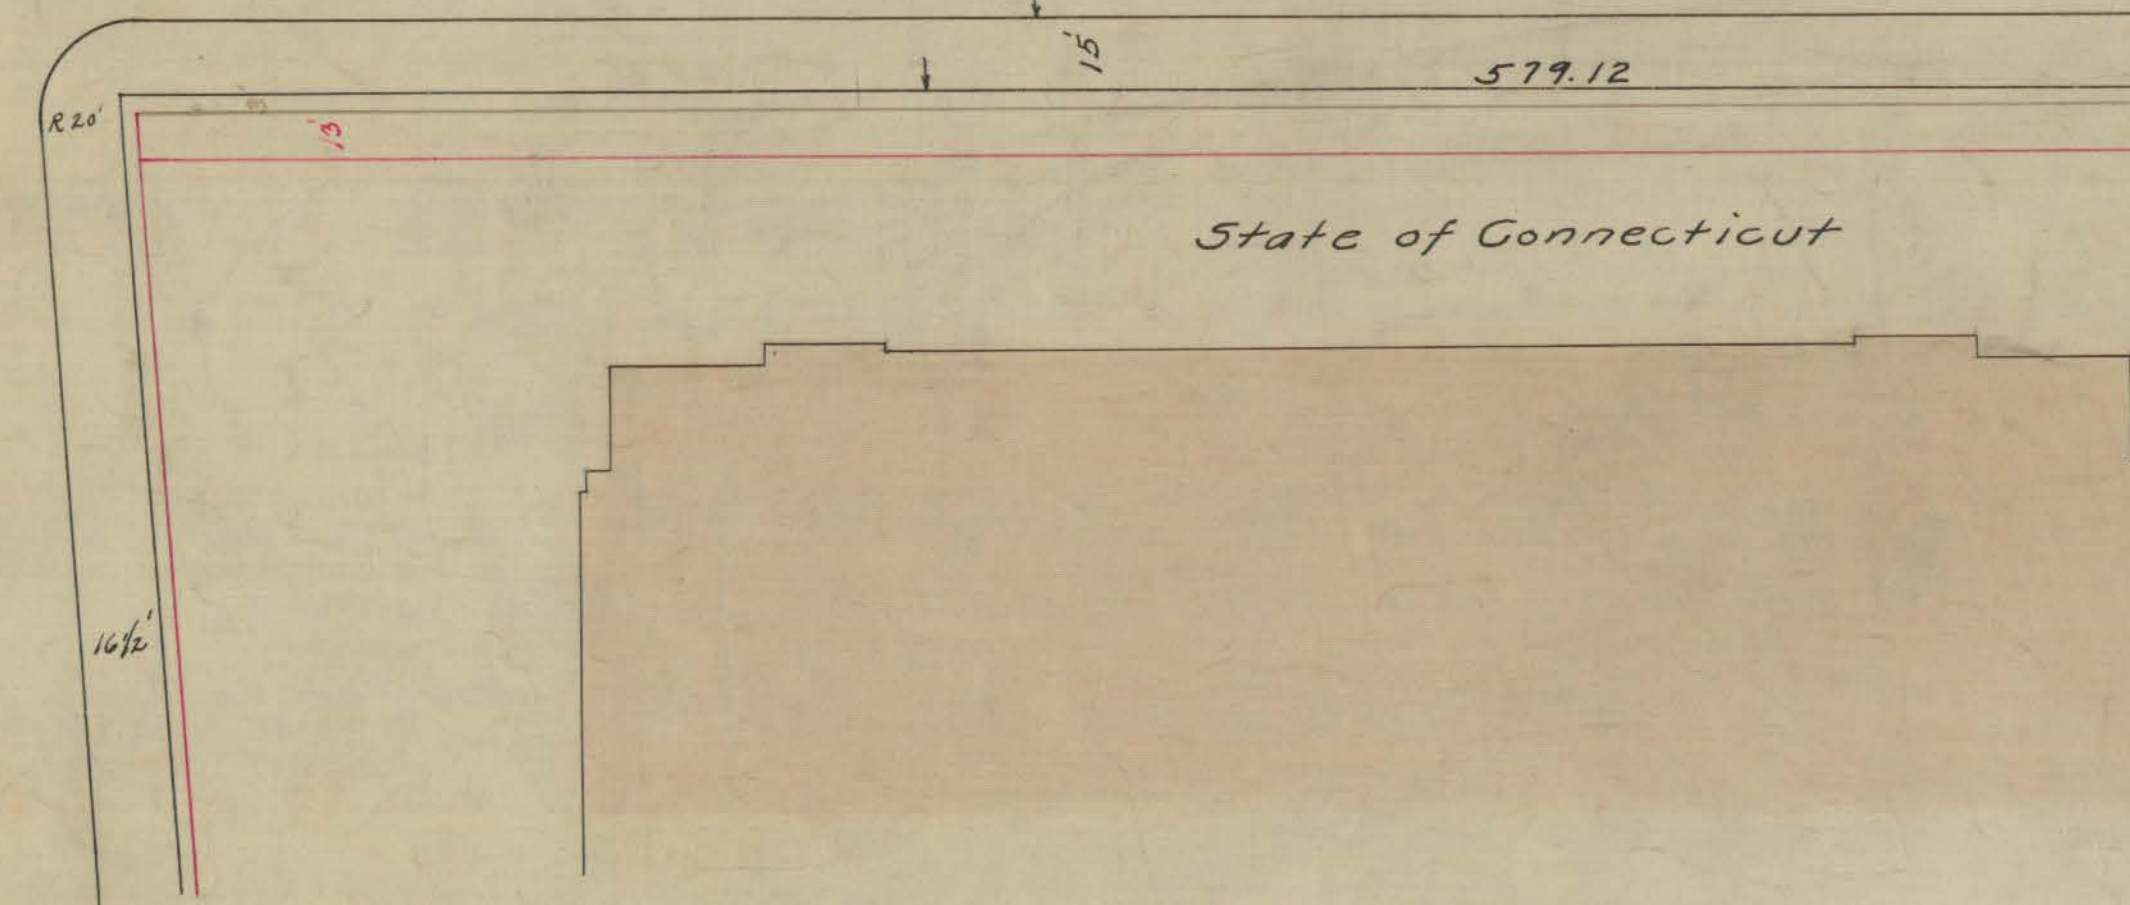

State of Connecticut

CLINTON STREET

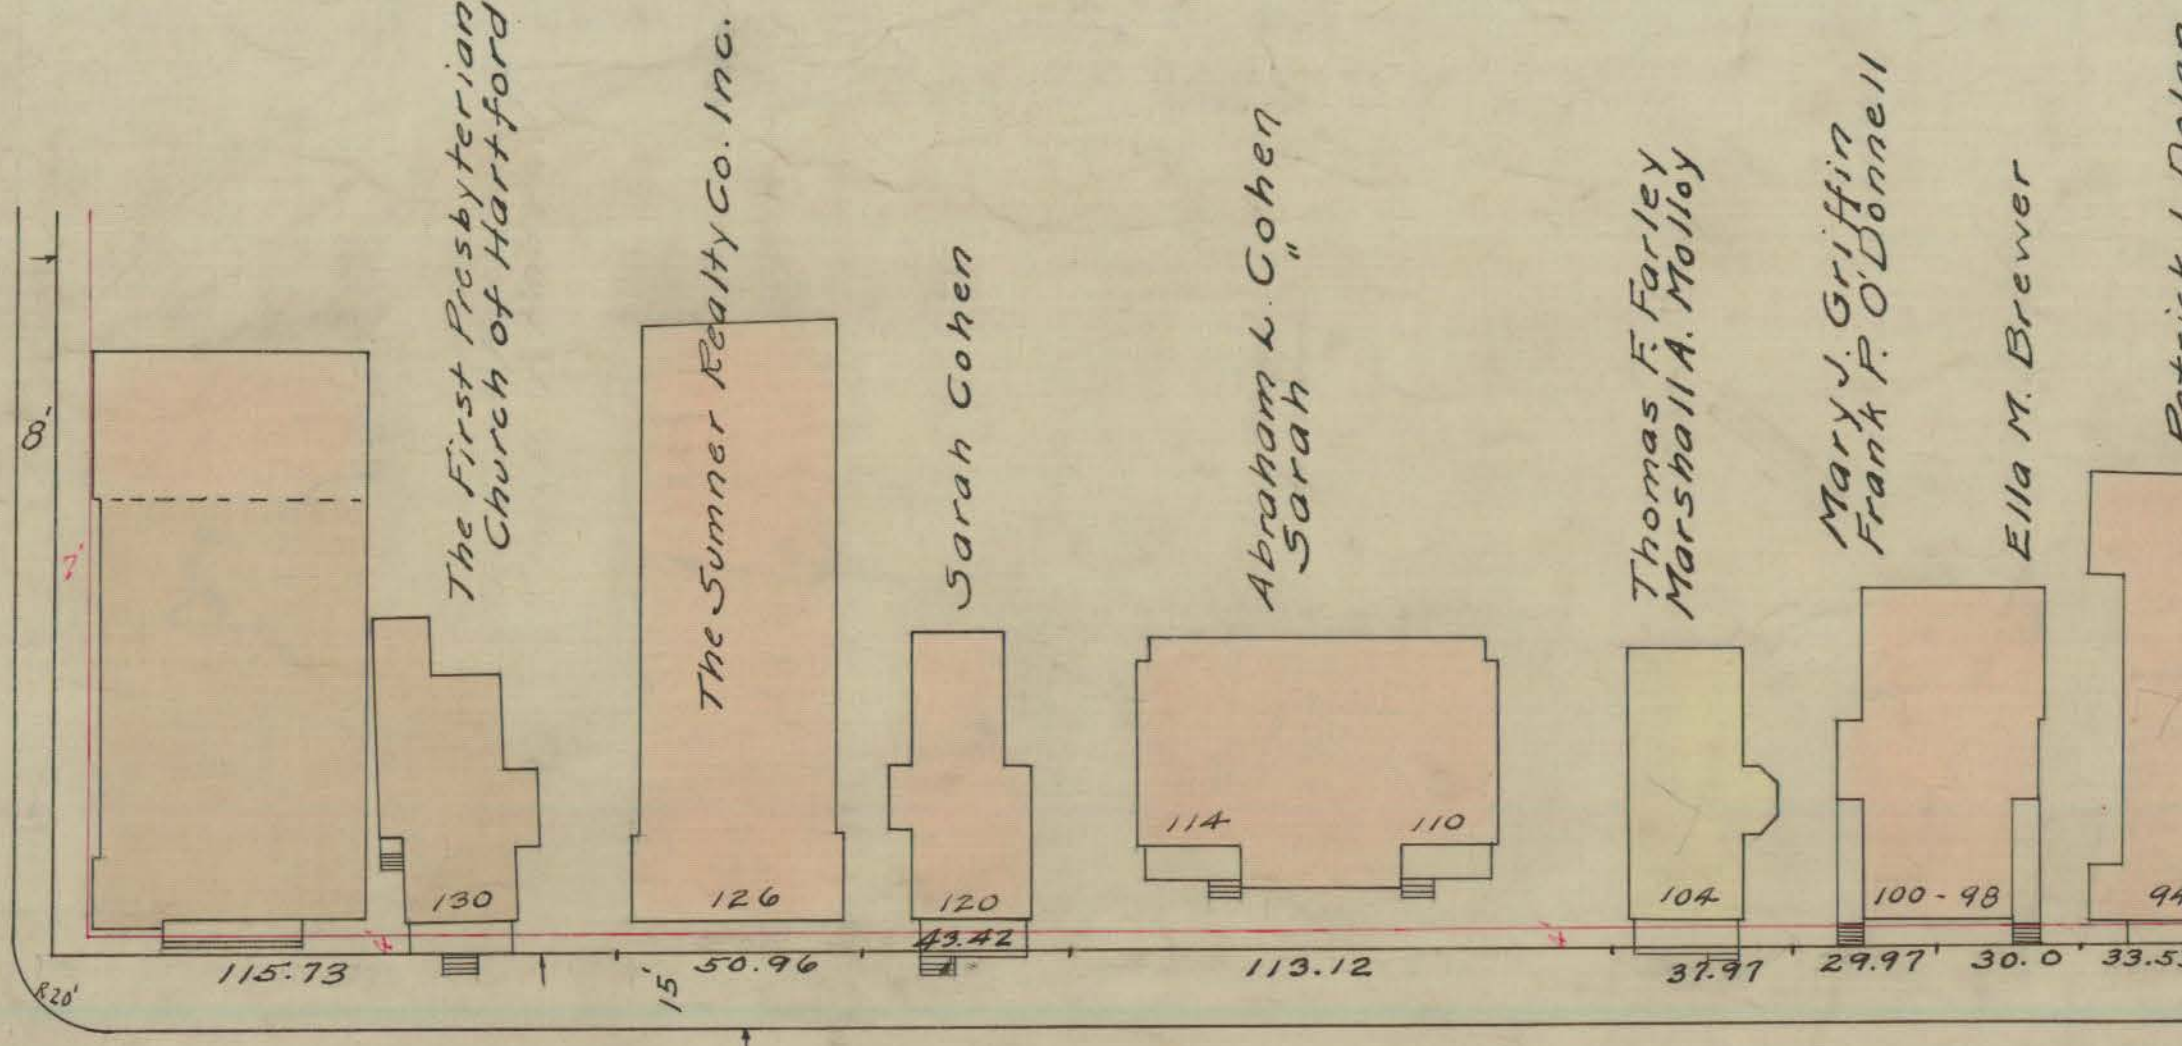

Marshall A. Molloy Thomas F. Farley


The Mount Sinai Hospital

Naaman Cohen

John J. Ahern

Bushnell Realty Co. Inc.

WEST

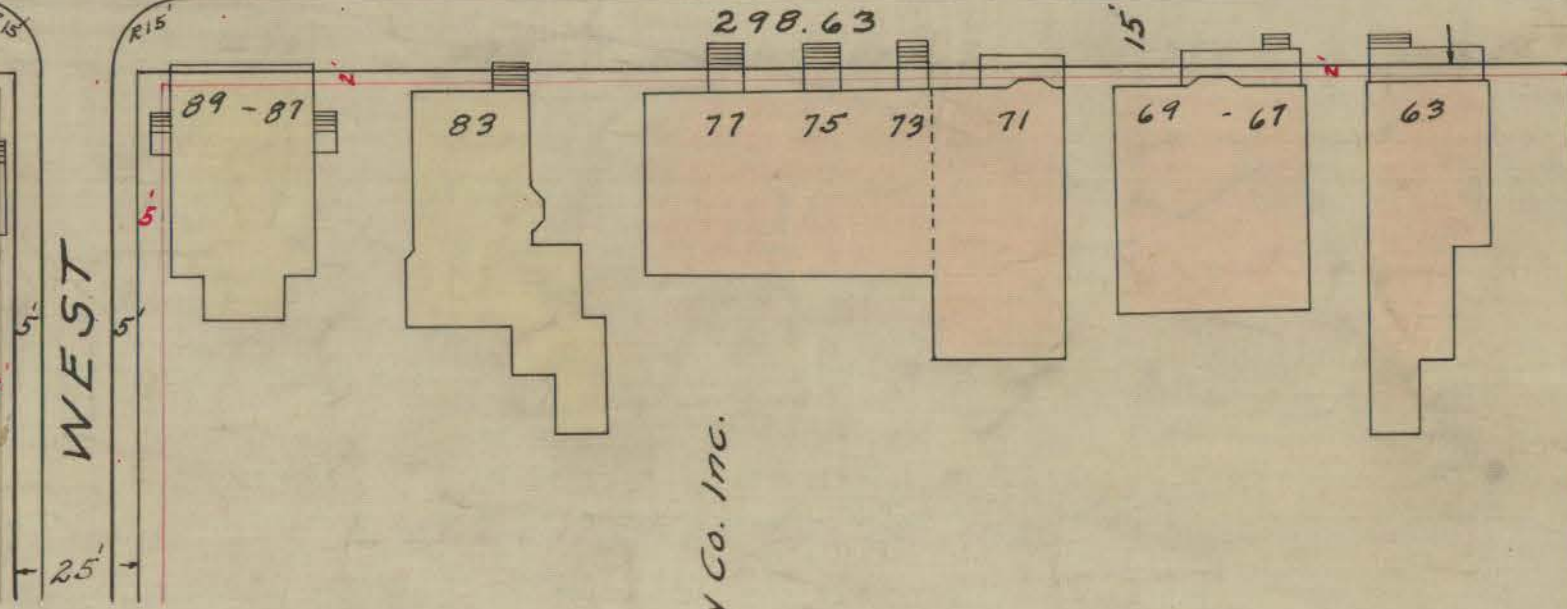

Lithuanian Roman Catholic Church of the Most Holy Trinity

St. Irene's Hellenic Orthodox Church

WHITMAN COURT

William Hamersley Est.

Charles & Pauline Stoppa

Mary E. Shea

Margaret A. Flynn Elizabeth T. Carmody

Kitty B. Morse

Domicele Aksonitis

Charles & Pauline Stoppa

Isadore Wise

MAIN

OFFICE OF CITY ENGINEER
HARTFORD, CONN.
Jan 1990
Traced from 73
City Engineer