


513
512

513
512

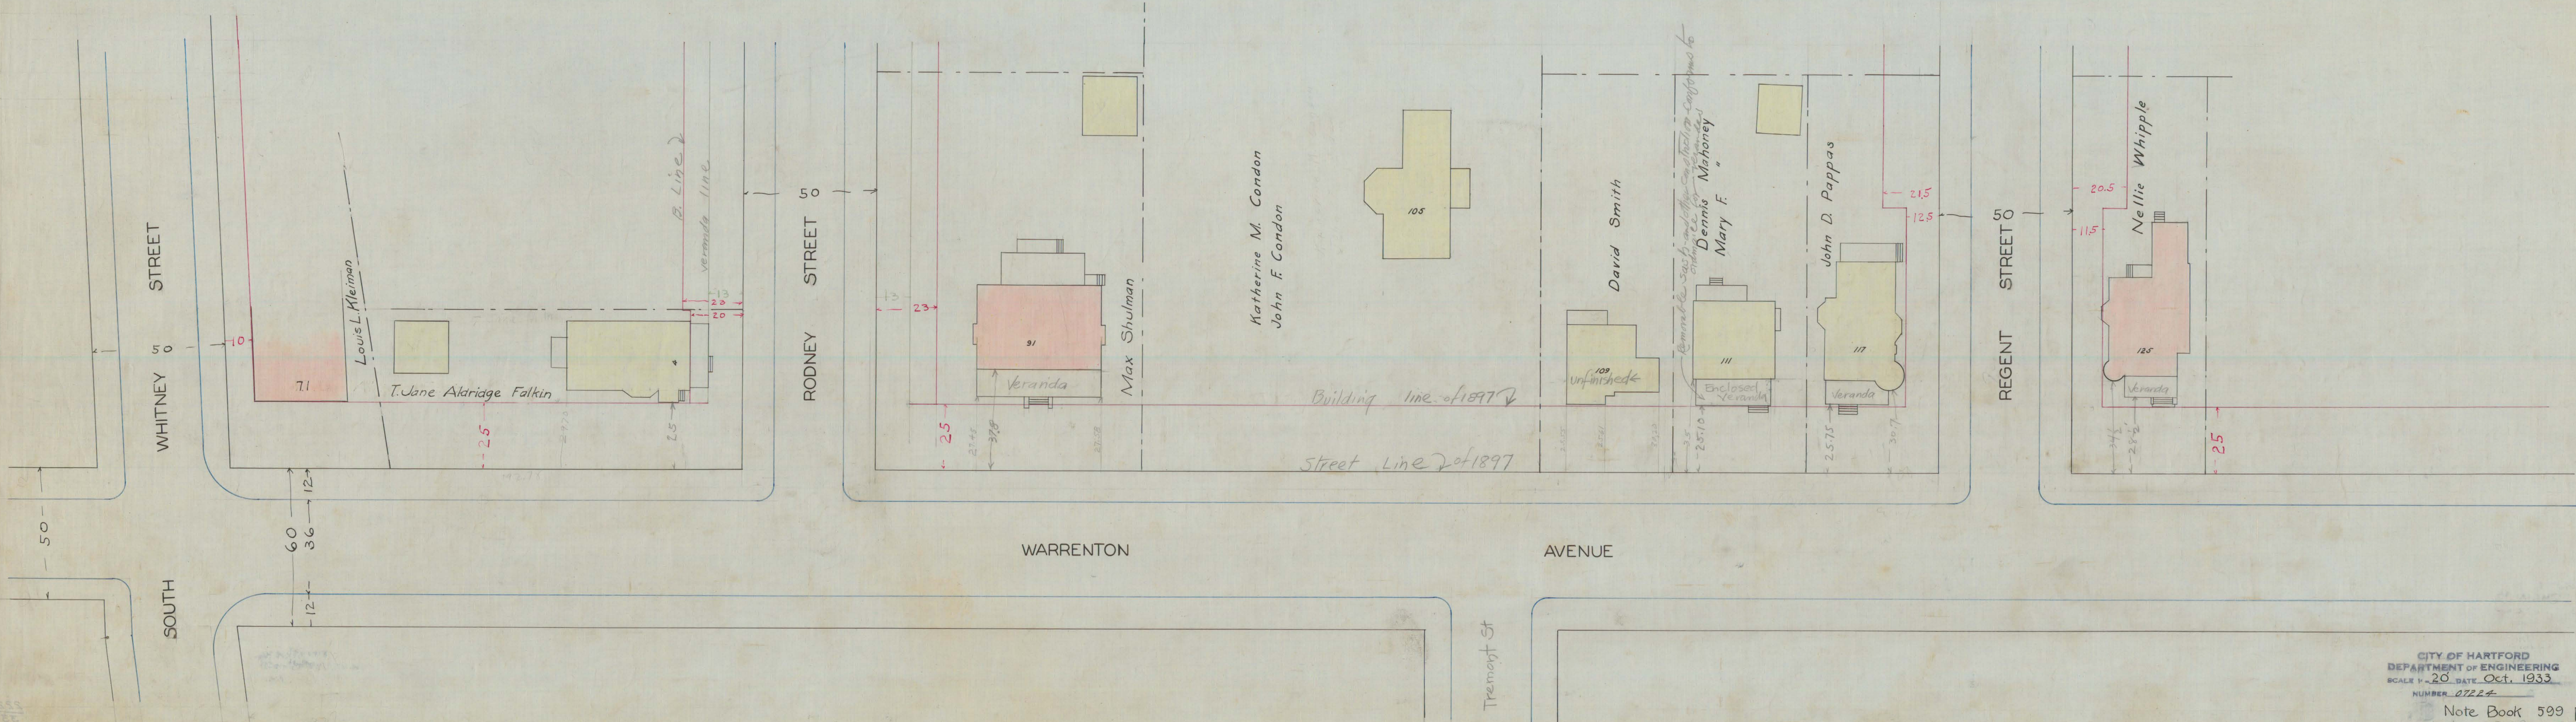

CITY OF HARTFORD
DEPARTMENT OF ENGINEERING
SCALE 1" = 20' DATE Oct. 1933
NUMBER 07224

Note Book 599 p. 90
Vol 4-P249-1897