MORTGAGE SURVEY
PROPERTY OF
SHELDON-OAK HOUSING, INC.
COLUMBUS BOULEVARD, SHELDON STREET
CAPITOL AVENUE
HARTFORD CONN.
JUNE 1970 SCALE 1" = 30'
FHA #017-35018-NP-SUP-R

TO FEDERAL HOUSING ADMINISTRATION:
TO CONNECTICUT GENERAL LIFE INSURANCE COMPANY:
TO ALL PARTIES INTERESTED IN TITLE TO PREMISES SURVEYED:
TO LAWYERS TITLE INSURANCE CORPORATION:

I hereby certify that this survey was actually made upon the ground, and that it and the information, courses and distances shown thereon are correct; that the title lines and lines of actual possession are the same; that the size, location and type of buildings and improvements are as shown and all are within the boundary lines of the property; that there are no violations of zoning ordinances, restrictions or other rules and regulations with reference to the location of said buildings and improvements; and that there are no easements, encroachment, or uses affecting this property apparent from a careful physical inspection of the same, other than those shown and depicted thereon.

William J. Kozlowski
Registered Land Surveyor

STATE OF CONNECTICUT
WILLIAM J. KOZLOWSKI
No. 1981
REGISTERED LAND SURVEYOR

"This survey conforms to Class A-2 Standards of Accuracy of the Code of The Connecticut Technical Council, Inc."
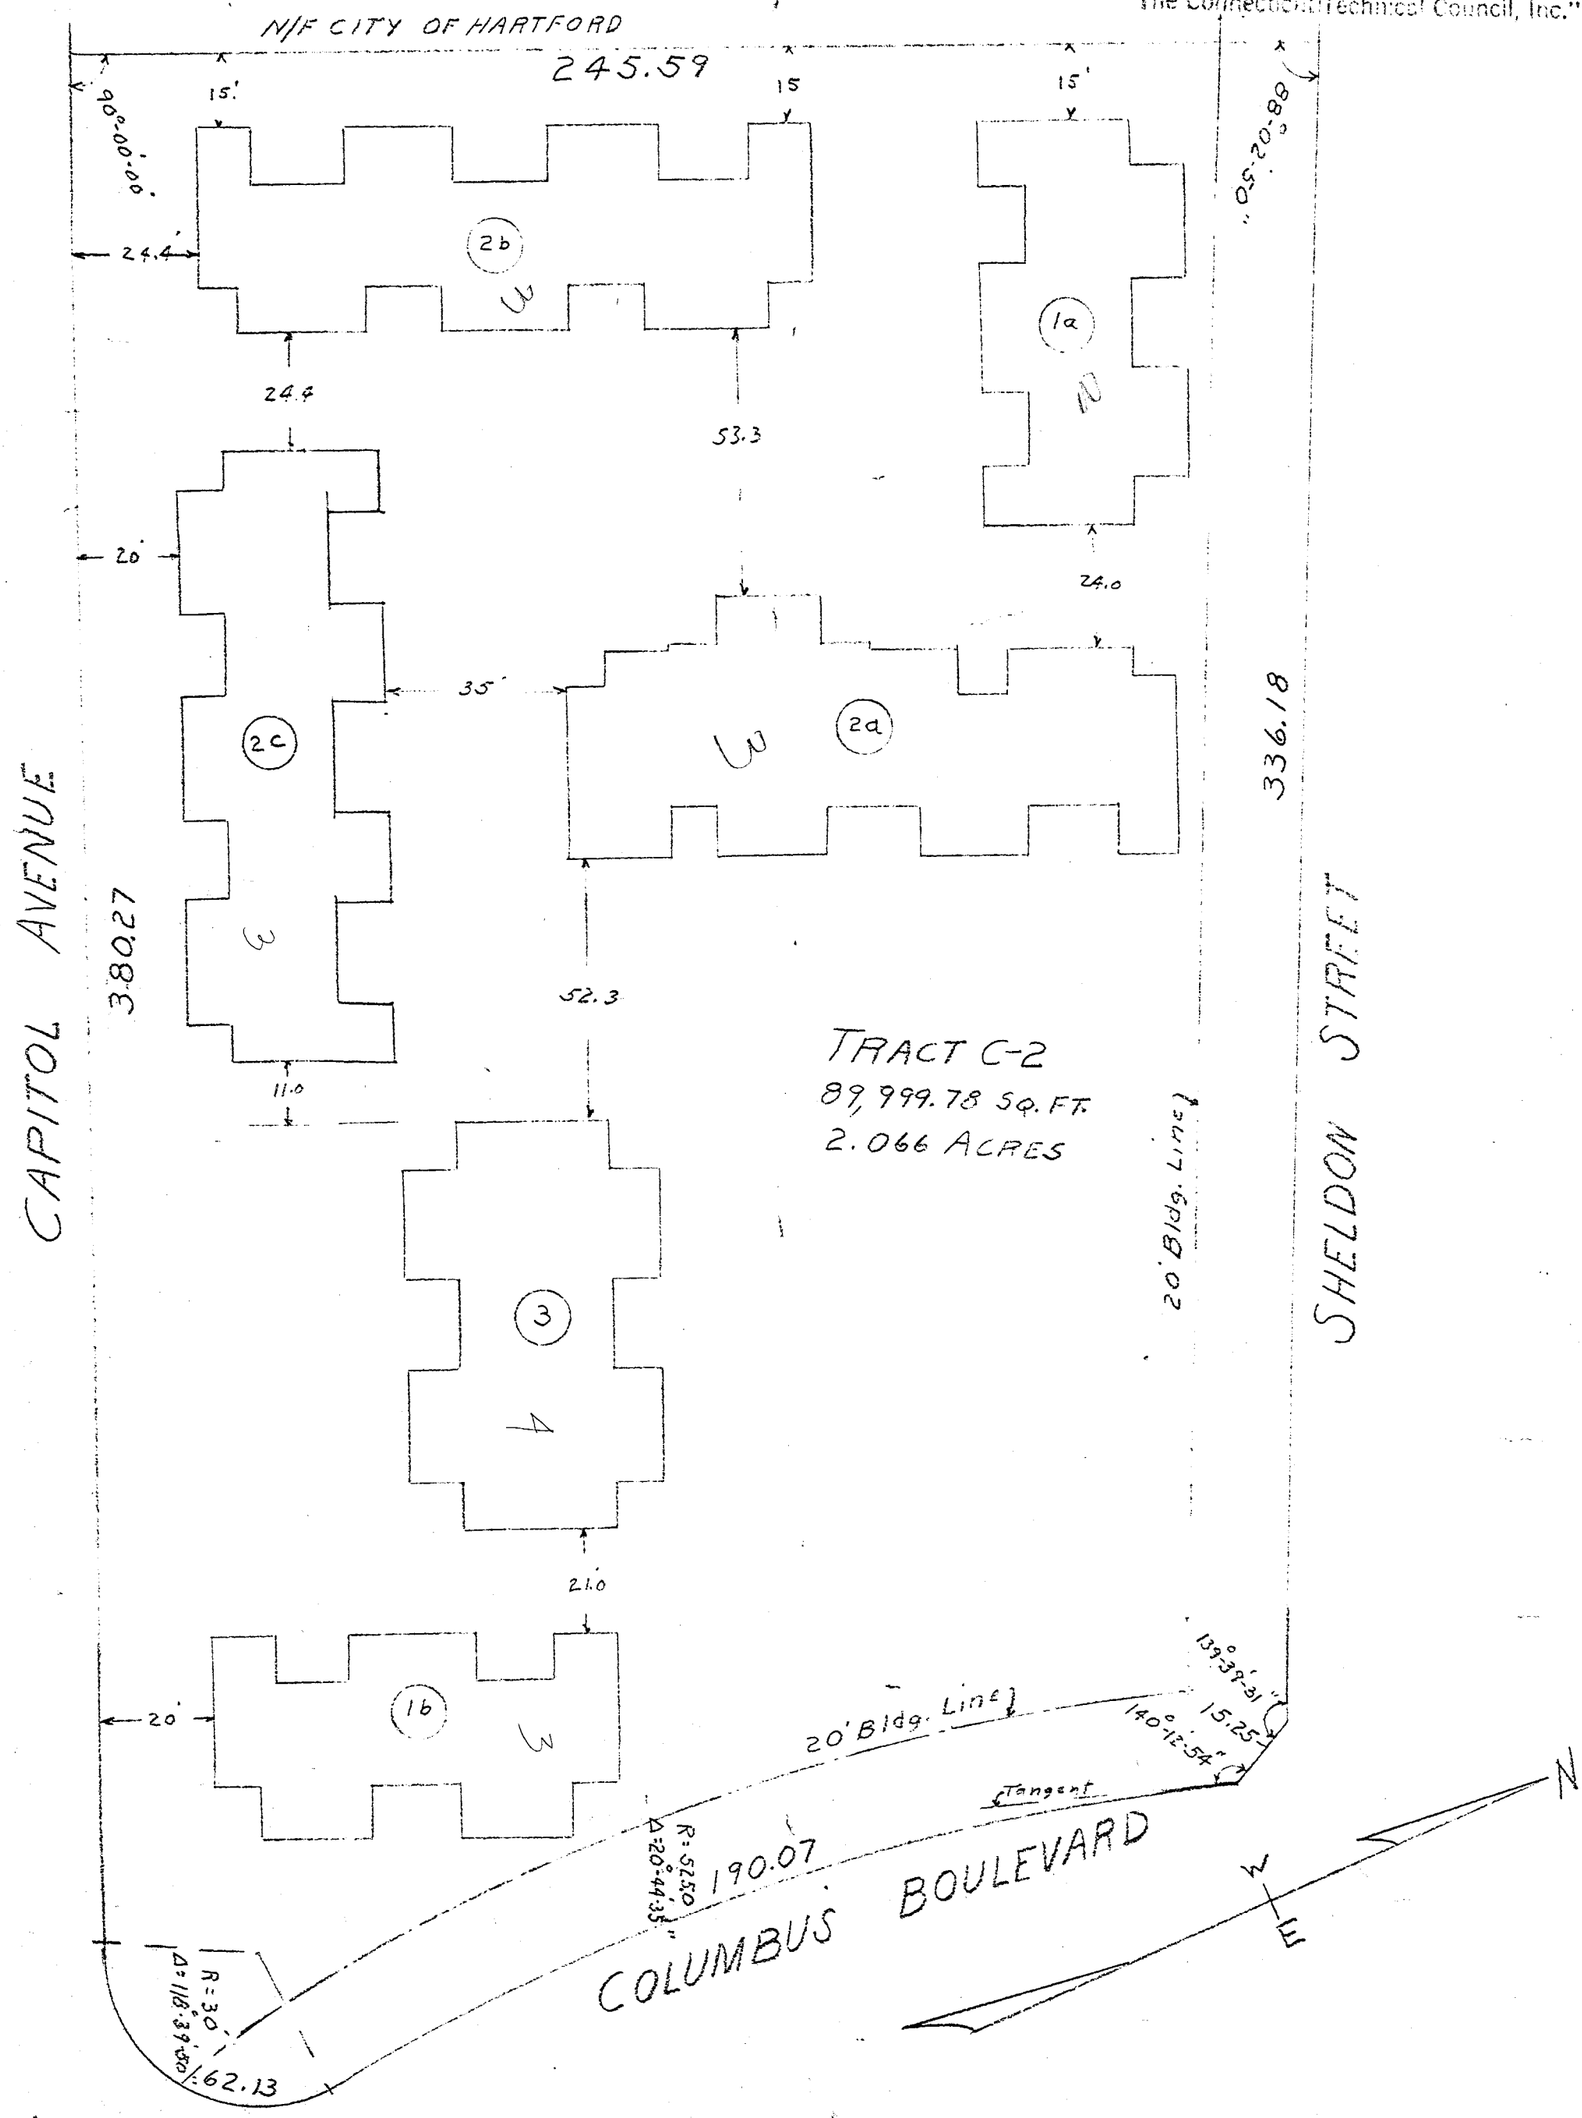
NOTE: THE FOUNDATIONS HAVE BEEN POURED AS SHOWN.