

Reestablish this grade
~~NORTH HUNTINGTON STREET~~
 Borkin St

542.9 well R.S. 6 on C.S.
 1909
 134.80 X Not set
 Old grade
 changed
 1909
 35.10 Not set

B. 711 West Side of Curved Stone at
 Bottom of East Stone pillar S.G. Battersons
 Driveway 60.38

grade set June 1909


Plunge 1925

1569 E 9th Ave well E. K. C. L. line

Both Curb

62.45 N.W. Curb Car.
 62.05 NE "

NORTH LINE HOMESTEAD AVE.

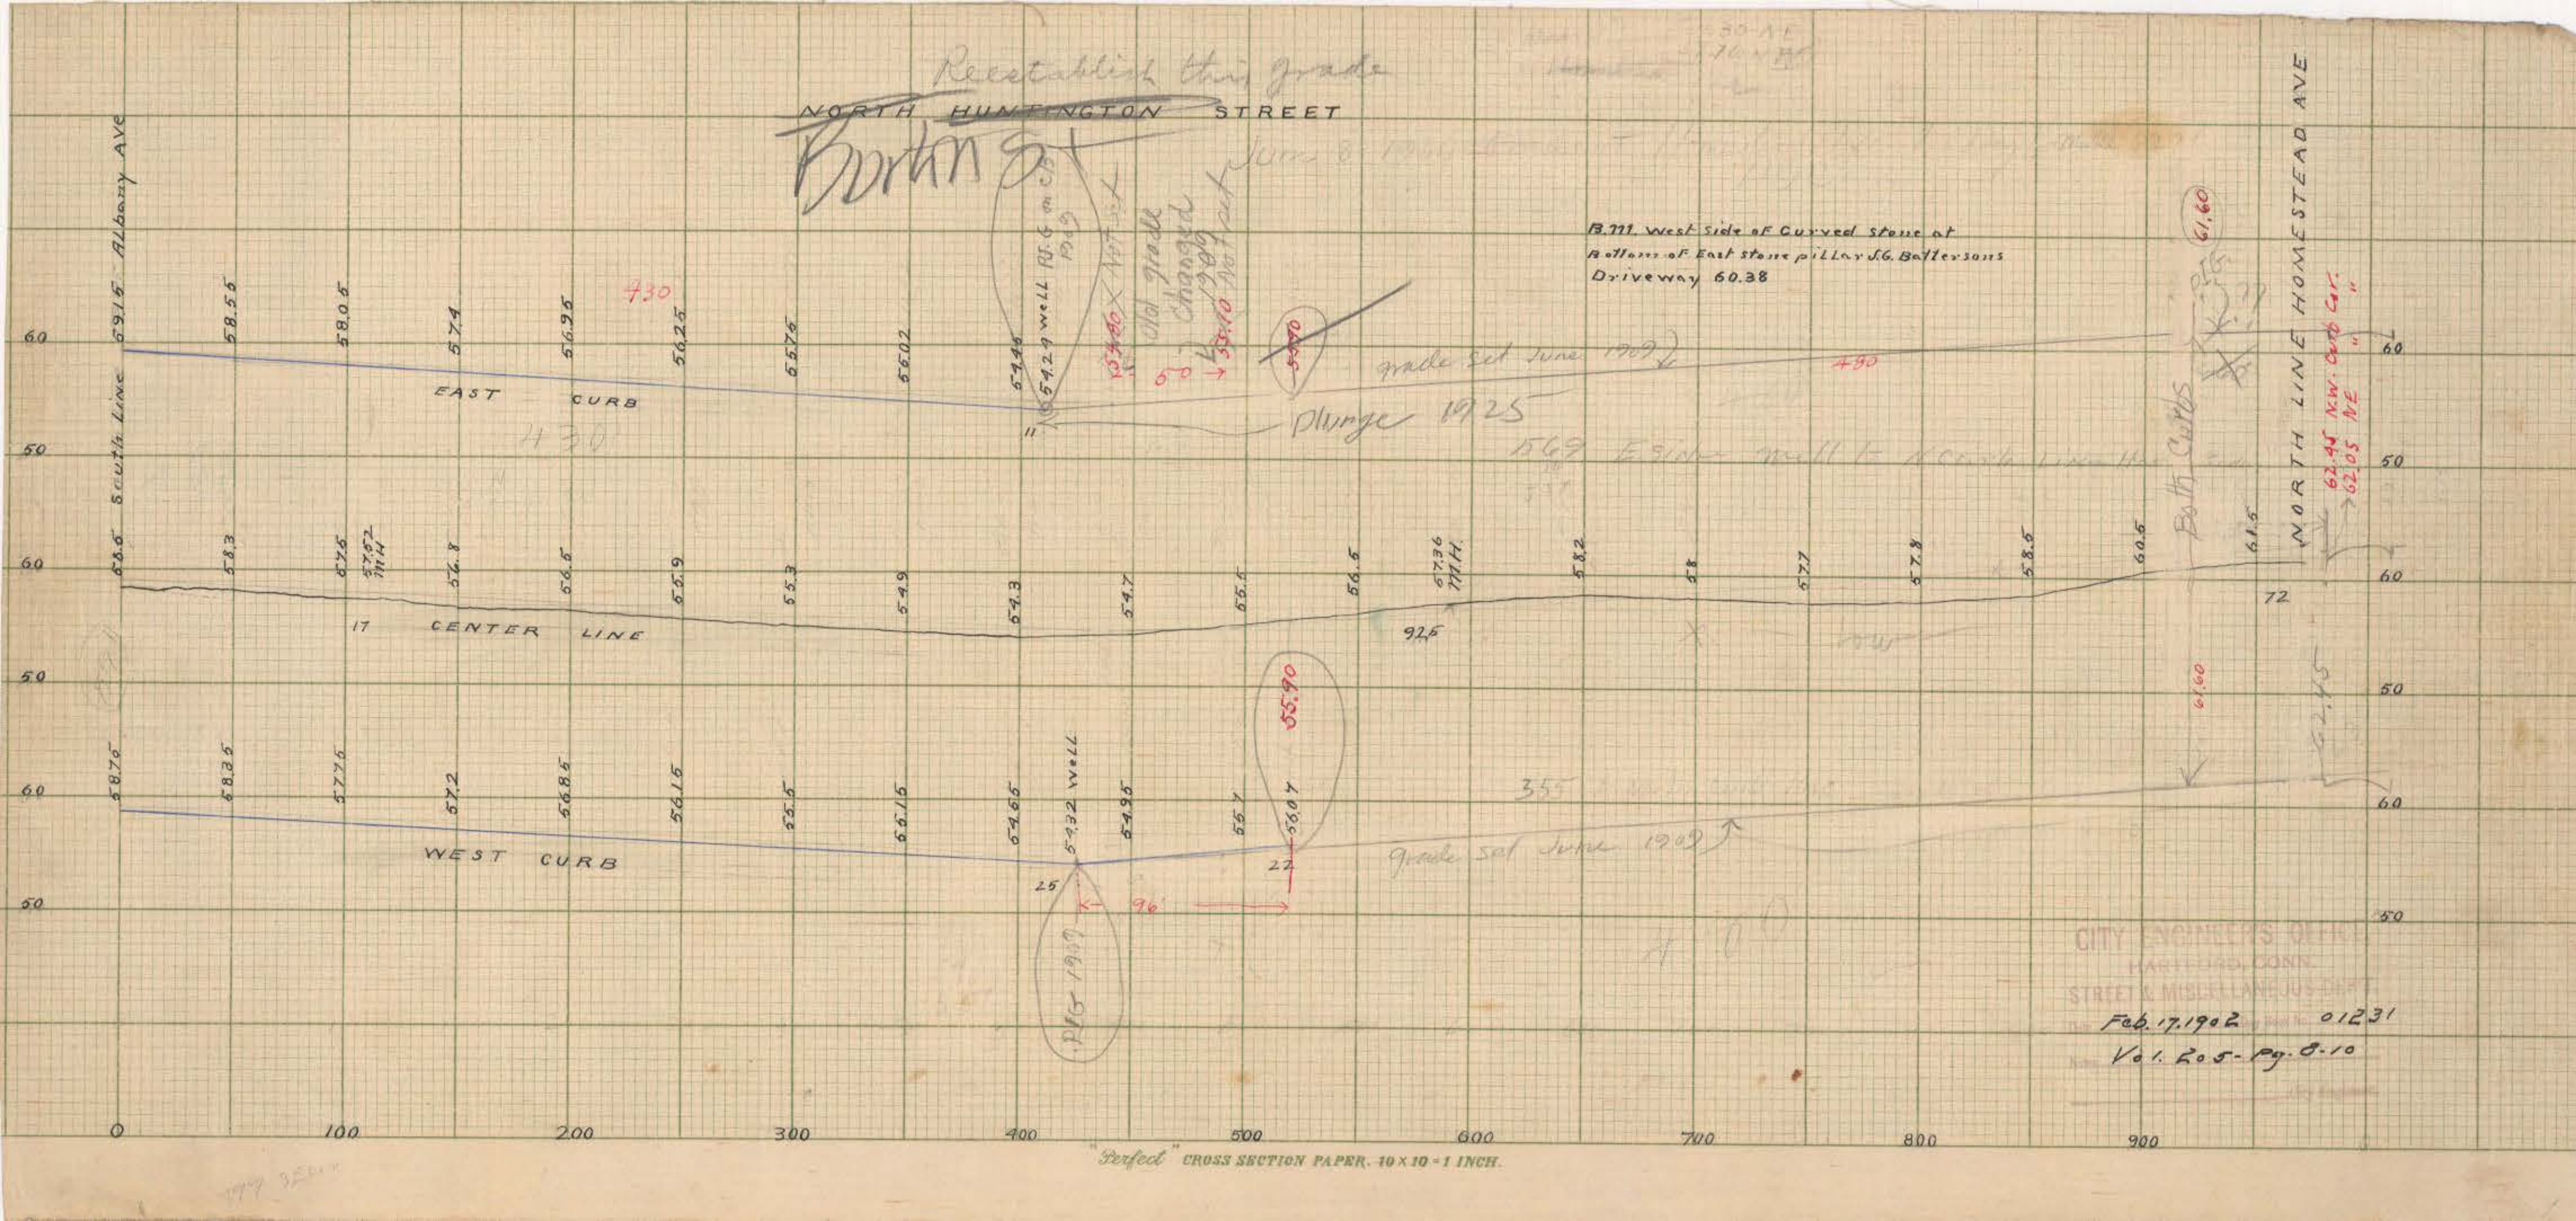

CITY ENGINEER'S OFFICE
 HARTFORD, CONN.
 STREET & MISCELLANEOUS DEPT.
 Feb. 17, 1902
 Vol. 205 - Pg. 8-10