

WETHERSFIELD

OF

TOWNSHIP



9257

9259

9258

9260


See Sheet 115

City of Hartford
(Goodwin - Park)

2162

9968

All blank lots owned by The Development Co. of Hartford

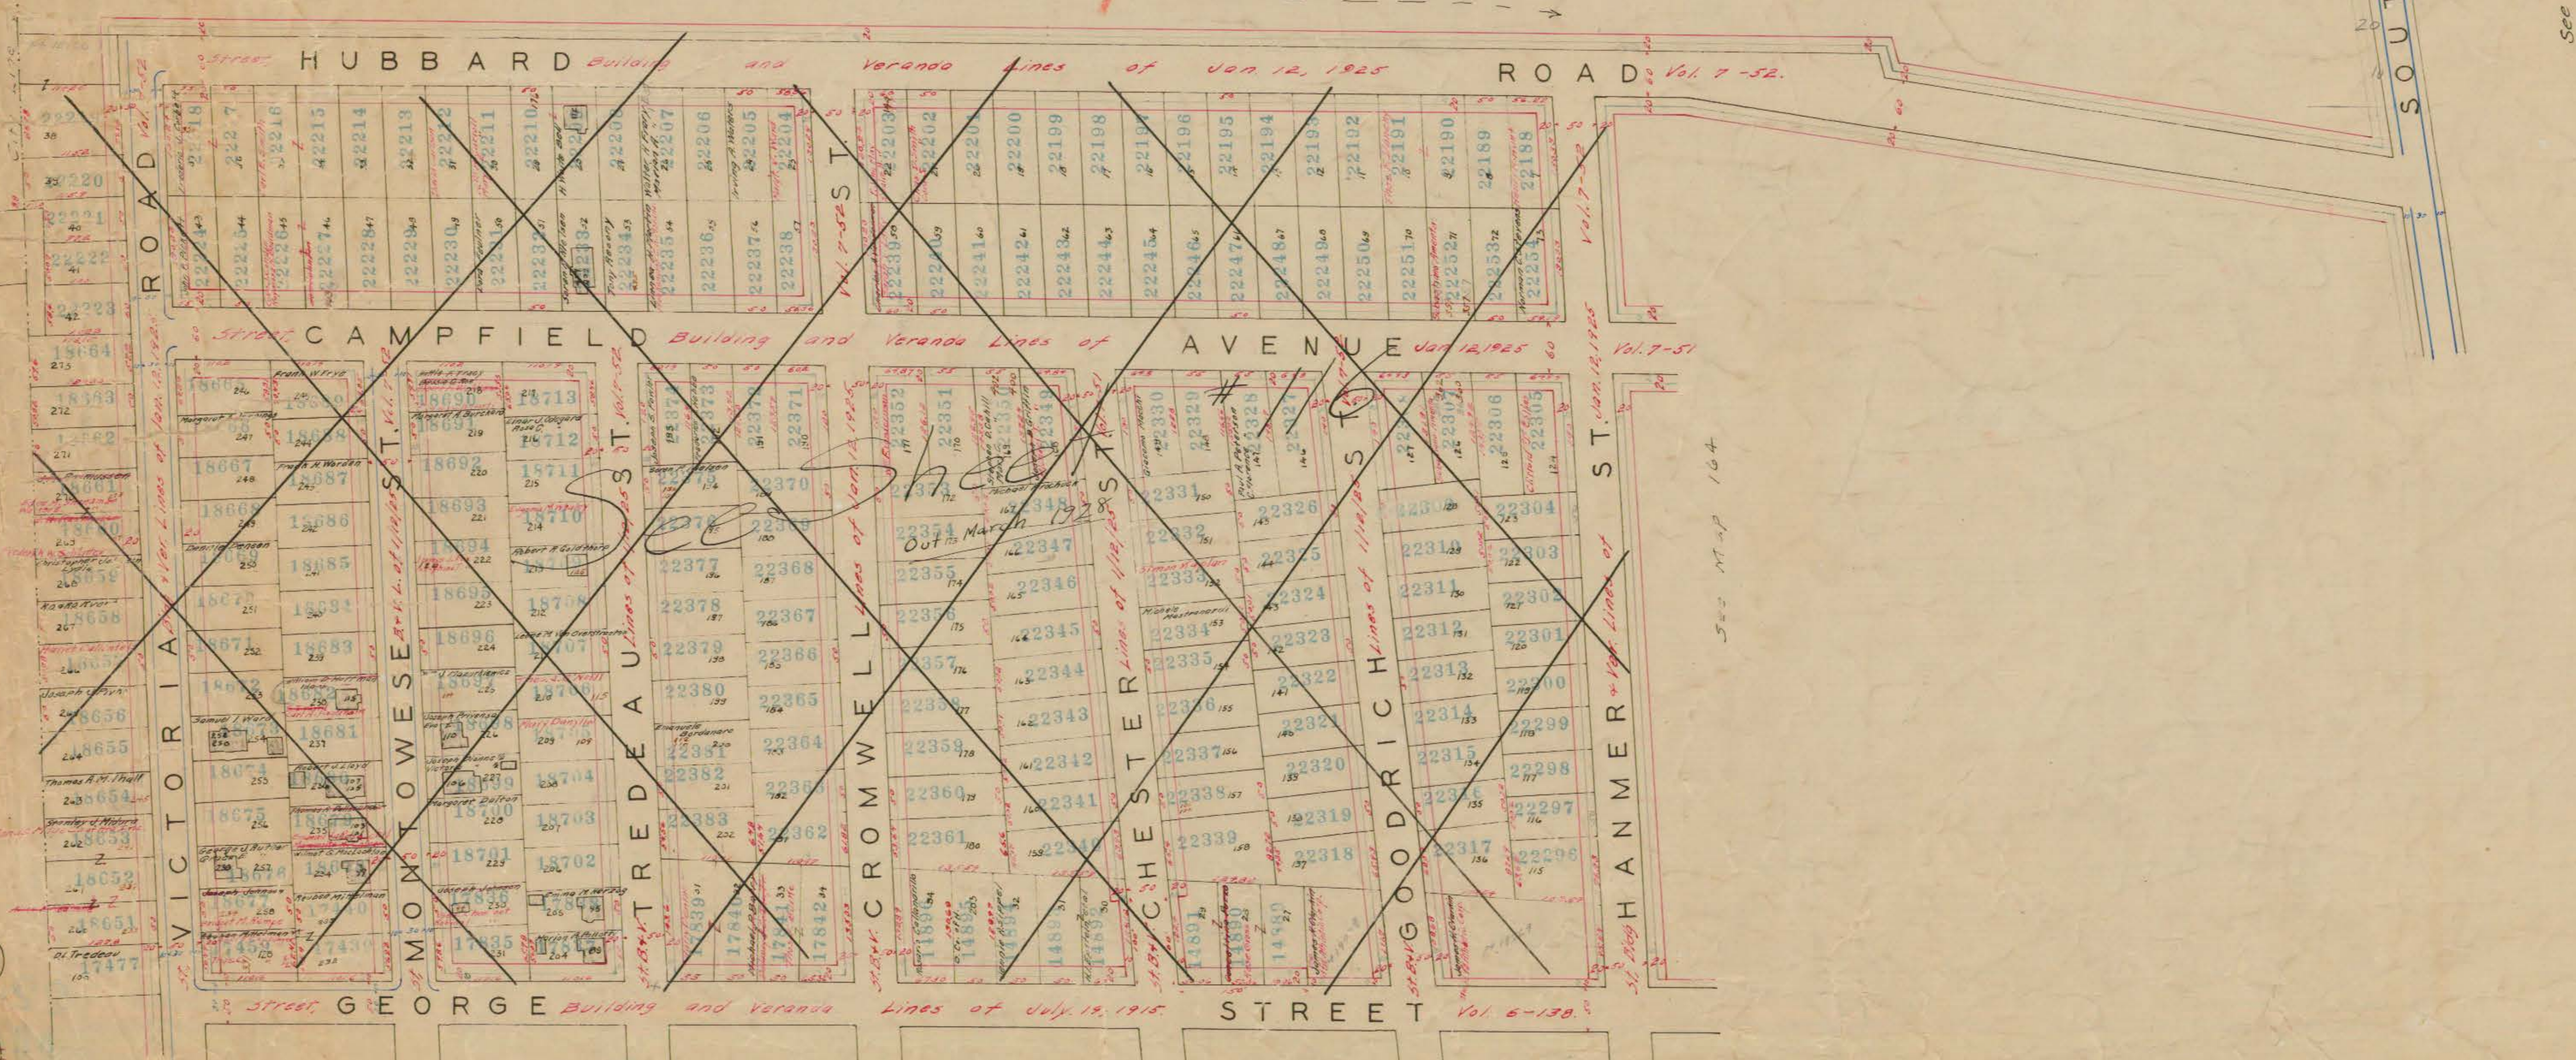

See
Sheet 154
154
153
Sheet
152
SOUTH
ST. Bldg & Ver. Lines of Vol. 5-92 S.T.
Vol. 5-92 S.T.
Vol. 6-130 S.T.
Vol. 7-51
Vol. 7-52