


# SHELDON-CHARTER OAK PROJECT

## TRACT D

202,439.684 Sq. Ft.  
202,414,411

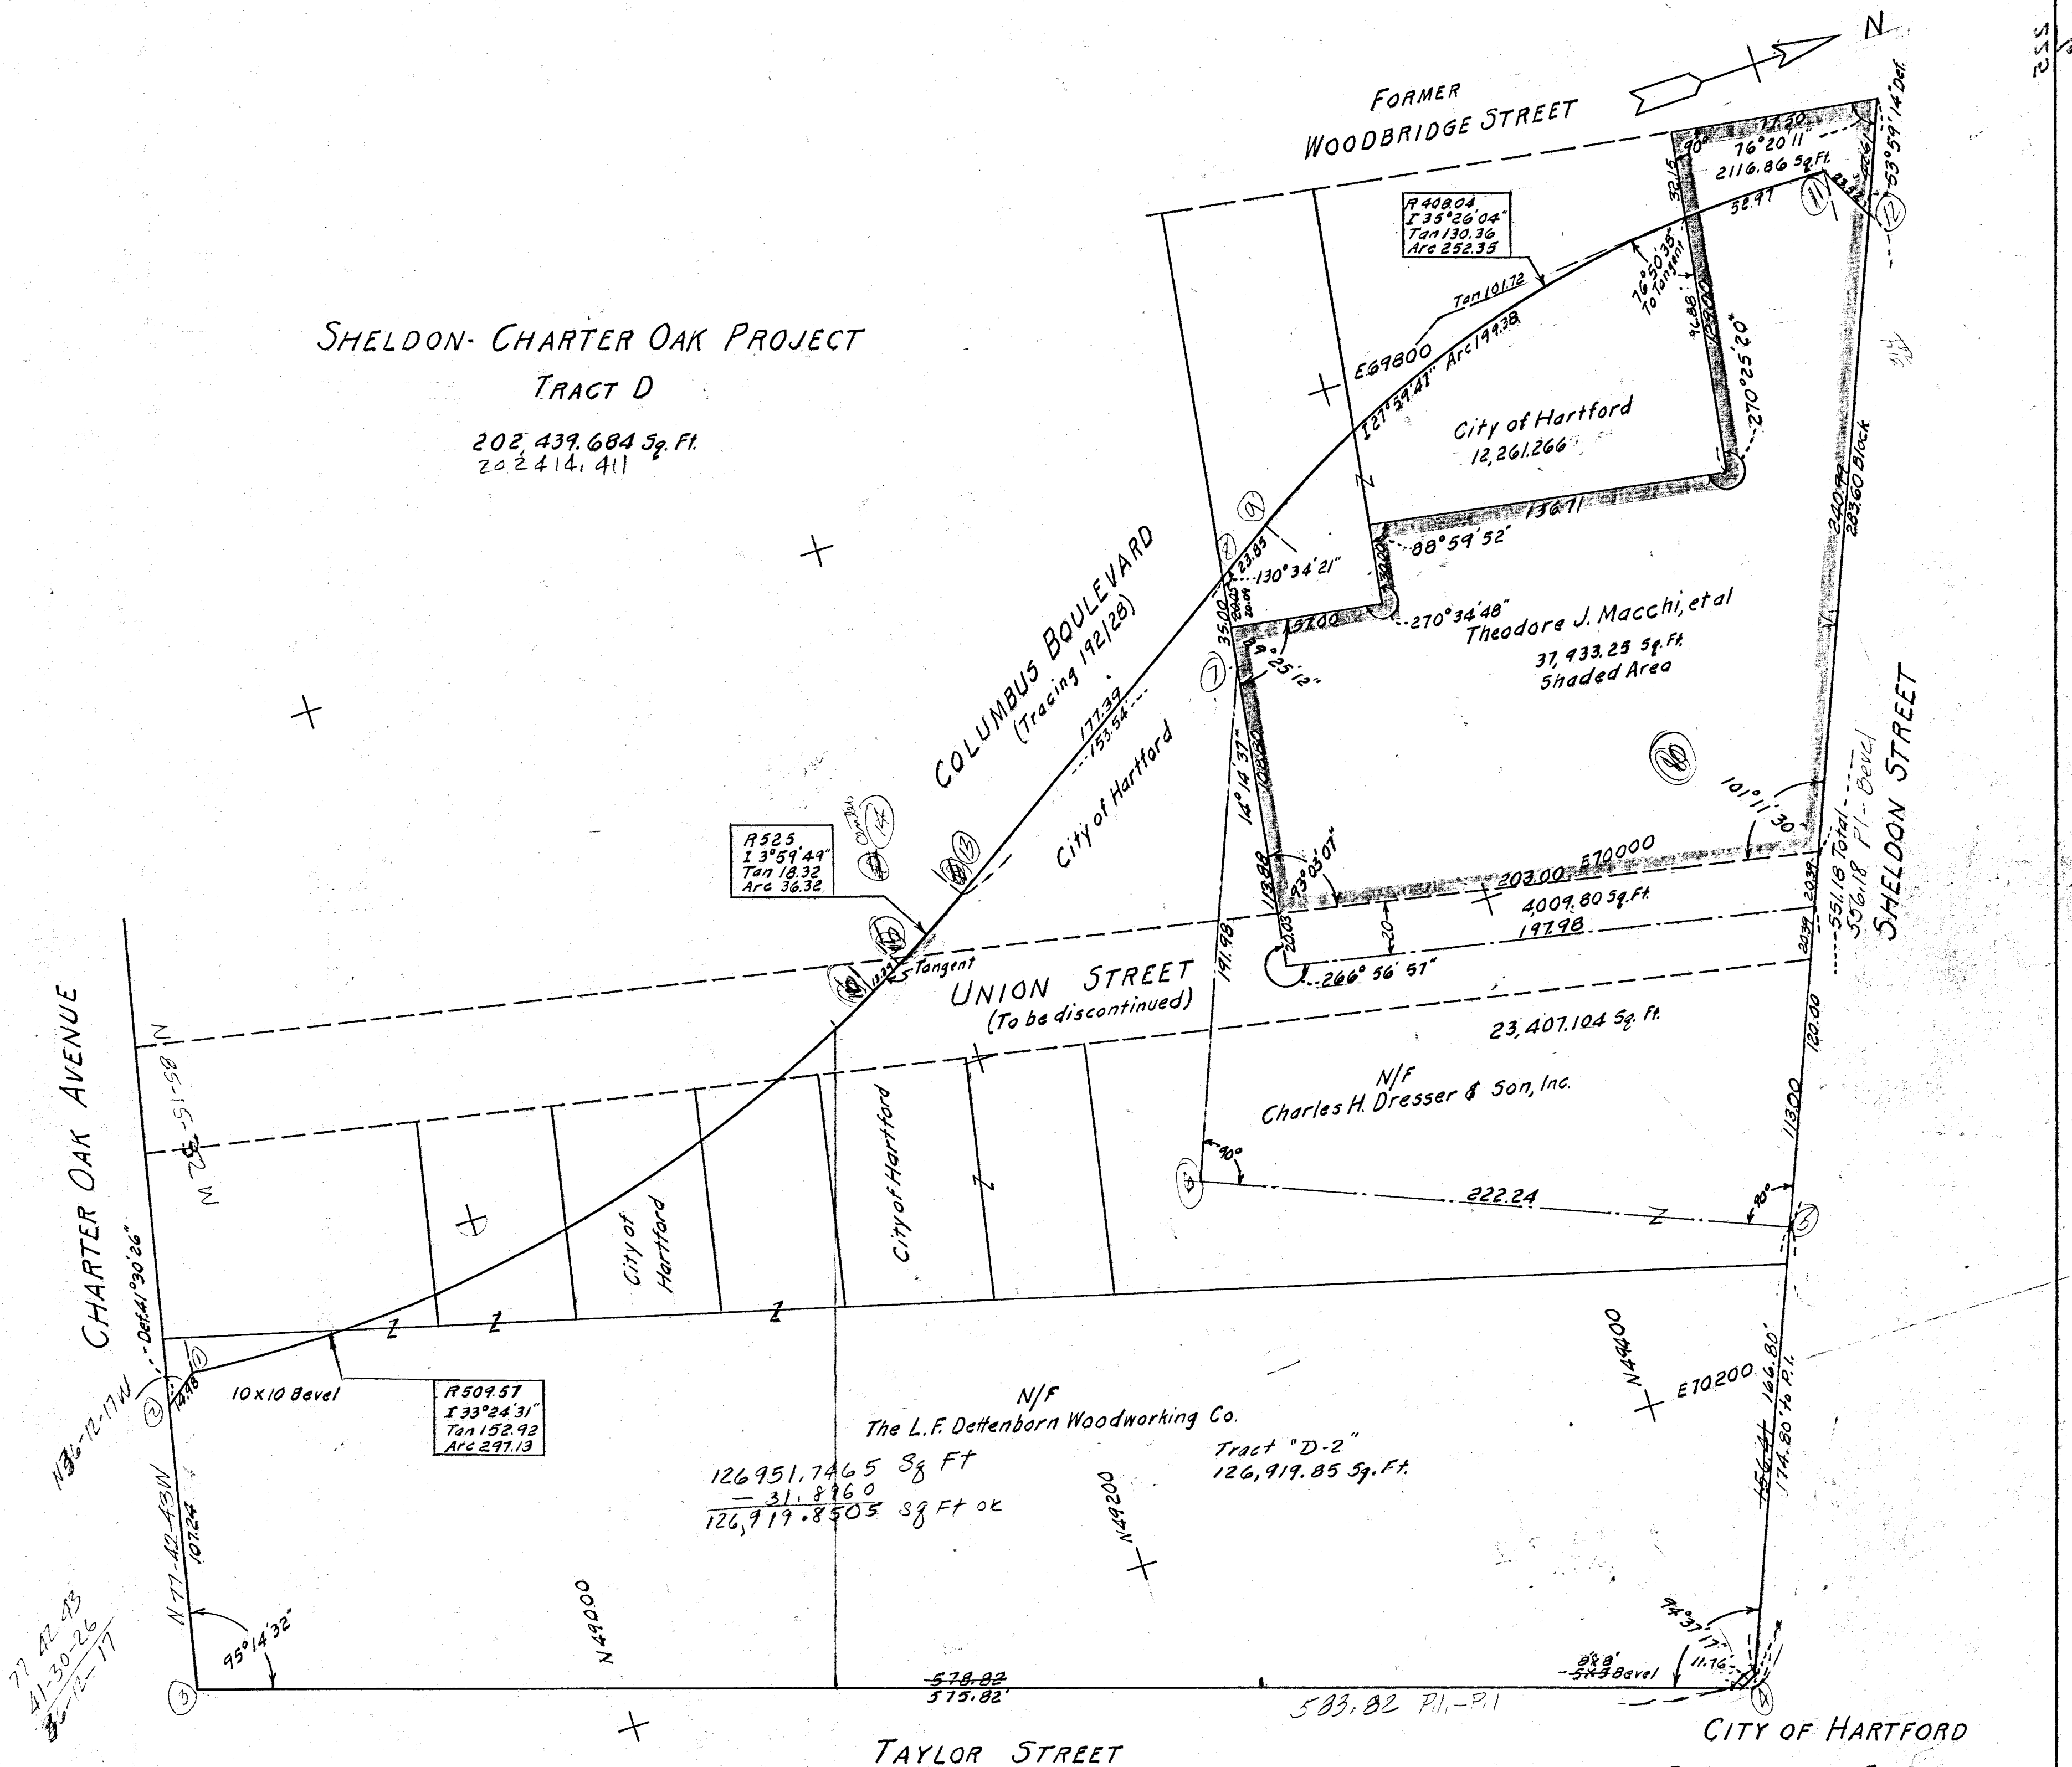

CITY OF HARTFORD  
DEPARTMENT OF ENGINEERING  
SCALE 1"=40' MAY 1968  
DAYBOOK No. 010036

Revised 7/23/81