


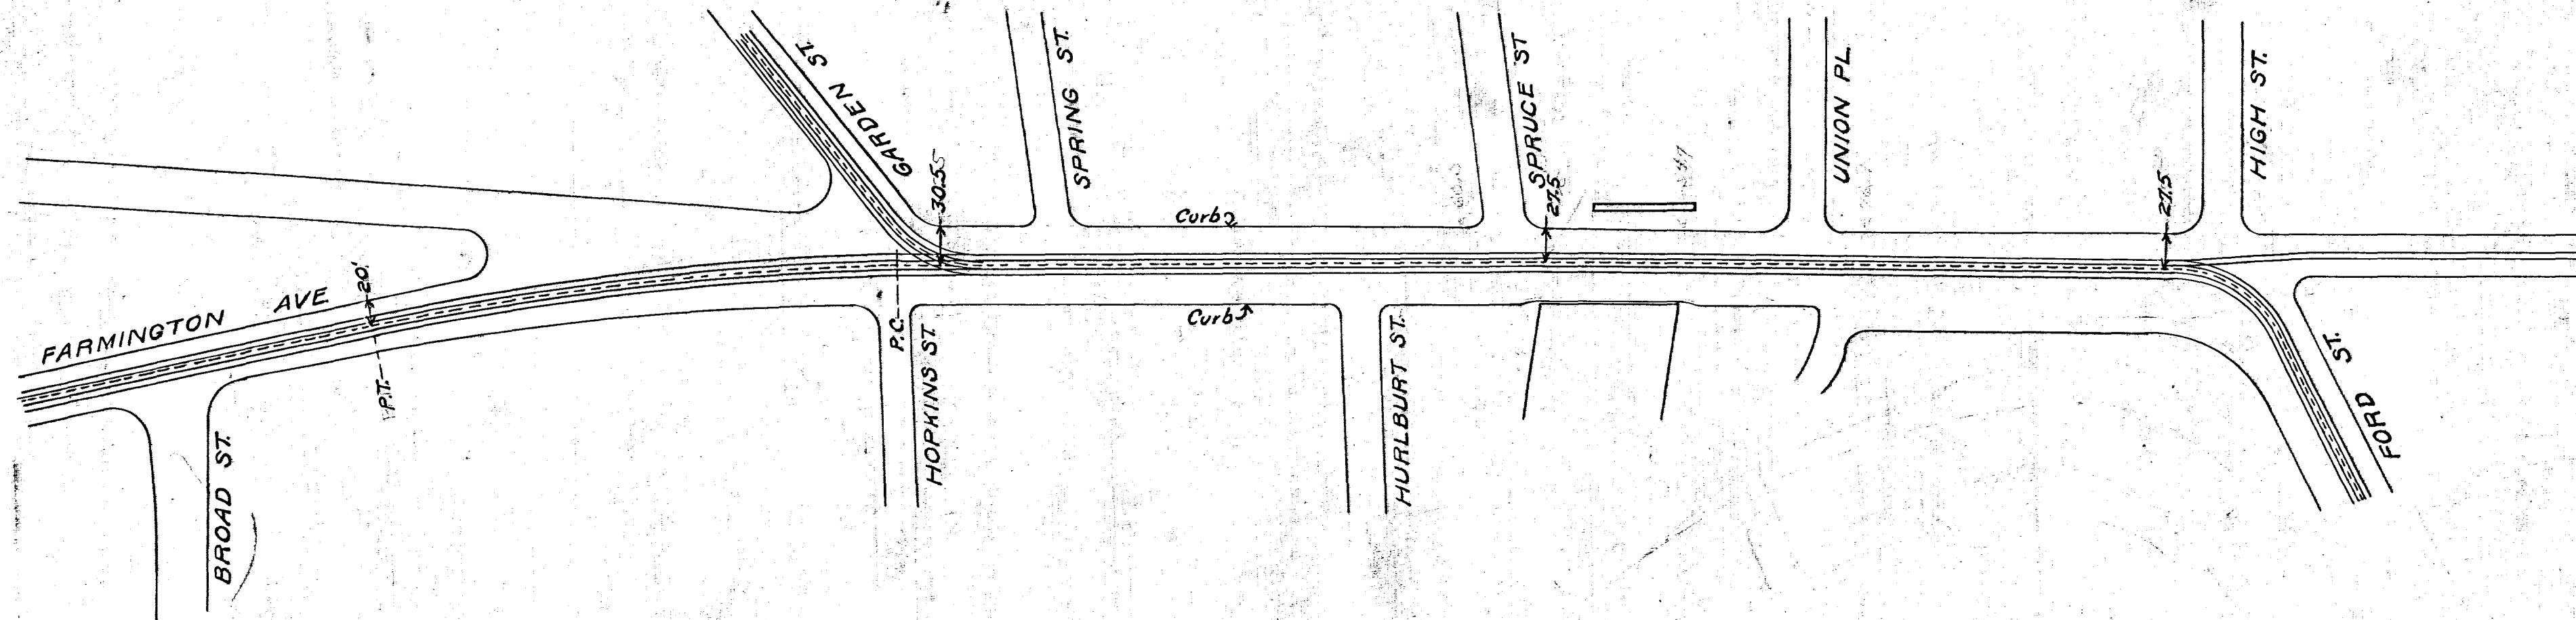

OFFICE OF CITY ENGINEER
 HARTFORD, CONN.
 Date Dec. 1926
 Notes
 R.N. Clark, City Engineer
 Scale 1"=100'