


Horizontal Scale 1" = 40'
Vertical " 1" = 4' Nov.-23 1912

Vertical " 1st 4' Nov. 23 1912

To grade Fill 1341 yds
Cut 773 "

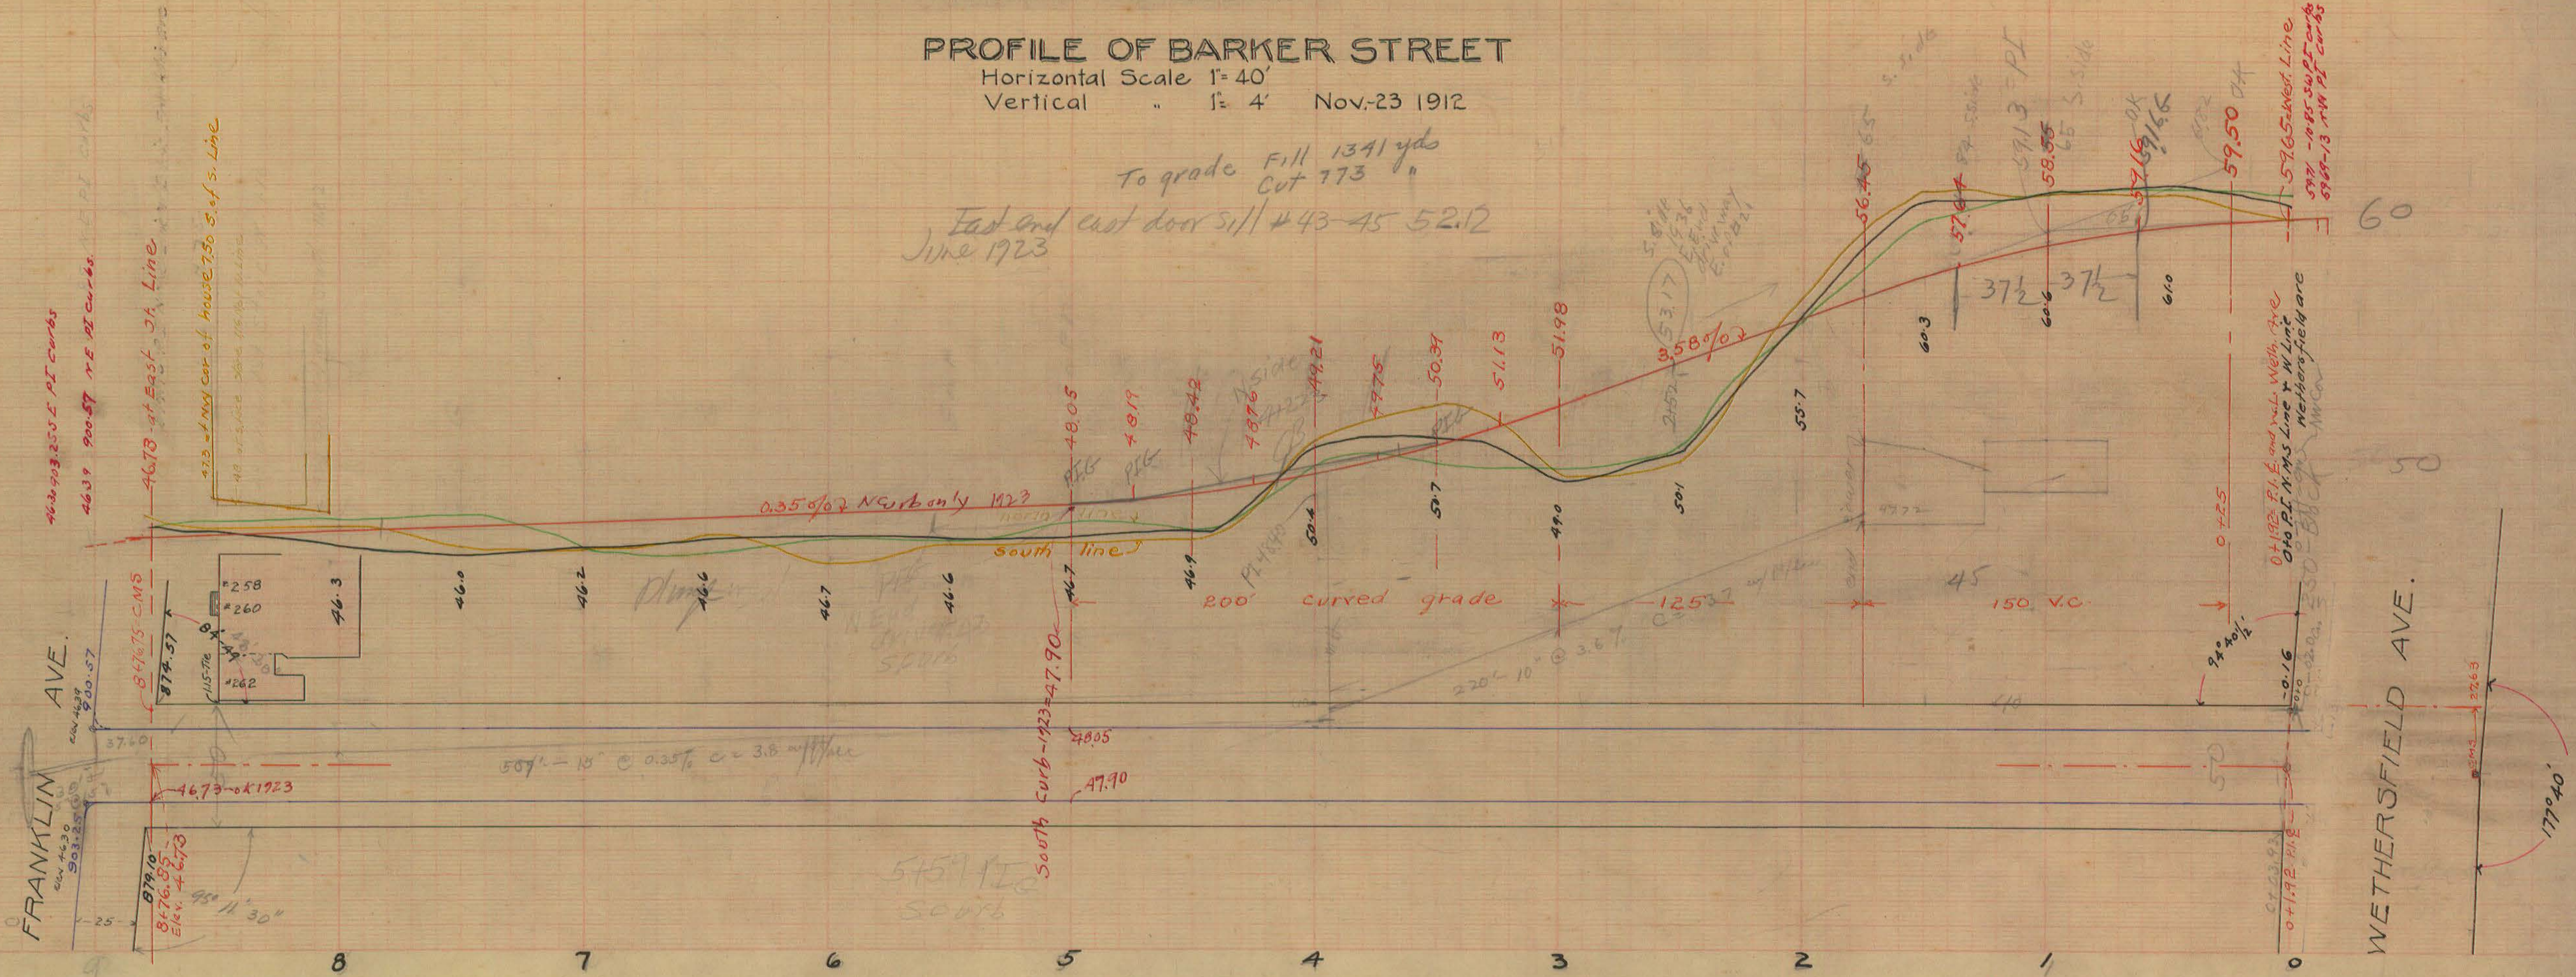

(Do not take into field)
see blueprints

NOV. 23-1912

359- 130-2-3-
88

03096