


BONNER STREET

Scale = 1" Hori = 50'
1" Vert = 10'

E. CURBLINE OF LAUREL ST 904

W. LINE ZION ST 104

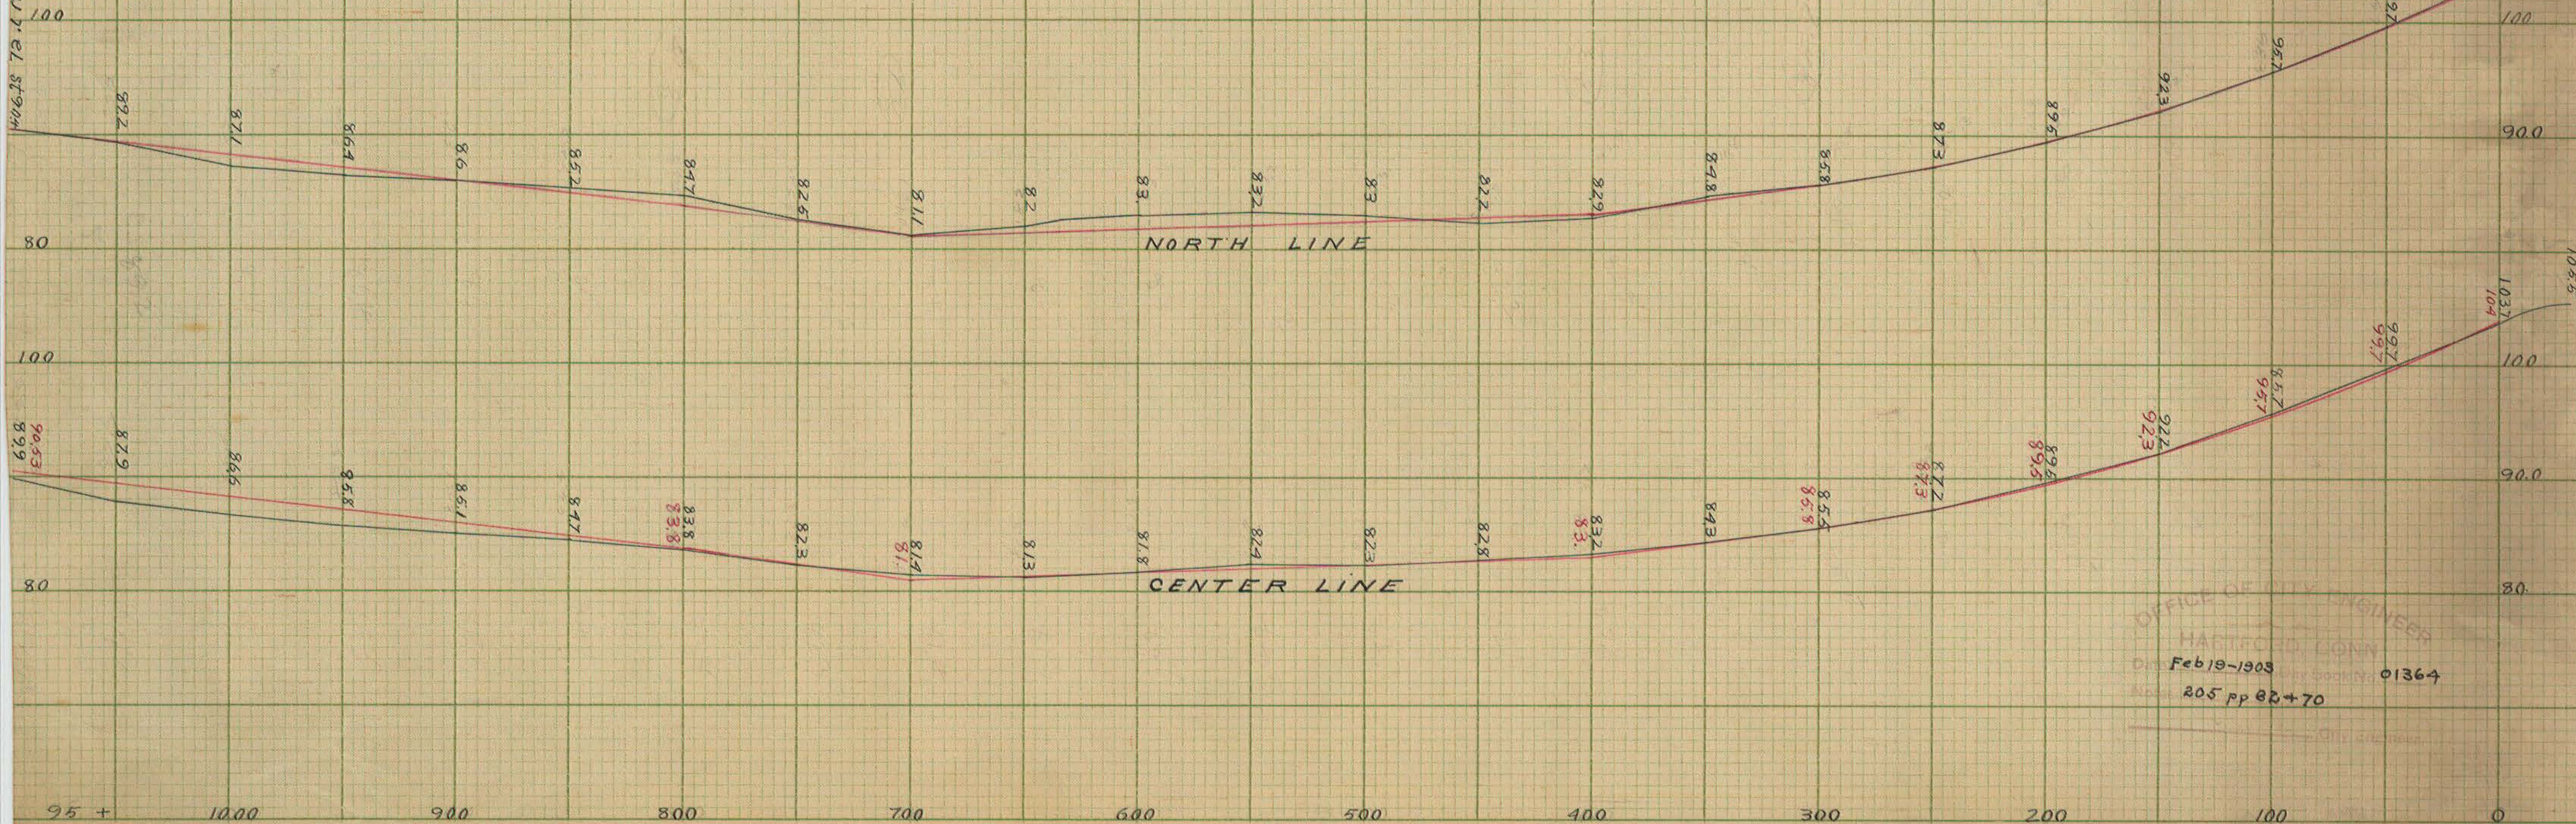

OFFICE OF THE ENGINEER
HARTFORD, CONN.
Feb 19-1903
205 pp 82+70