


INCINERATOR SITE
 PROFILE OF ROADS
 EAST AND NORTH OF BUILDING

R 584.46 I 12°14'26" Arc 124.86 Def/H: 0°02'94"116'

Station	Deflection	Total Def.	Chord
0+27.14			
+50	1°07'14"	1°07'14"	22.86
+75	1°13'32"	2°20'46"	25.00
1+0	" " "	3°34'18"	"
+25	" " "	4°47'49"	"
+52	1°19'24"	6°07'13"	27.00

R109.57 I 70°05'44" Arc 134.05 Def/H: 0°15'68"72'

Station	Deflection	Total Def.	Chord
2+0			
+25	6°32'11"	6°32'11"	24.95
+50	" " "	13°04'22"	"
+75	" " "	19°36'32"	"
3+0	" " "	26°08'43"	"
+25	" " "	32°40'54"	"
+34.05	2°21'58"	35°02'52"	9.05

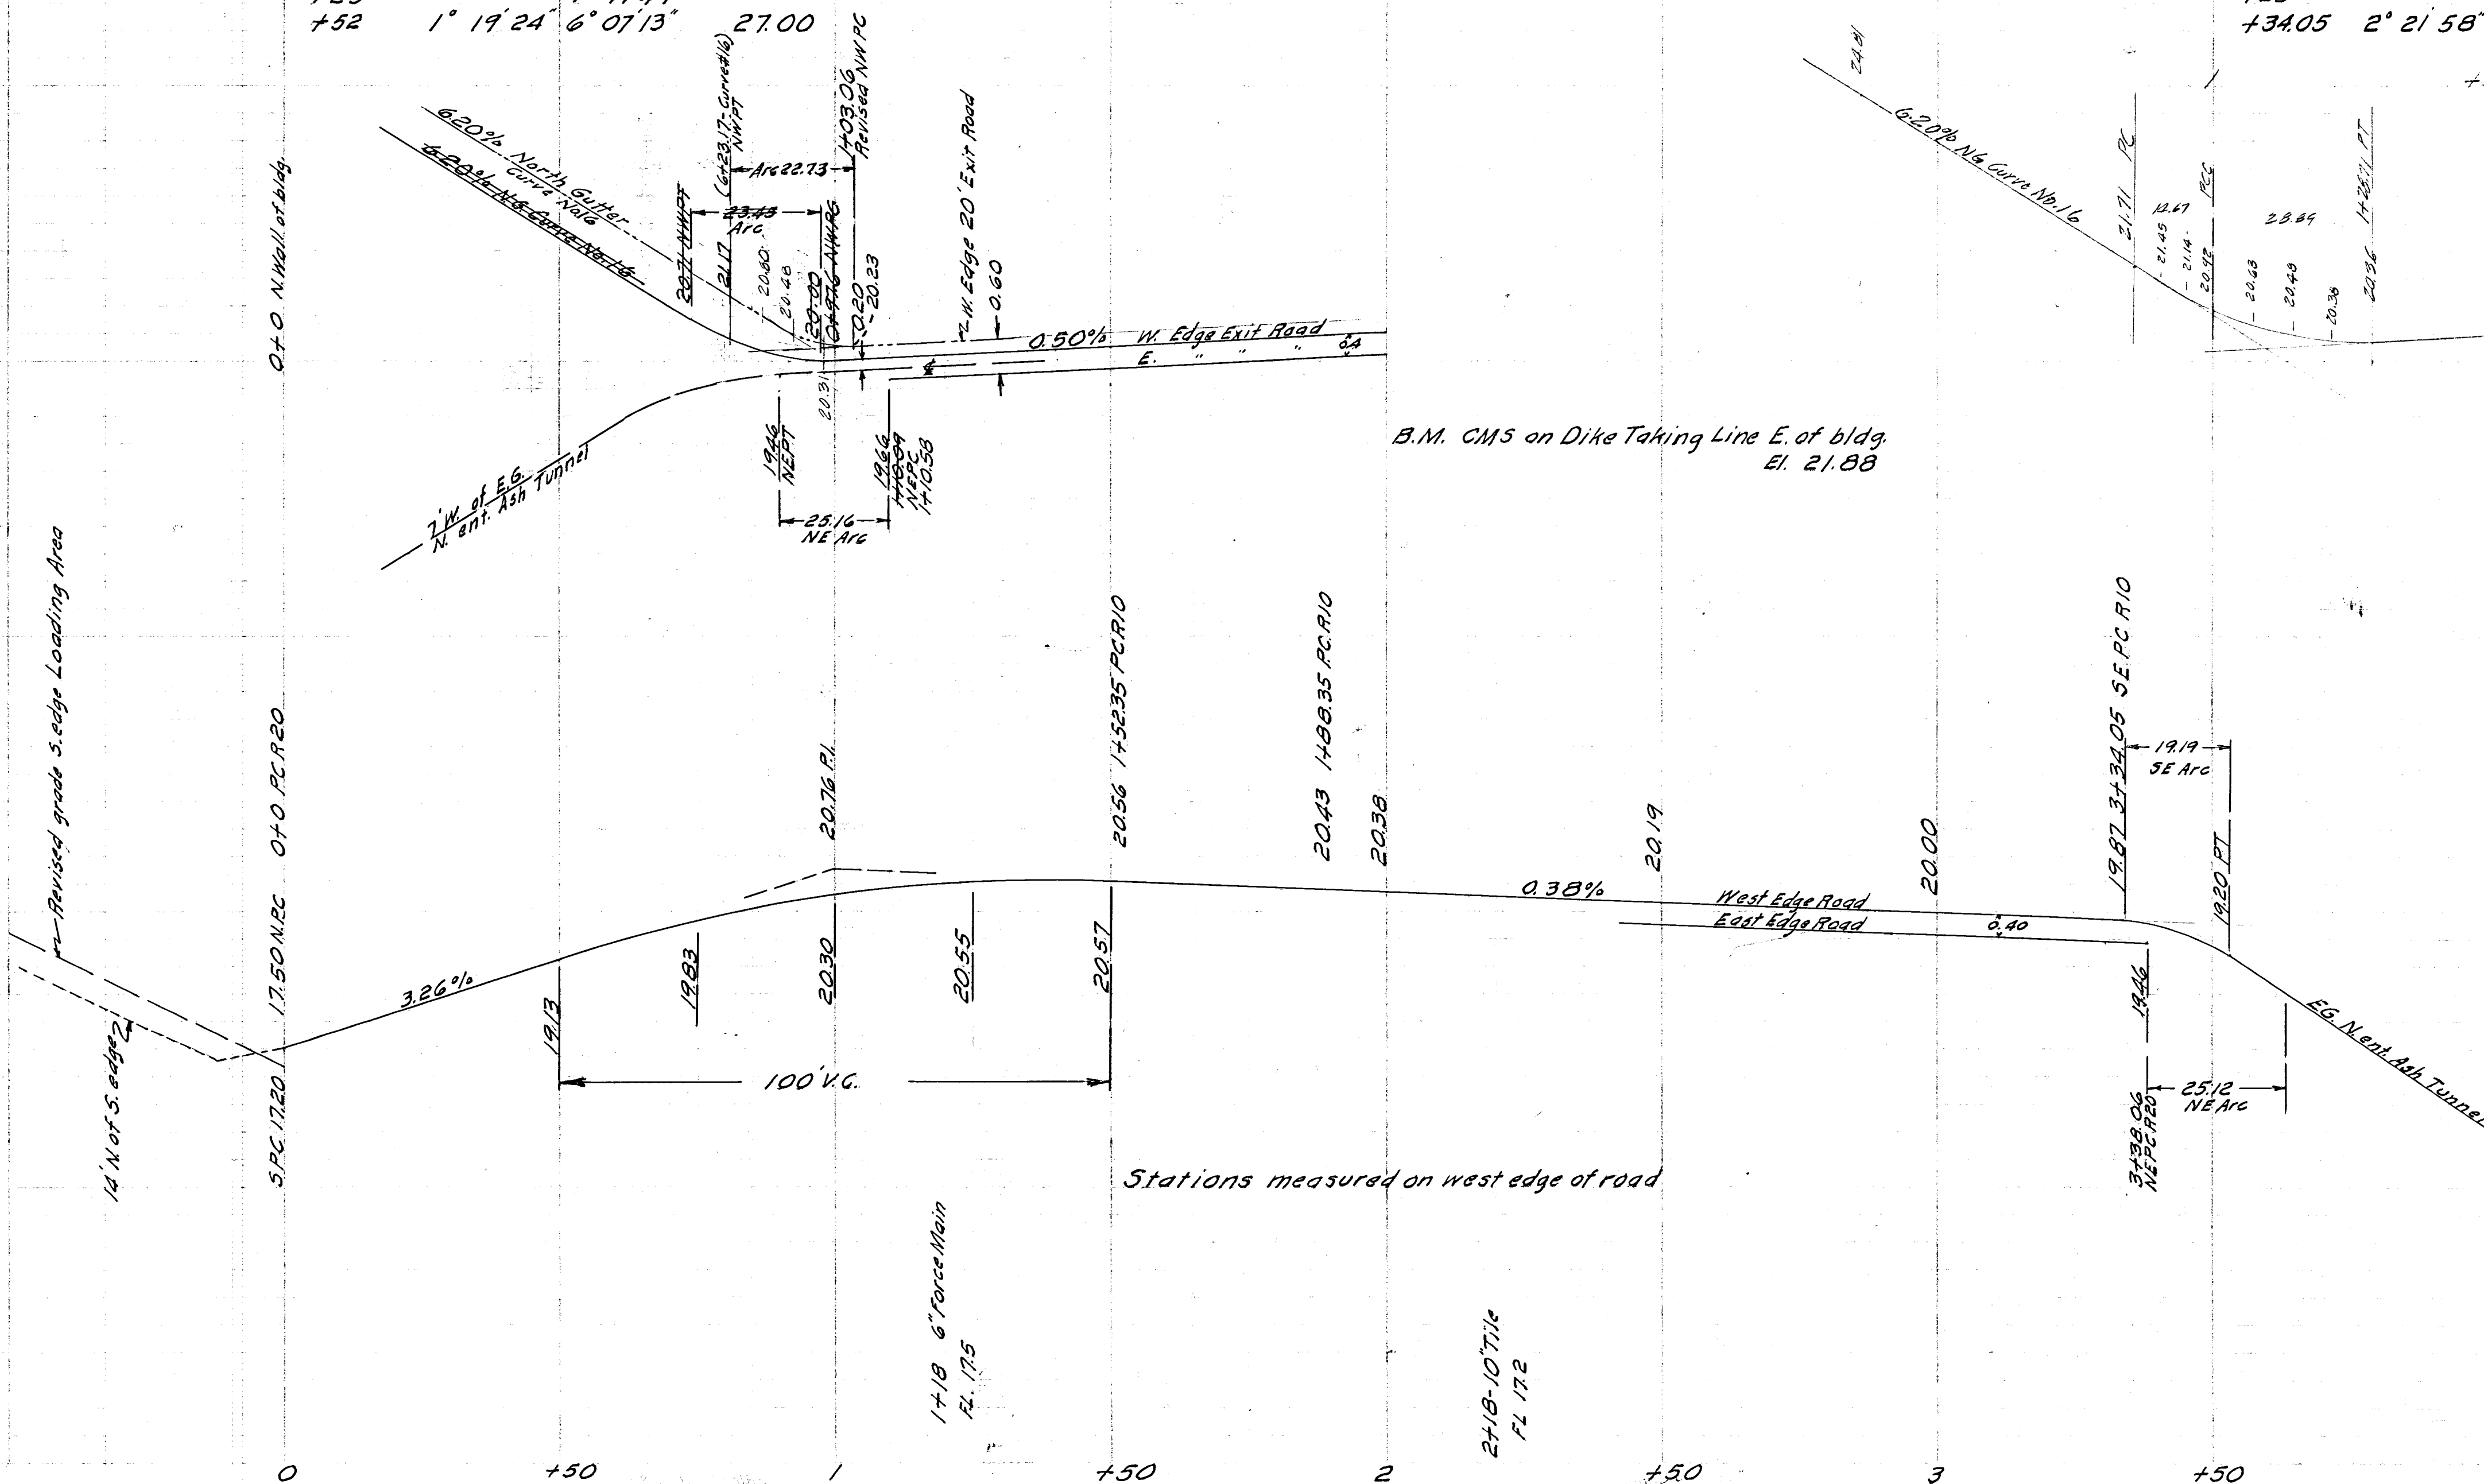

CITY OF HARTFORD
 DEPARTMENT OF ENGINEERING
 SCALES H. 1"=20' FEBRUARY 1954
 V. 1"=2'

DAYBOOK No. 09524