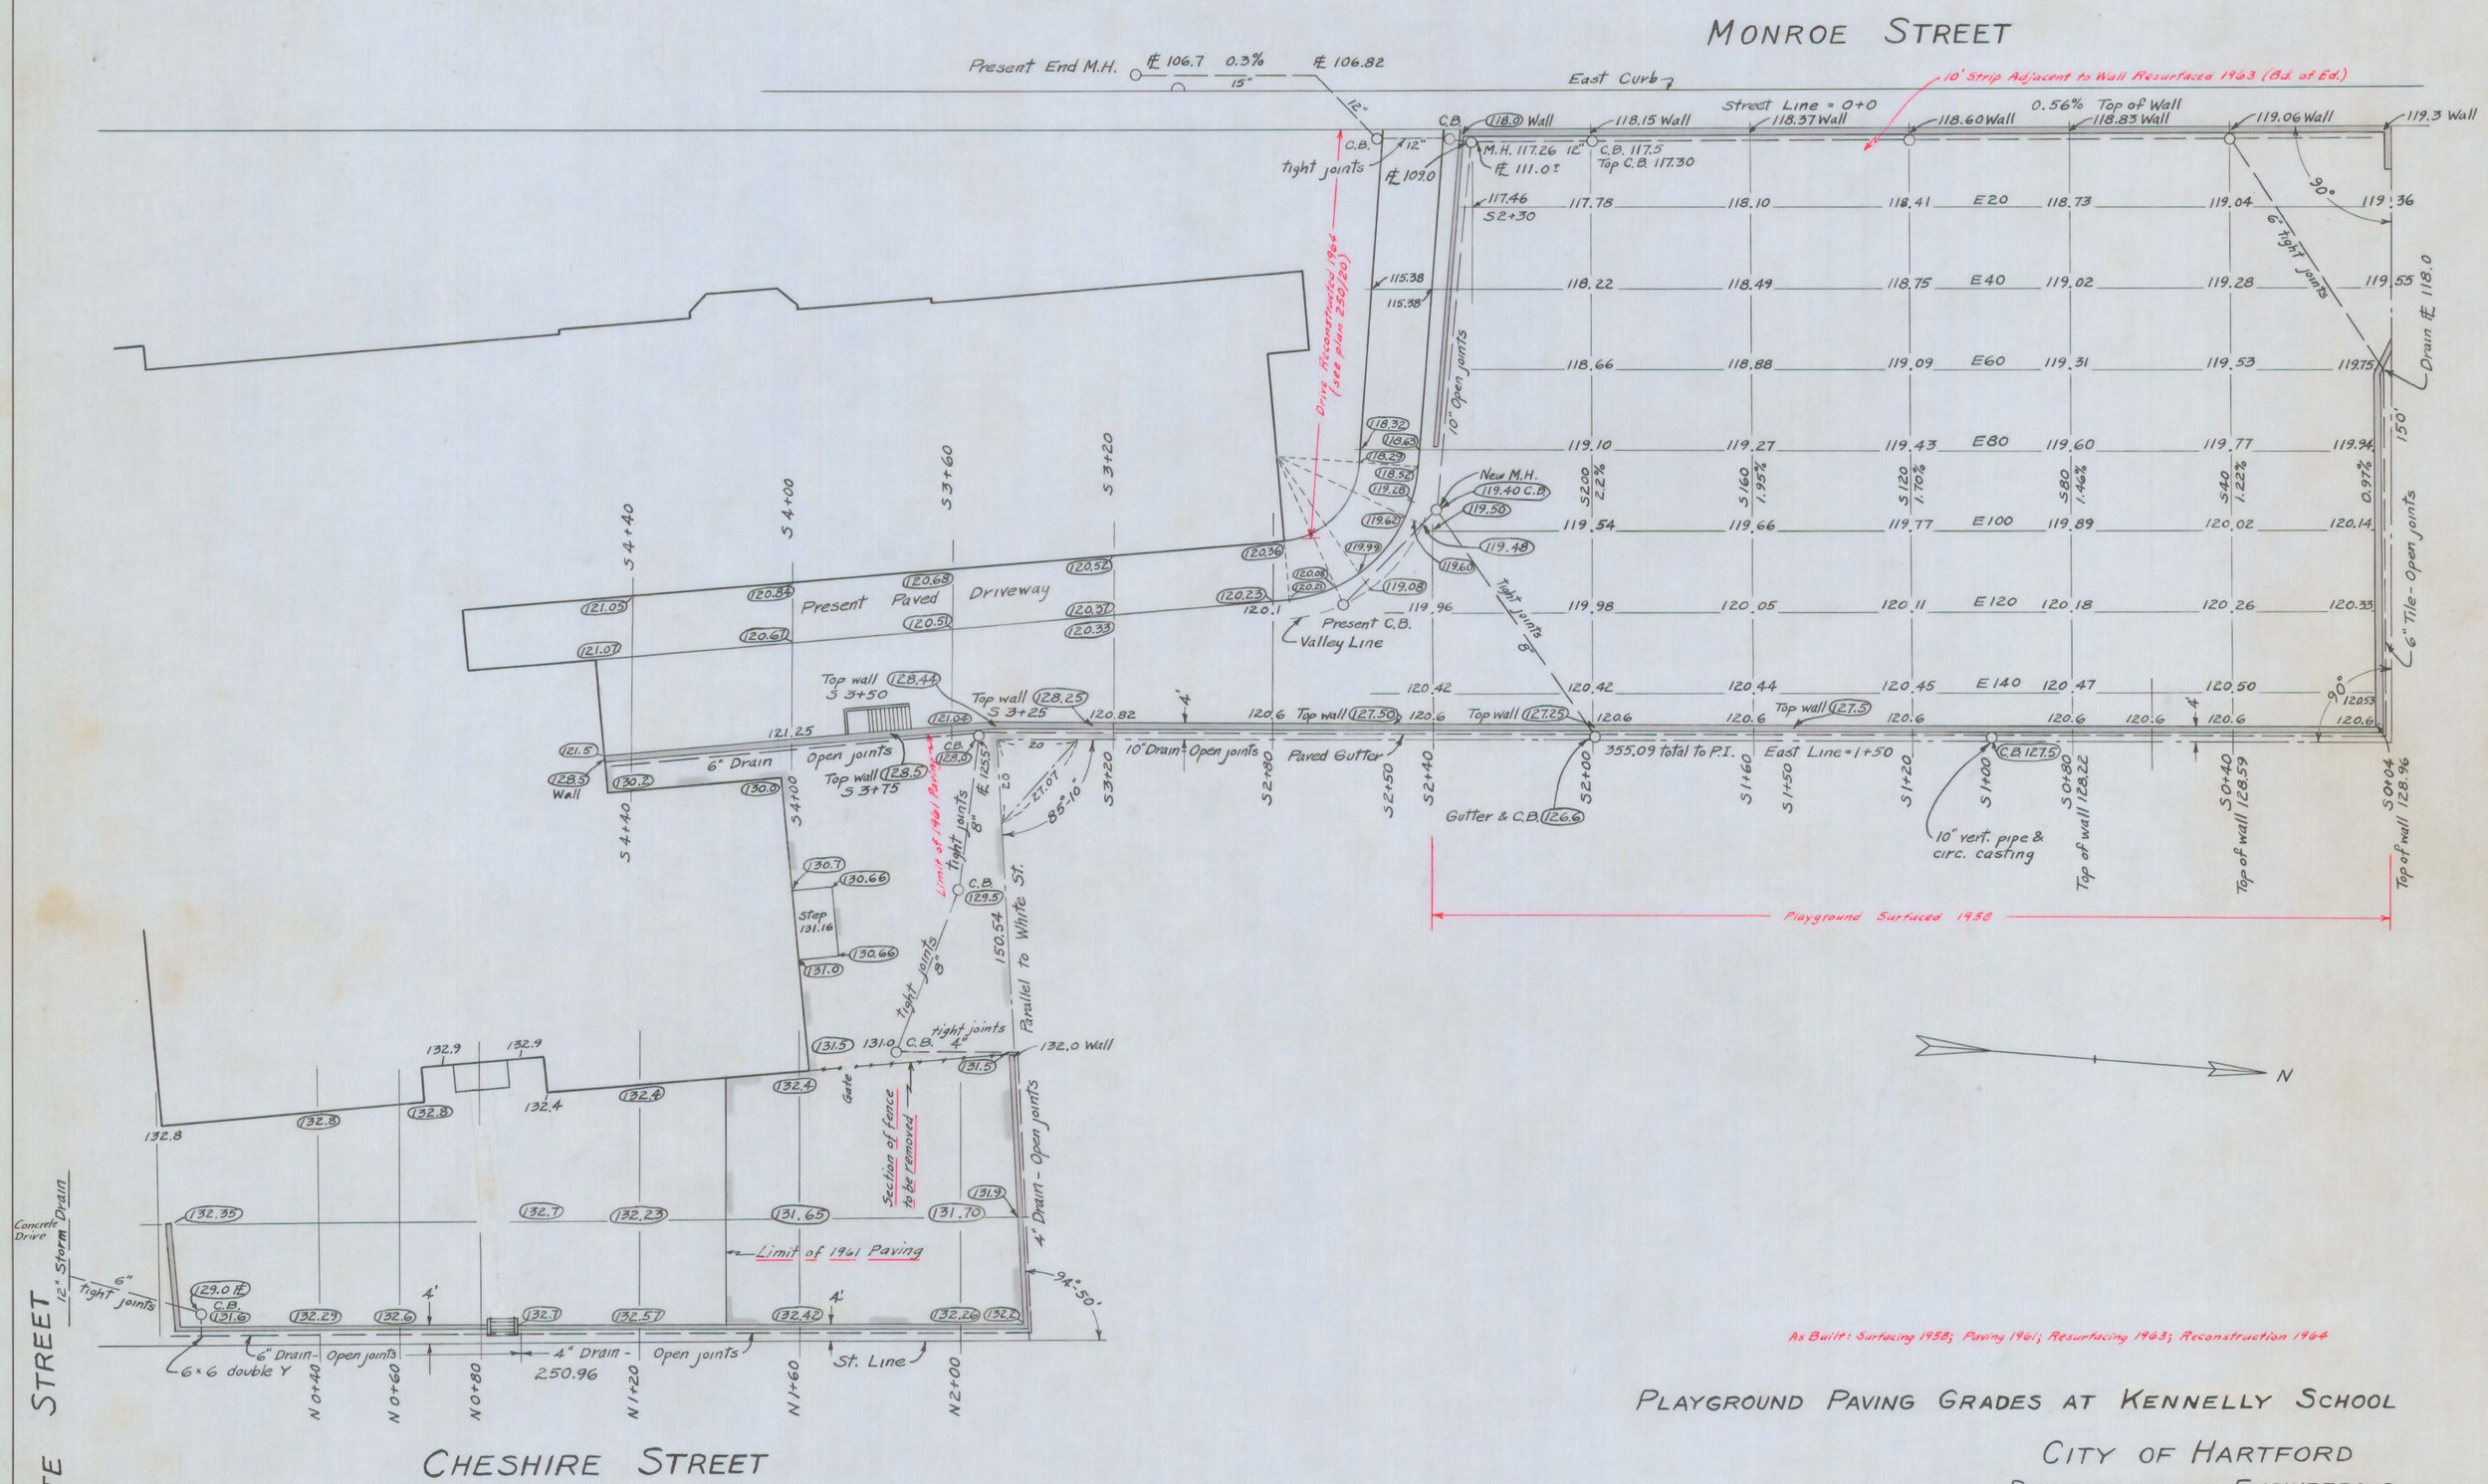

Note: This plan traced from paper tracing dated October 1939.

Elevations refer to work done in 1938

As Built: Surfacing 1958; Paving 1961; Resurfacing 1963; Reconstruction 1964

PLAYGROUND PAVING GRADES AT KENNELLY SCHOOL

CITY OF HARTFORD

DEPARTMENT OF ENGINEERING

SCALE 1" = 20' JULY 1958

DAYBOOK NO. 09552