



532


SHELDON ST.

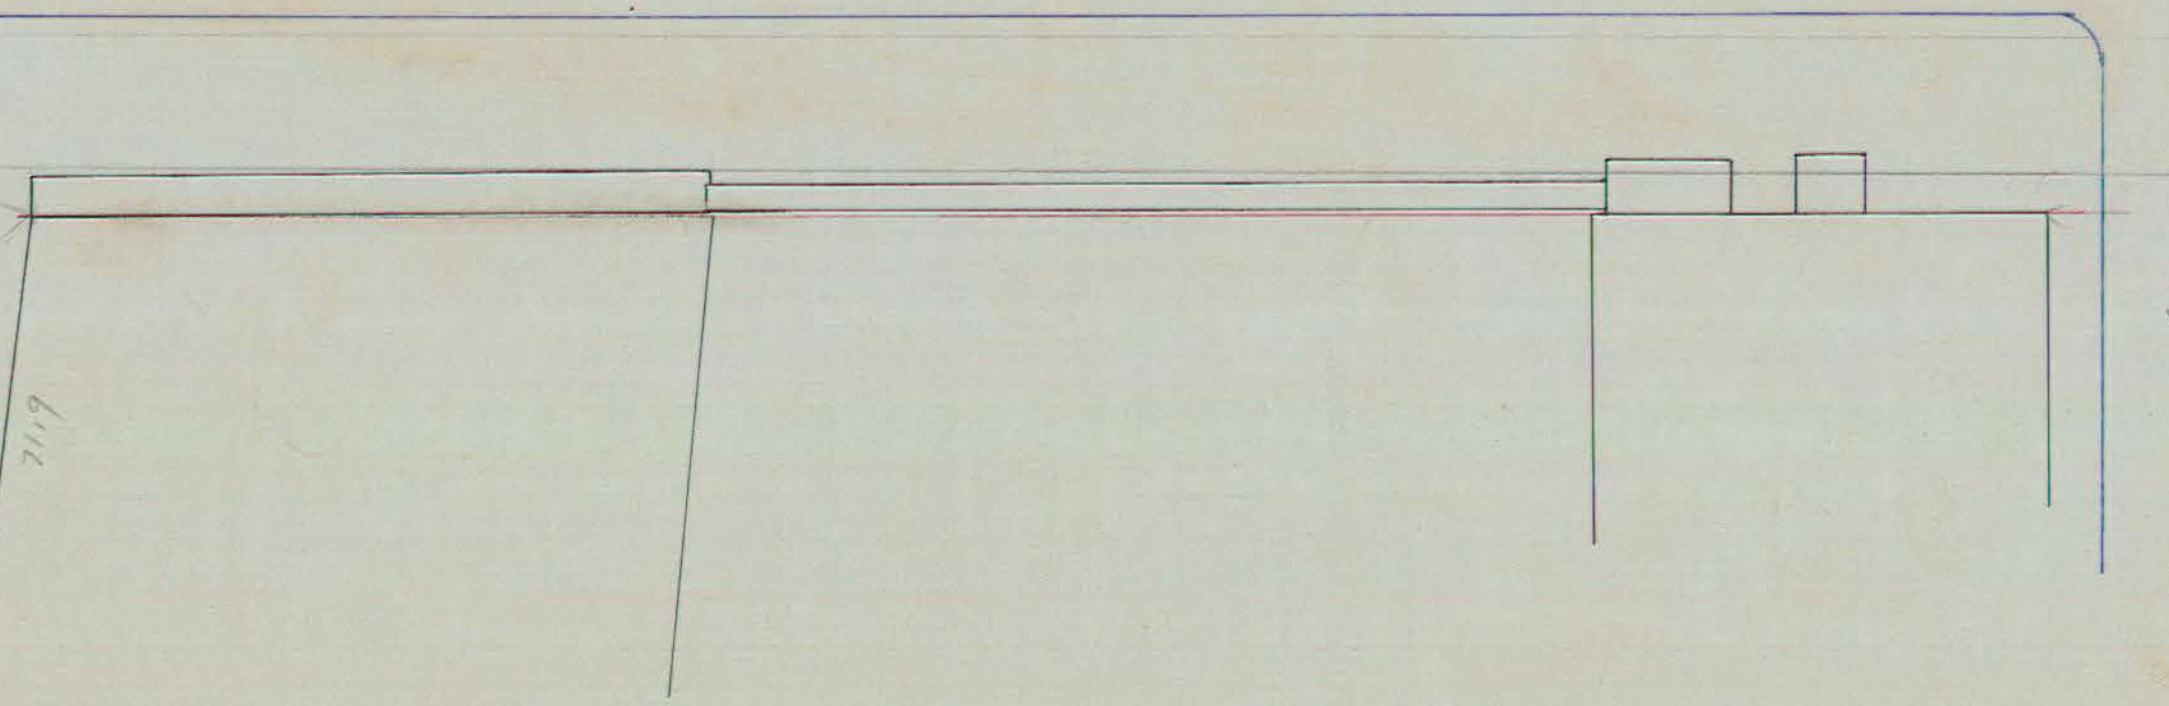


ARCH STREET

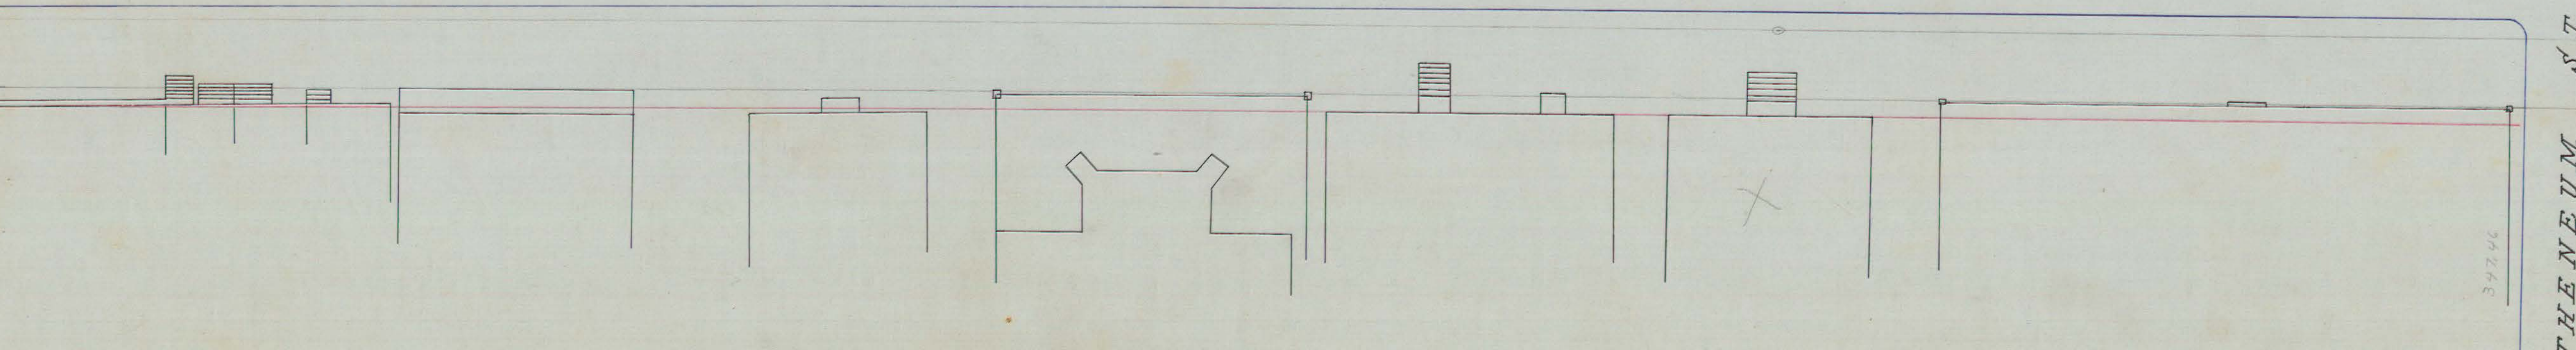

ATHENAEUM ST.

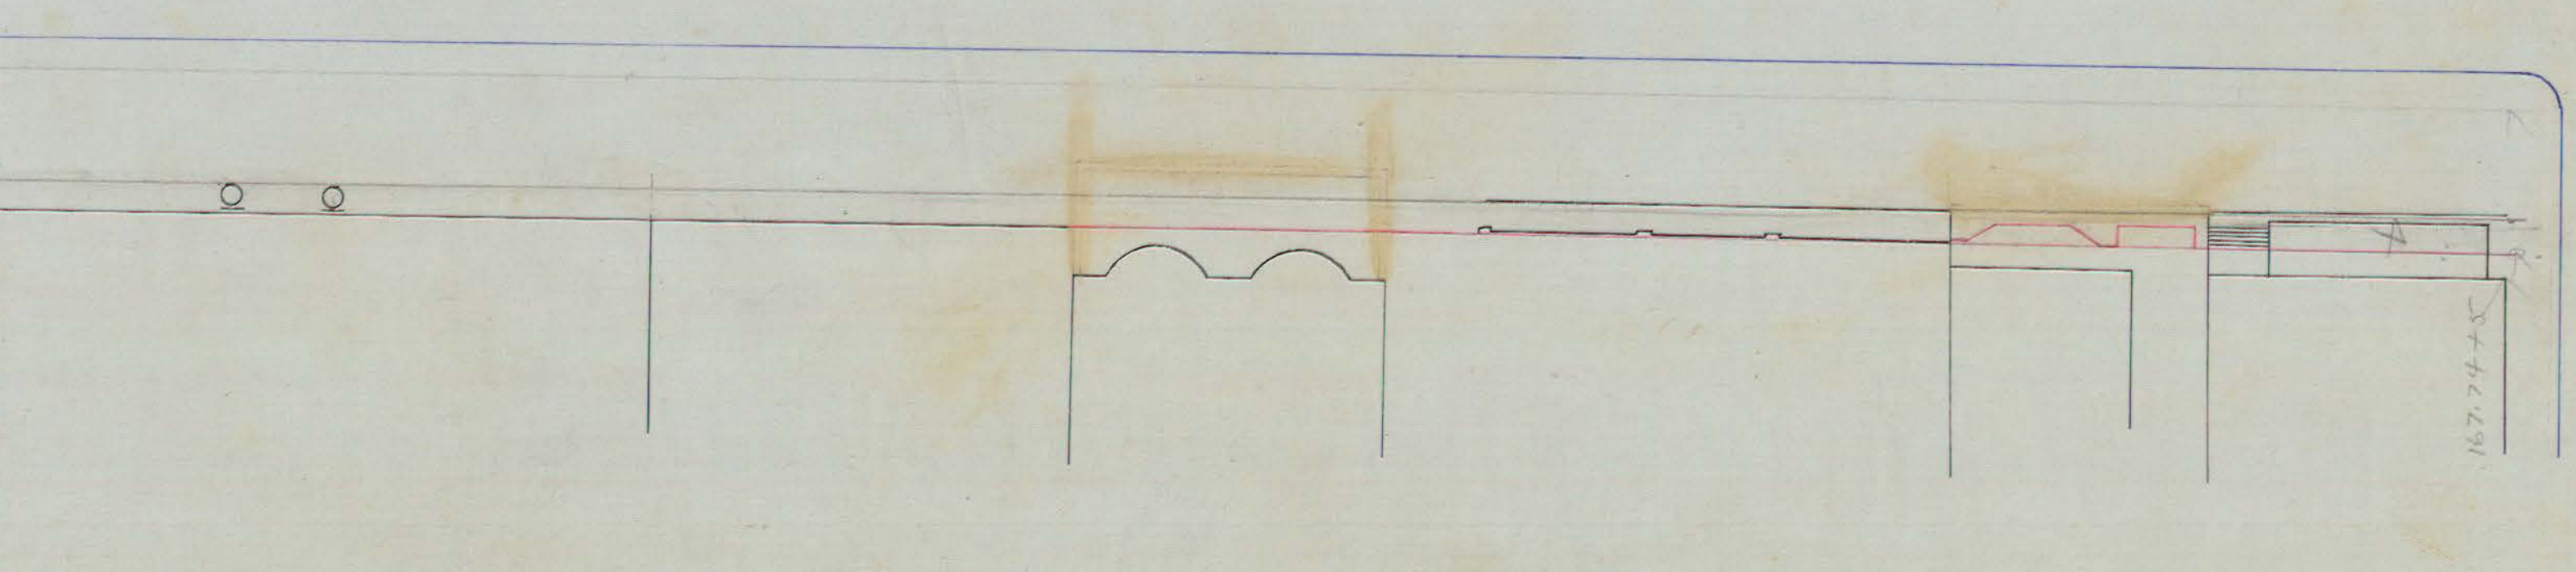

GROVE STREET

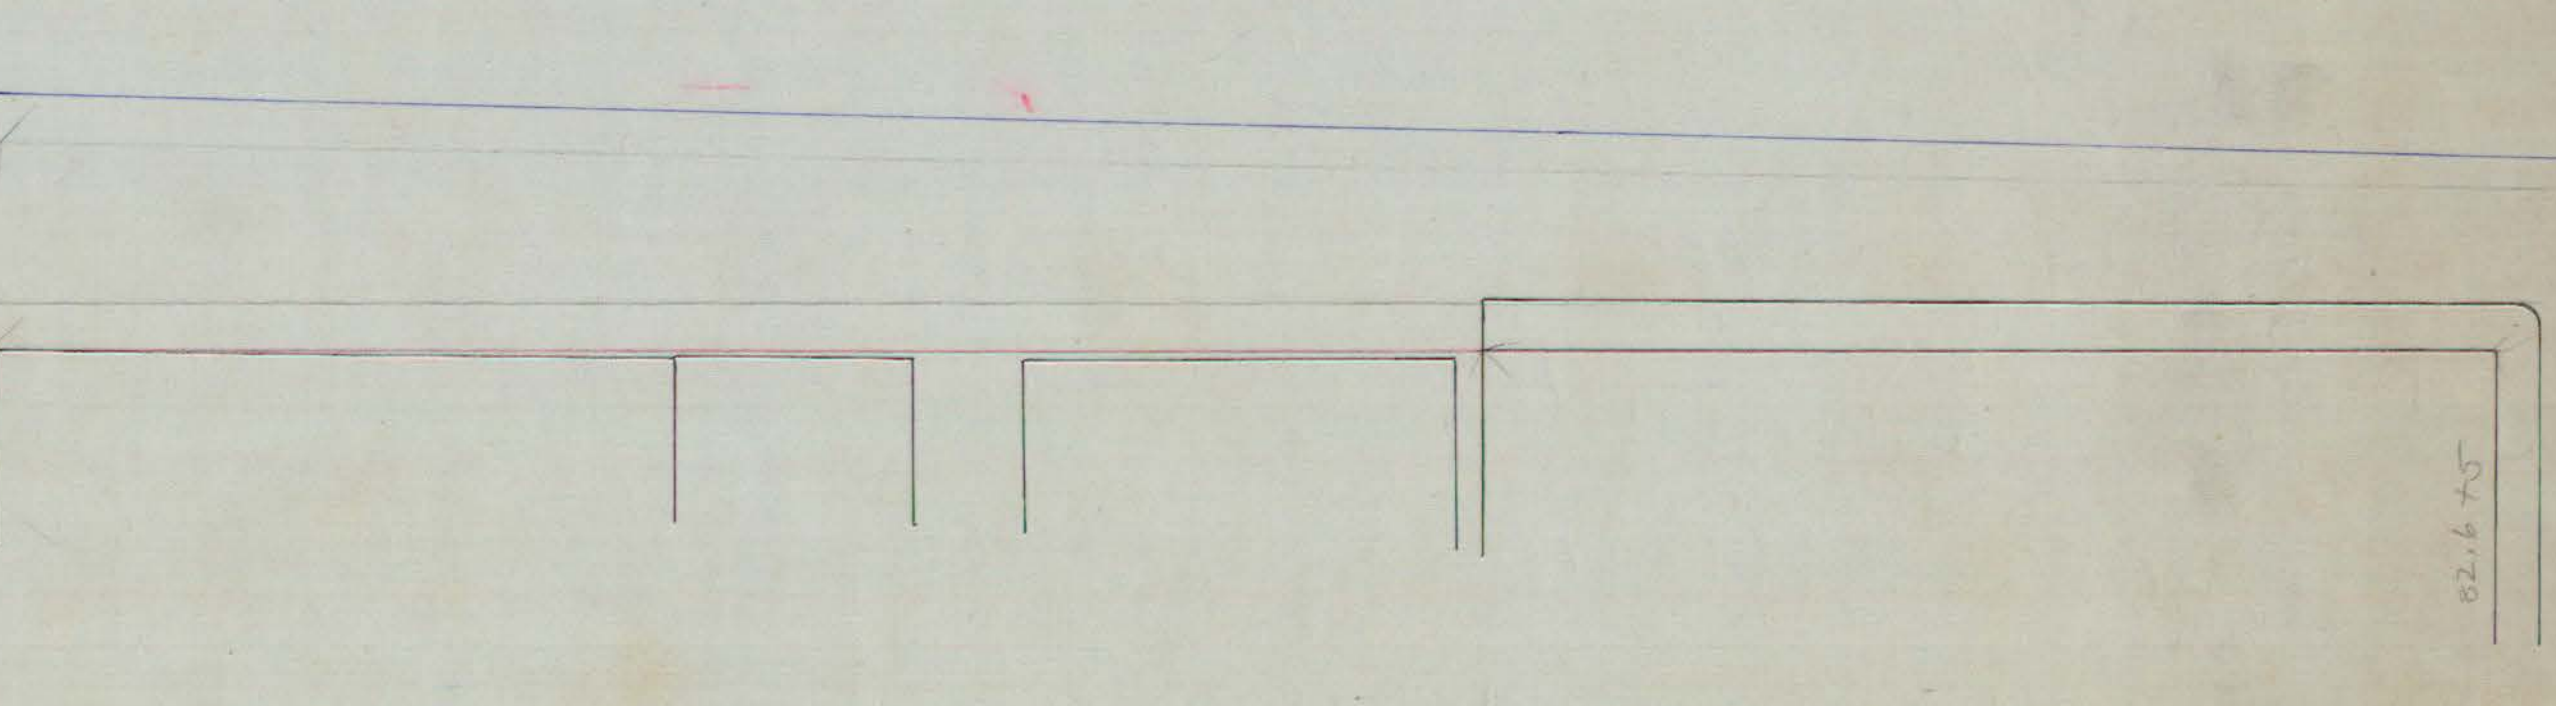

8' W. of S.W. cor. Str. fm. on West level.

new line is 4.86 outside of old

new line is 4.86 outside of old

old line 3' 3\"/>

8' W. of straight brn. str. front of Times Bldg. meas. at rd. L.S.

5 ft. W. of Trust Co. Bldg. at level of sidewalk light

532

OFFICE OF CITY ENGINEER
HARTFORD, CONN.
Date _____ Day Book No. 01452
Notes _____
City Engineer _____