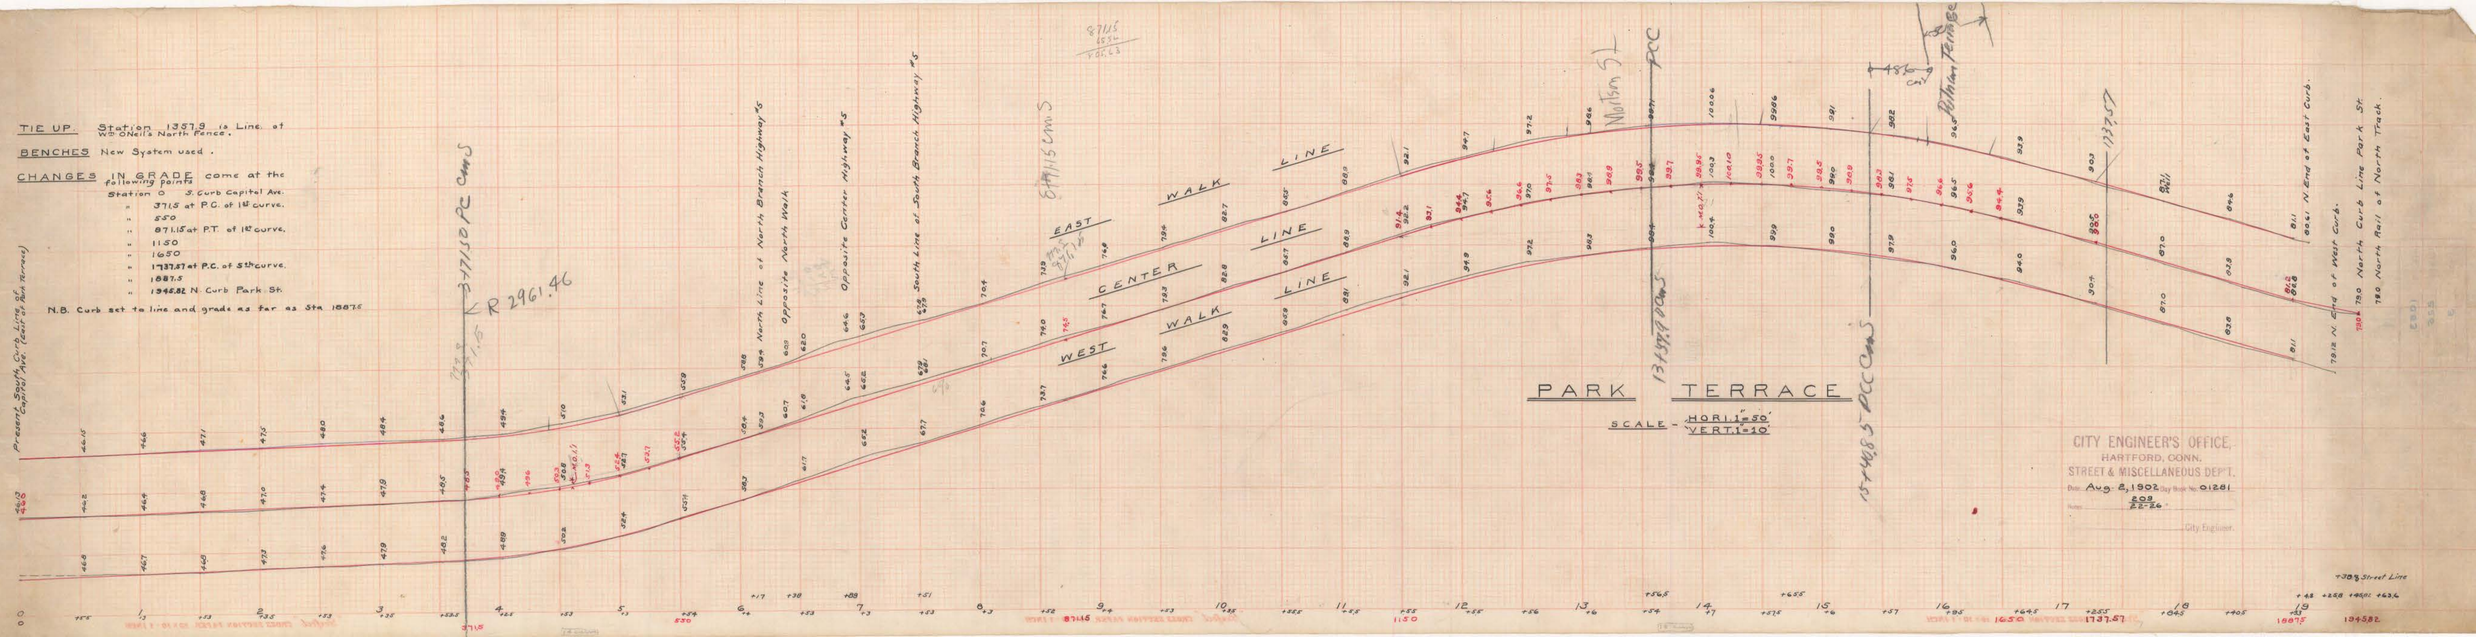
TIE UP Station 1357.9 is Line of McCNeil's North Fence.
BENCHES New System used.
CHANGES IN GRADE come at the following points
Station 0 S. Curb Capitol Ave.
" 37.15 at P.C. of 18° curve.
" 550
" 871.15 at P.T. of 18° curve.
" 1150
" 1650
" 1737.57 at P.C. of 5° curve.
" 1887.5
" 1362.82 N. Curb Park St.
N.B. Curb set to line and grade as far as Sta 1887.5
Present Capitol Ave. S. Curb Line (Point of Reference)
37.15 PC
R 296.46
North Line of North Branch Highway #5
Opposite North Walk
Opposite Center Highway #5
South Line of South Branch Highway #5
EAST WALK LINE
CENTER LINE
WEST WALK LINE
Nutson St
PCC
1737.57 PCC
1348.5 PCC
Pitkin Terrace
1337.57
PARK TERRACE
SCALE - HORI. 1" = 50'
VERT. 1" = 10'
CITY ENGINEER'S OFFICE,
HARTFORD, CONN.
STREET & MISCELLANEOUS DEPT.
Date Aug. 8, 1902 Day Book No. 01281
Notes 209 22-26
City Engineer
Clev. 40