
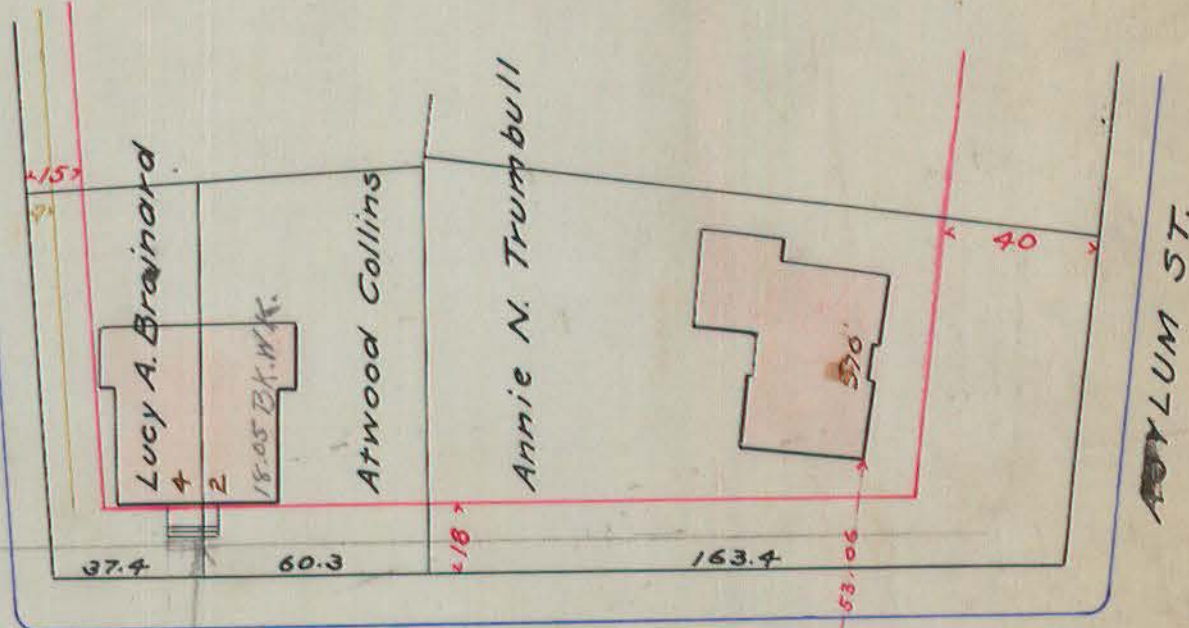


ATWOOD ST

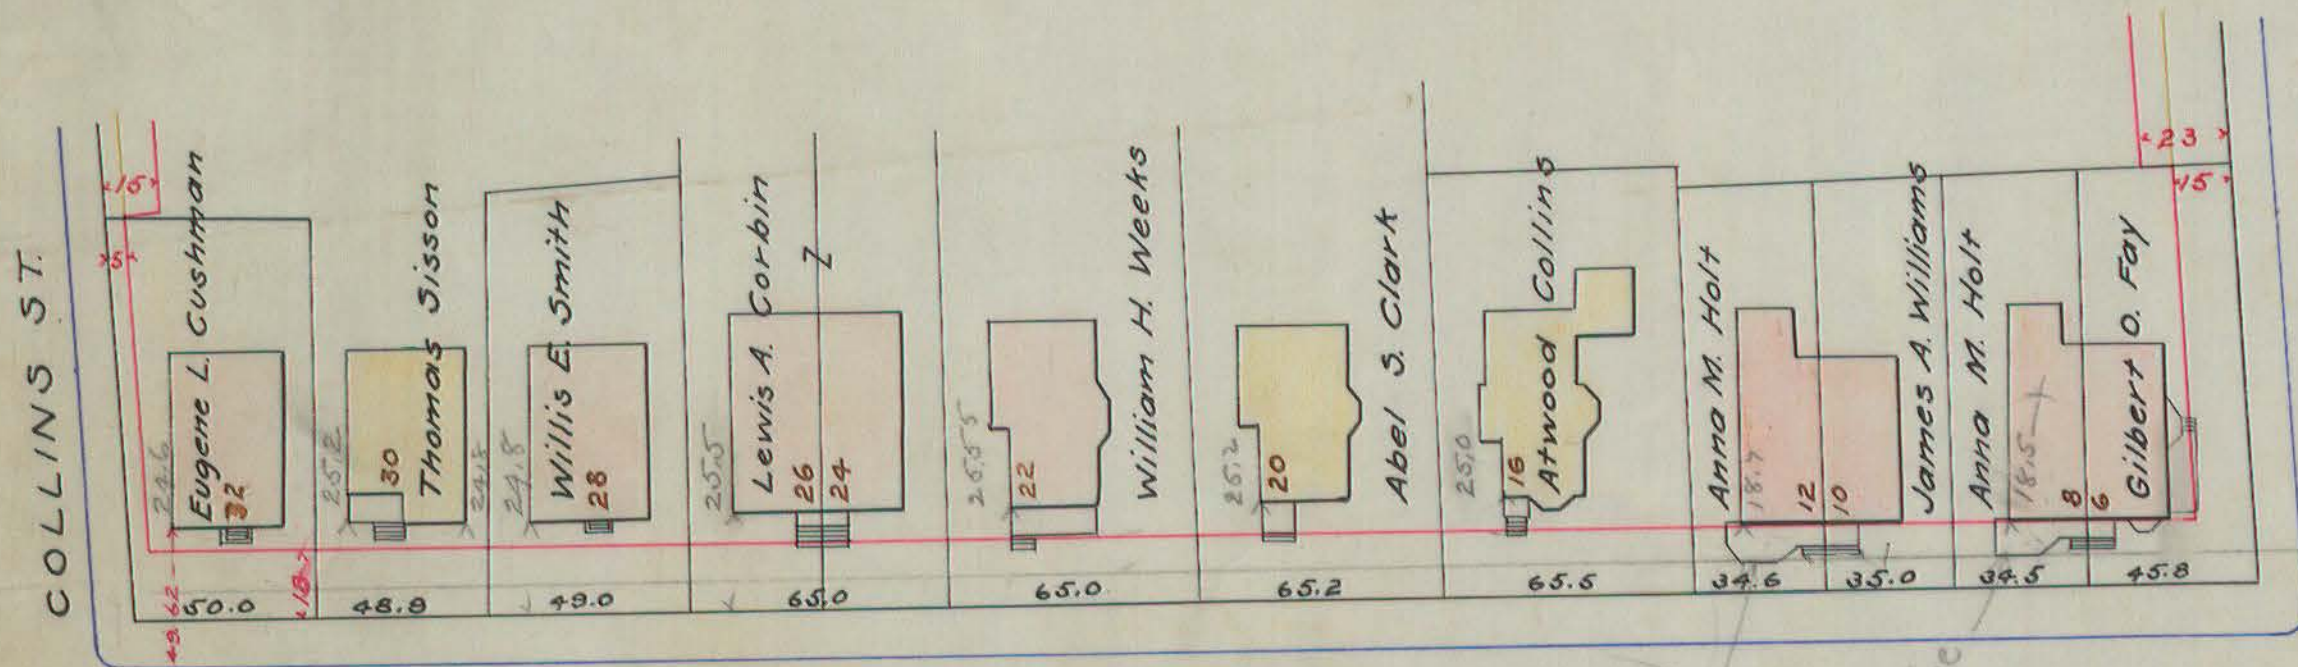

8A
532

Step 6" back of
18" Bldg line

Veranda on 10' line

Veranda 6" back of 10' line

10' V.

Veranda 2'-9" back of 10' line
step 9" over 10' line

OFFICE OF CITY ENGINEER
HARTFORD, CONN.
Date June 1904 Day Book No. 01605
City Engineer

8A
532