



ORPHAN ASYLUM PROPERTY

George Mortson,
Room 48, Bellerstein Bldg.




Putnam Terrace


PRESENT FENCE LINE

Division
LINE

Windsor 70003 Mary

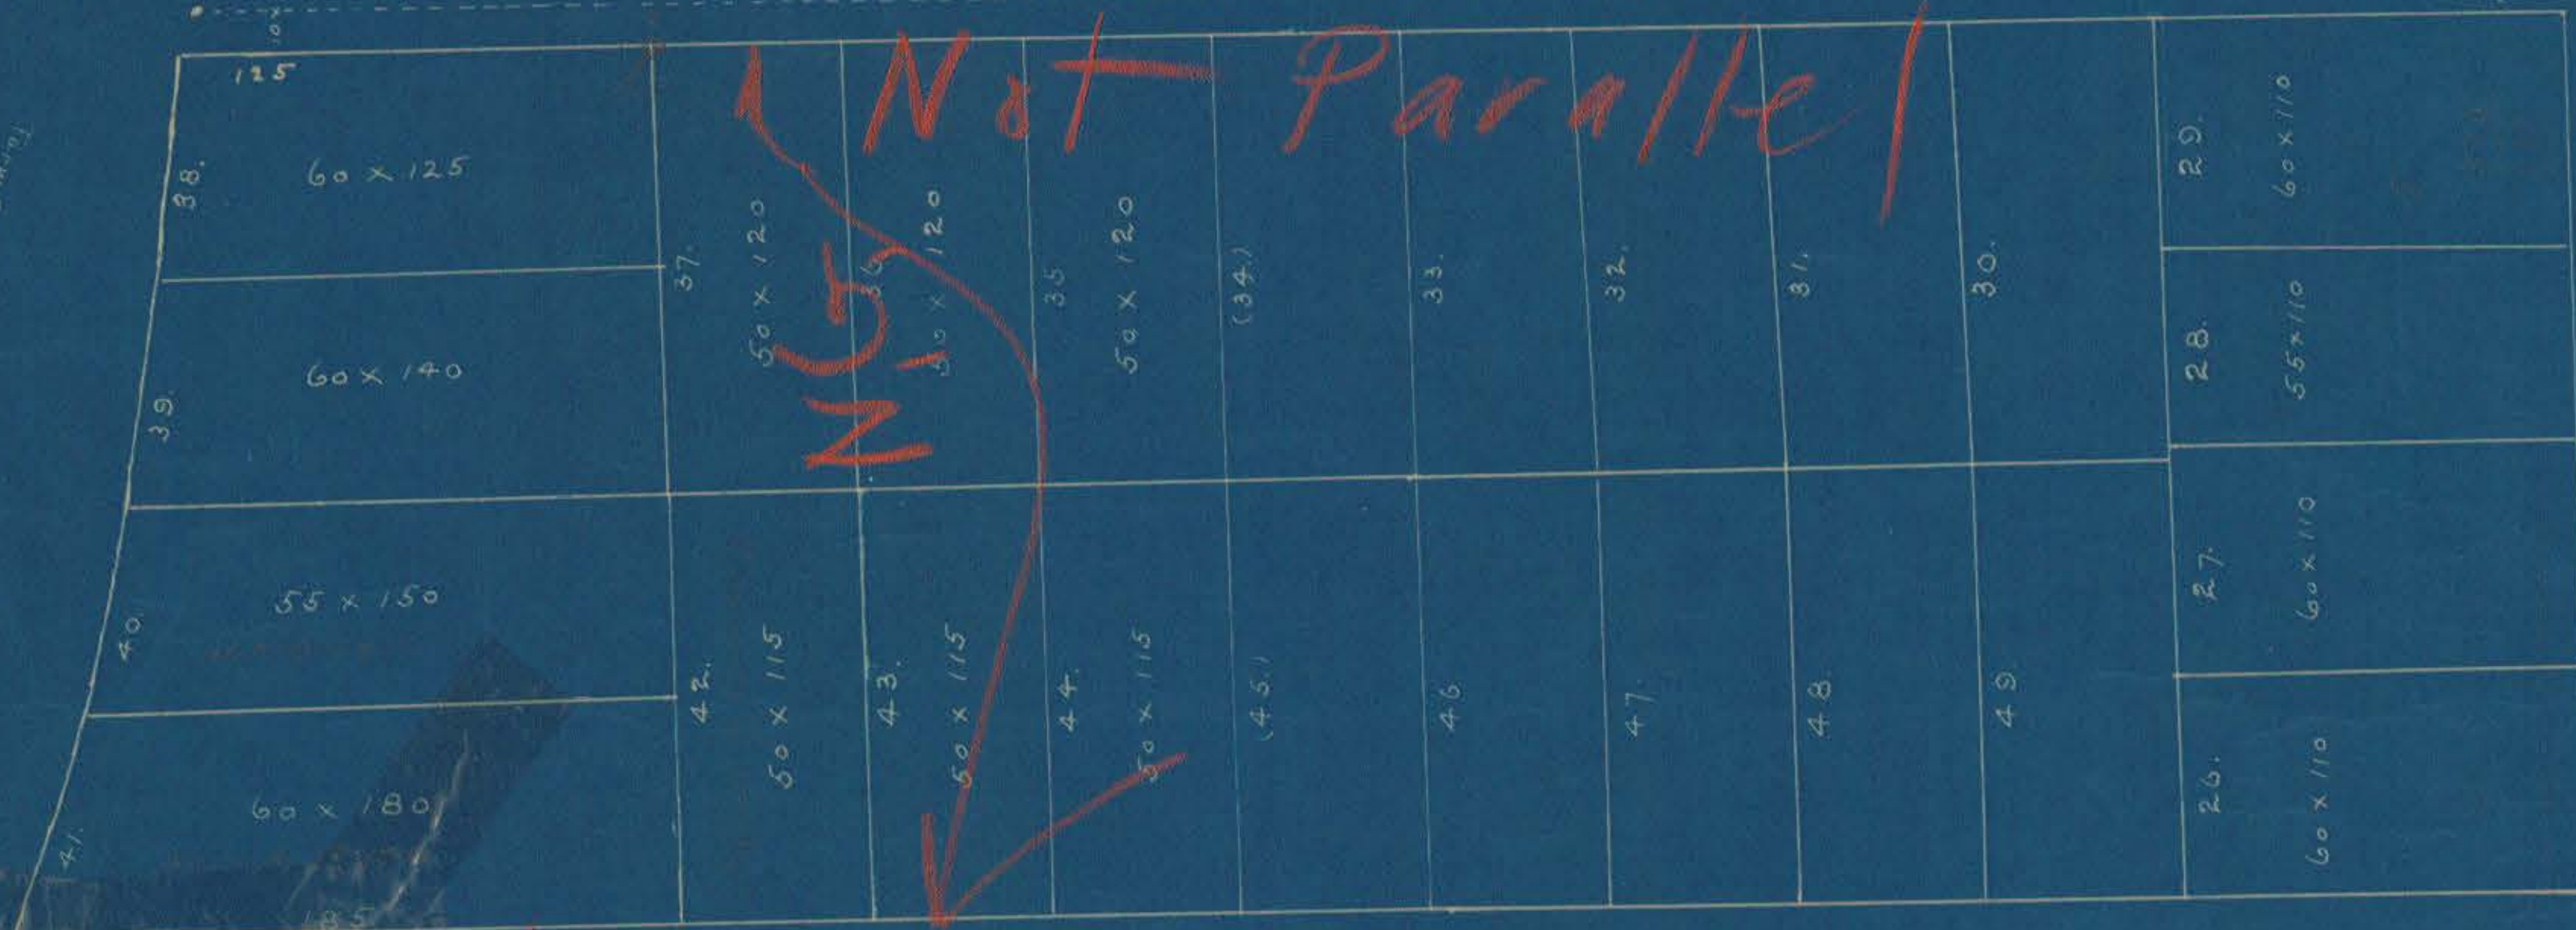

Not Parallel

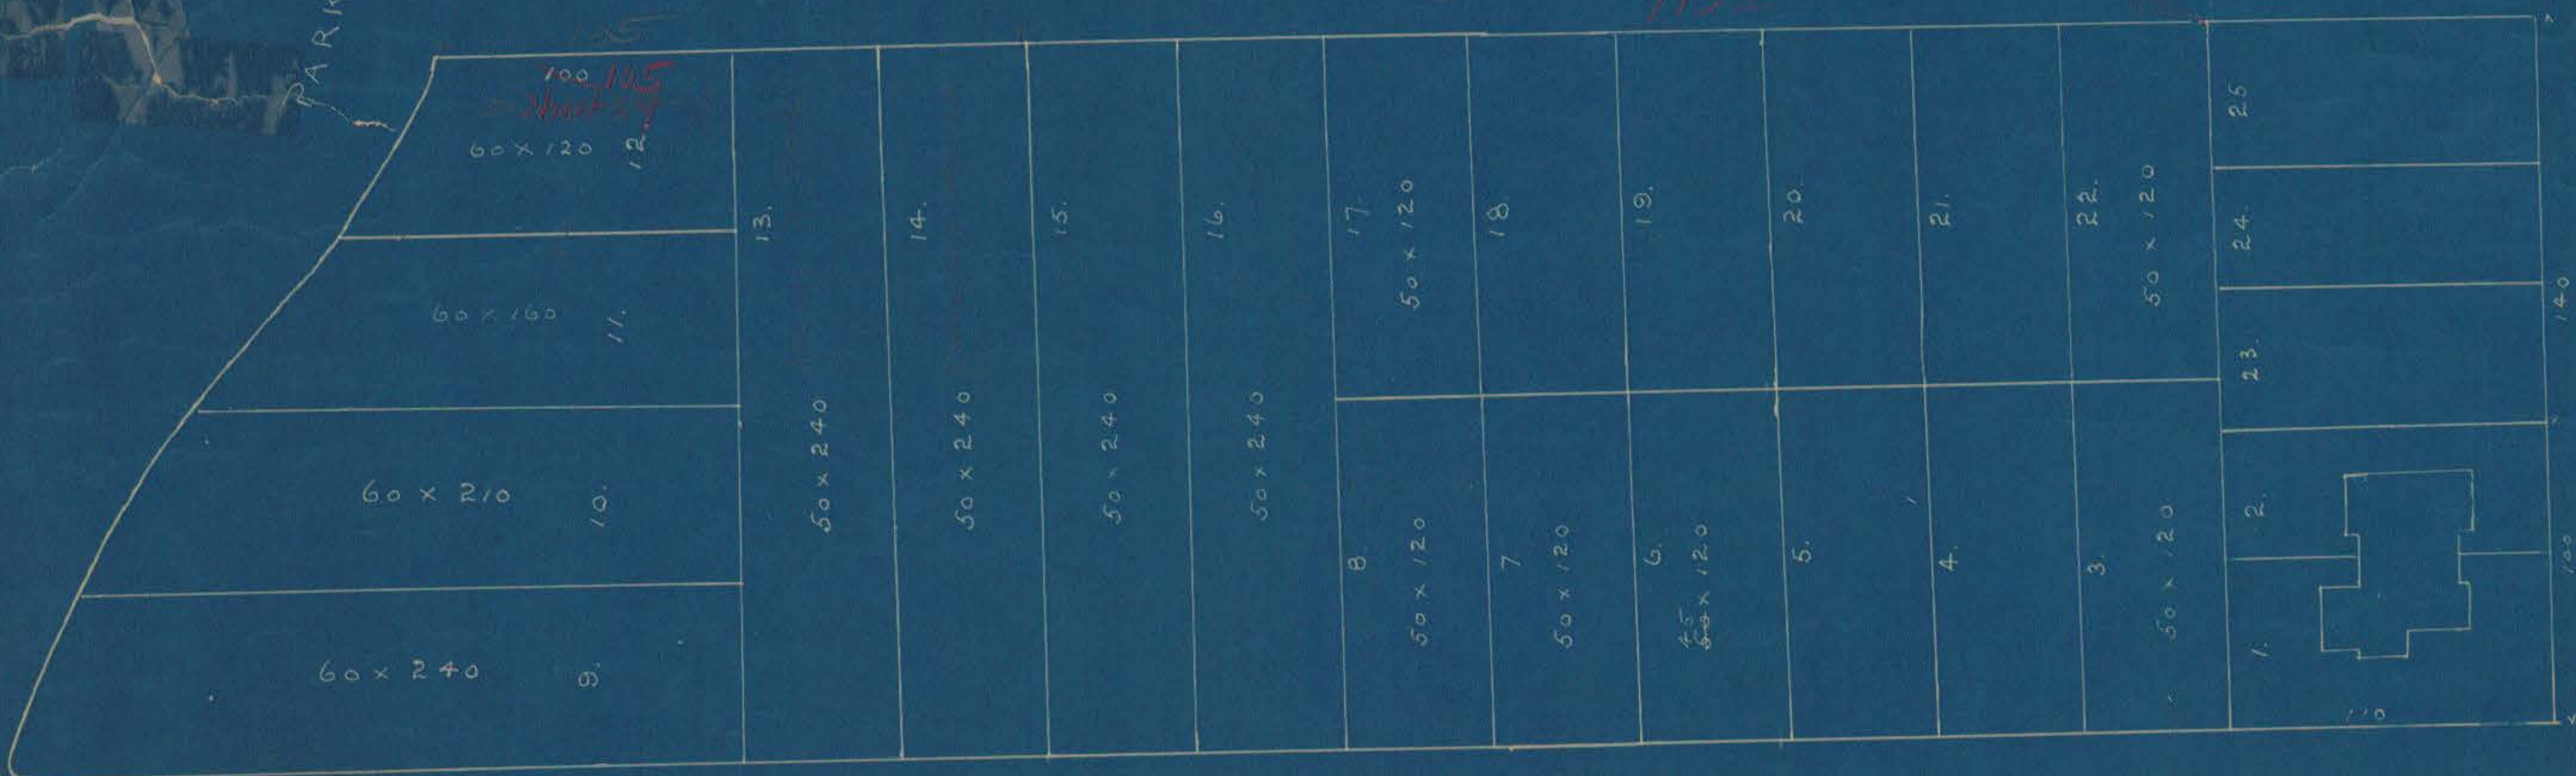

PARK STREET

PUTNAM ST.