


PROFILE OF COMMERCE ST.

POTTER ST. TO PARK RIVER.

Horizontal Scale 1"=25'

Vertical " 1"=10'

Note: Green line indicates Grade of July 1903.

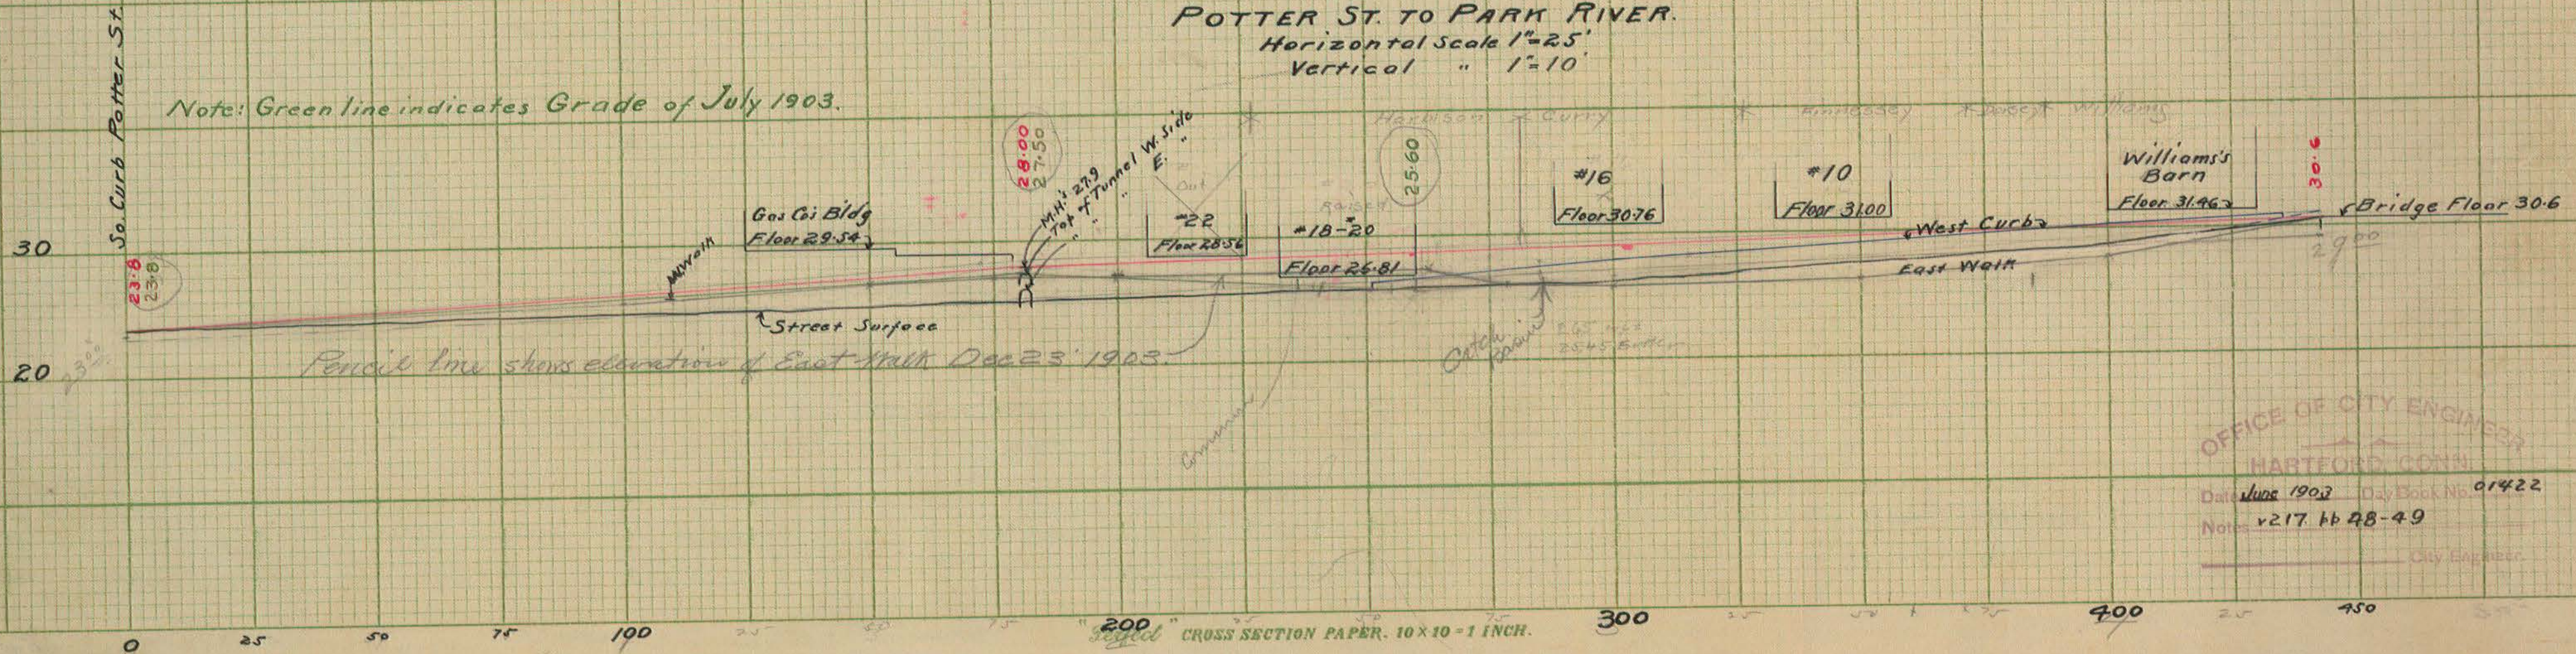

OFFICE OF CITY ENGINEER
HARTFORD, CONN.

Date June 1903 Day Book No. 01422

Notes v217. 16 48-49

City Engineer

Commerce St. Potter to Park River.