


SCALE - 1" = 5'

ALL SECTIONS FACE WEST

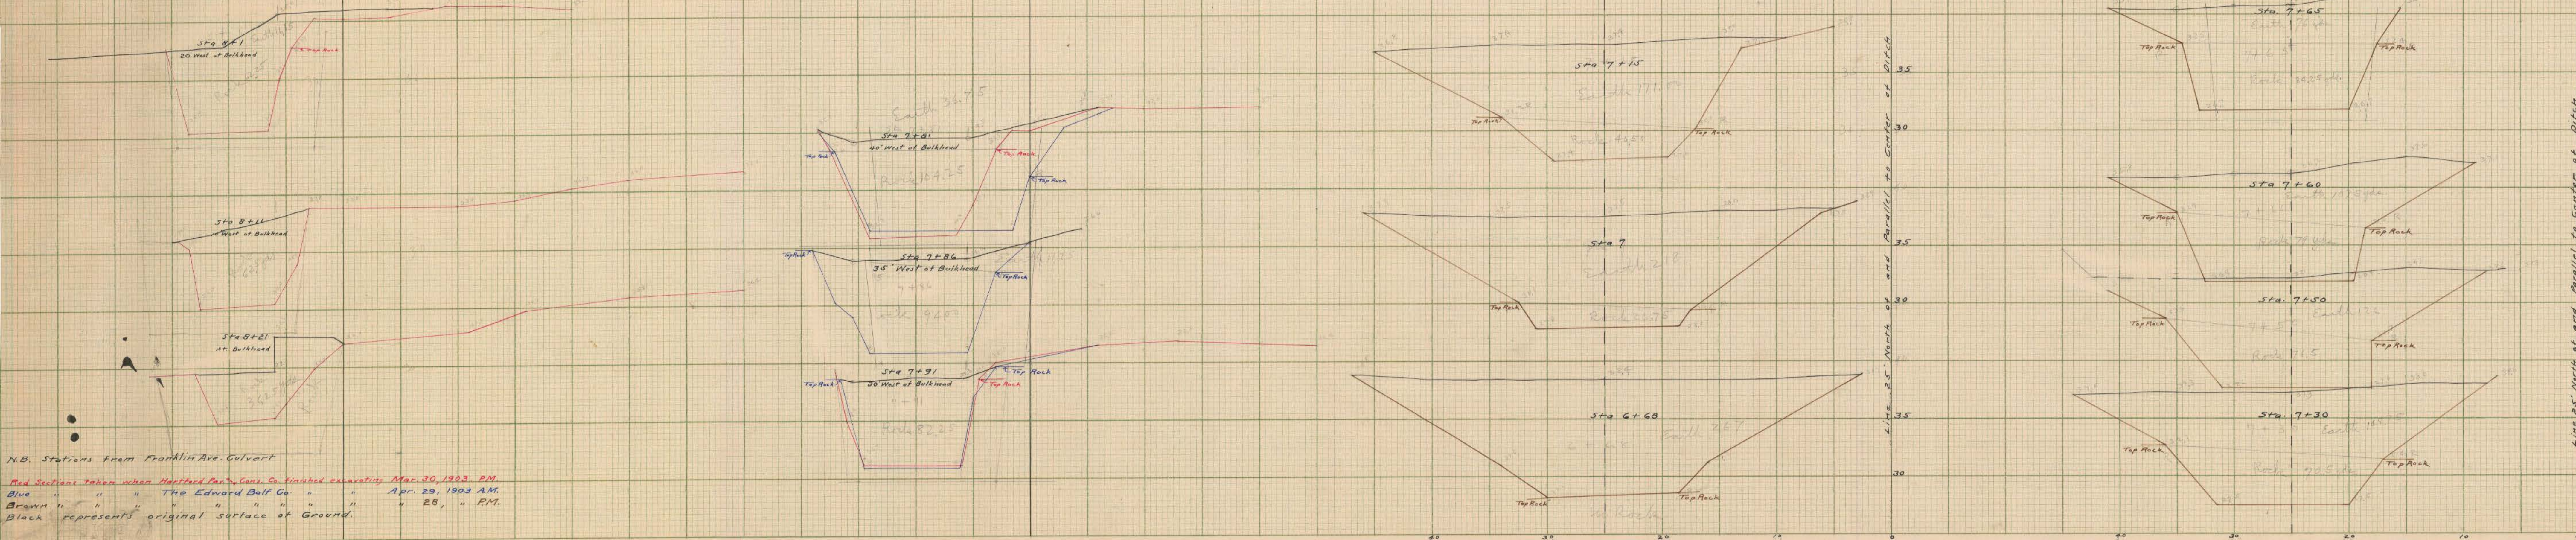

N.B. Stations from Franklin Ave. Culvert

Red Sections taken when Hartford Pav. Cons. Co. finished excavating Mar. 30, 1903. P.M.

Blue " " " The Edward Balt Co. " " Apr. 29, 1903 A.M.

Brown " " " " " " " 28, " P.M.

Black represents original surface of Ground.

OFFICE OF CITY ENGINEER
HARTFORD, CONN.
Date June 1903 Day Book No. 01429
Note 209-104
F.L. Ford City Engineer