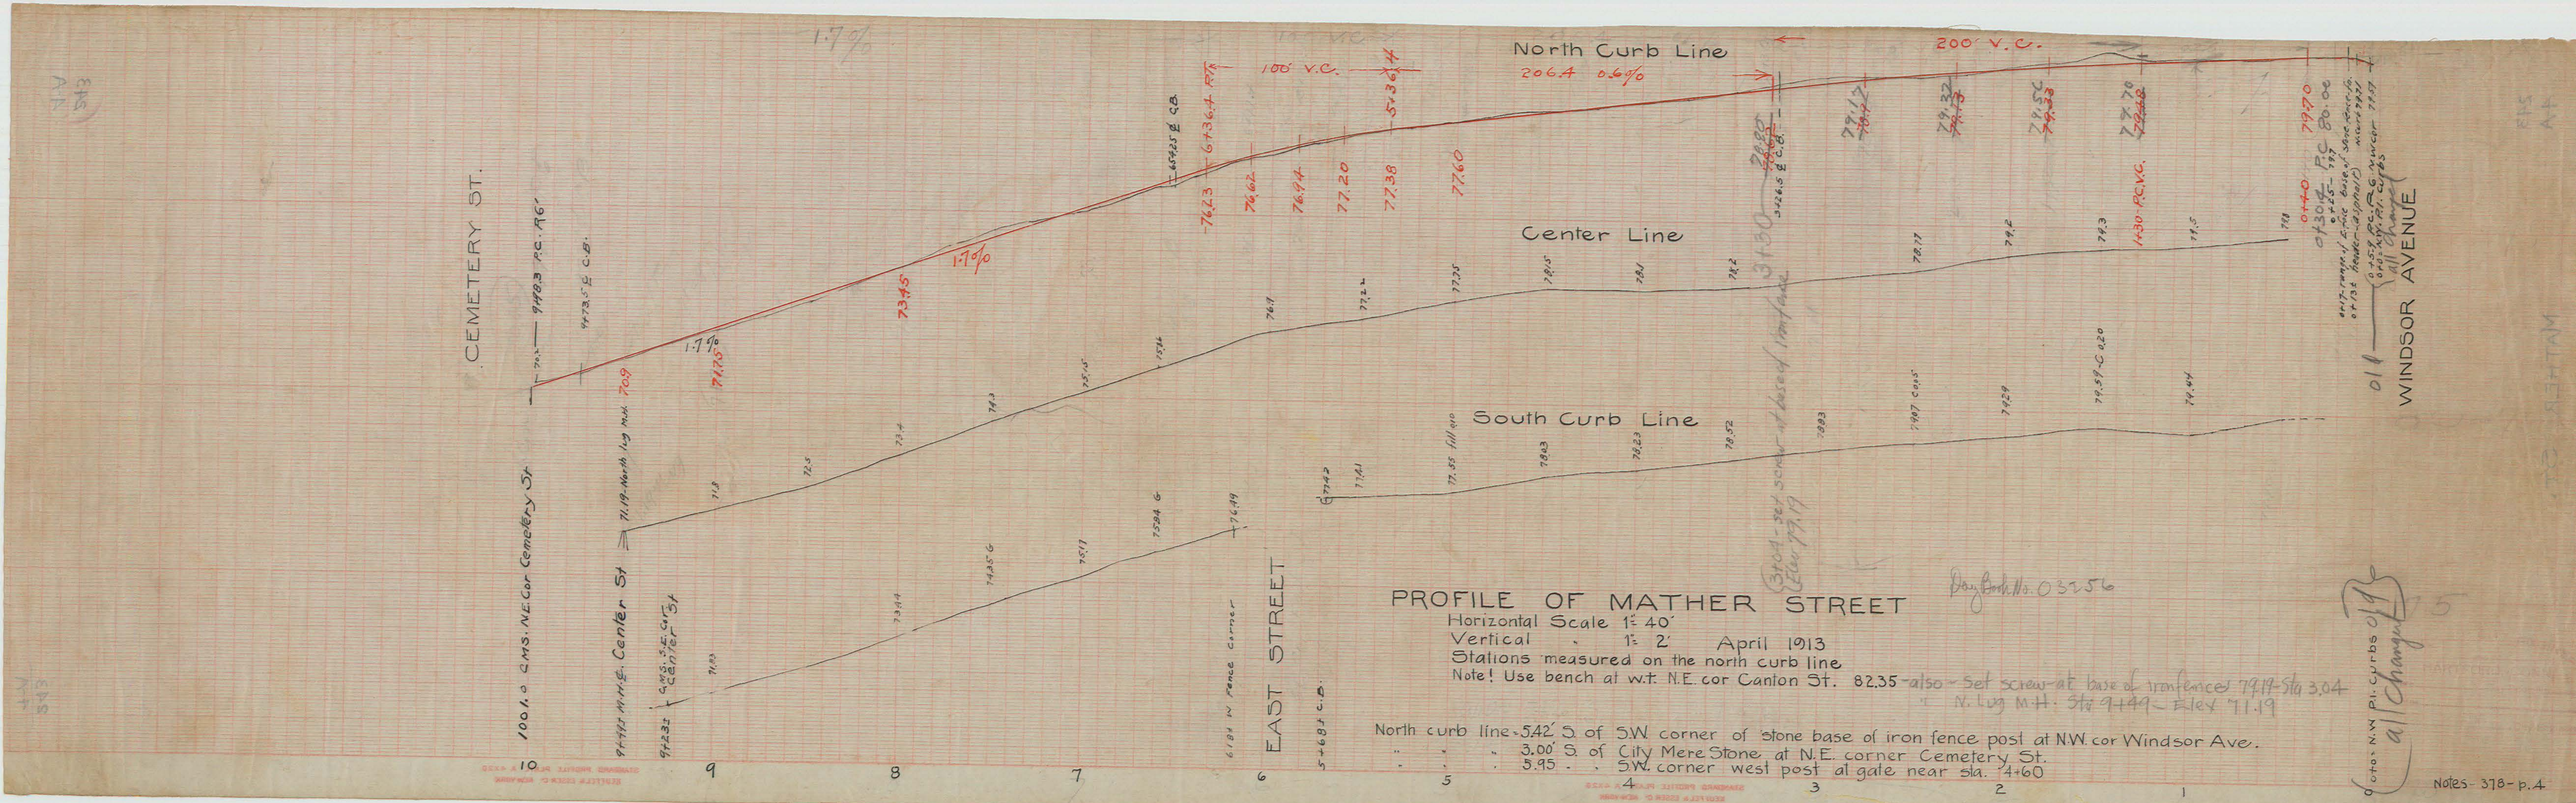
North Curb Line
Center Line
South Curb Line
CEMETERY ST.
EAST STREET
WINDSOR AVENUE
100 V.C.
200 V.C.
1.7%
206.4 0.6%
PROFILE OF MATHER STREET
Horizontal Scale 1" = 40'
Vertical " 1" = 2'
April 1913
Stations measured on the north curb line
Note! Use bench at w.t. N.E. cor Canton St. 82.35 - also - Set screw at base of ironfence 79.19 - Sta 3.04
" N. Lug M.H. Sta 9+49 - Elev 71.19
North curb line - 5.42' S. of S.W. corner of stone base of iron fence post at N.W. cor Windsor Ave.
" " " 3.00' S. of City Mere Stone at N.E. corner Cemetery St.
" " " 5.95 " " S.W. corner west post at gate near sta. 7+60
Day Book No. 03256
Notes - 378 - p. 4