


BOND ST

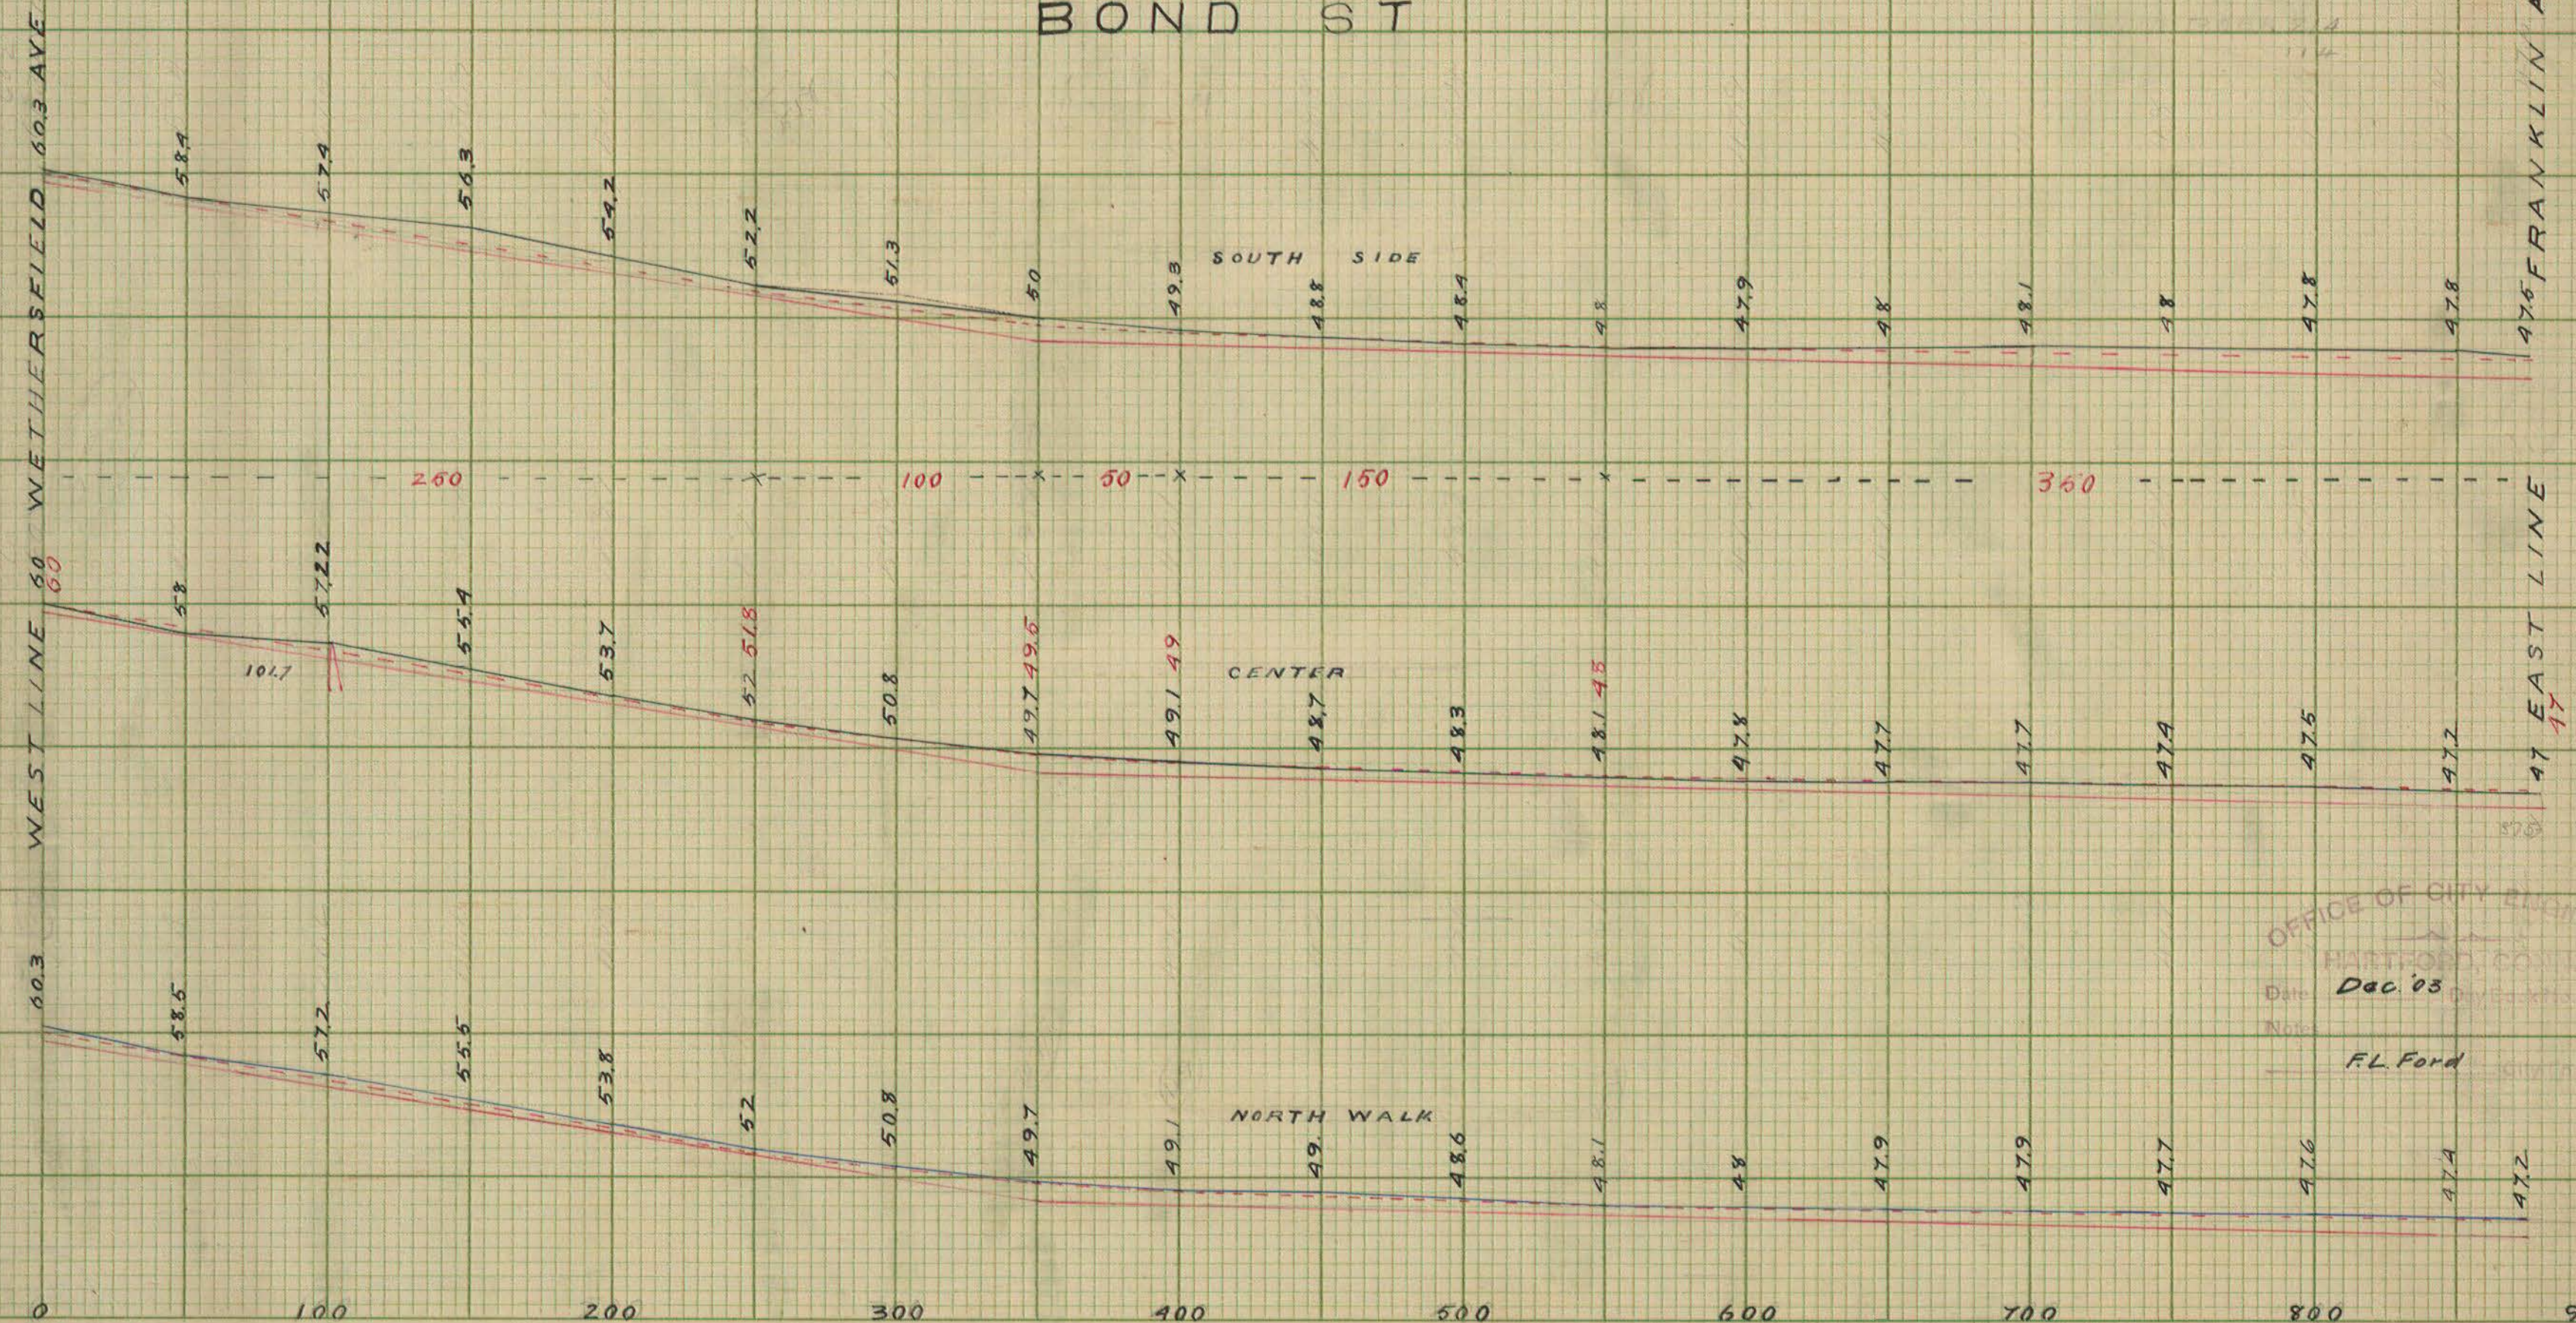

OFFICE OF CITY ENGINEER
HARTFORD, CONN.
Date Dec '03
No. 01464
F.L. Ford