


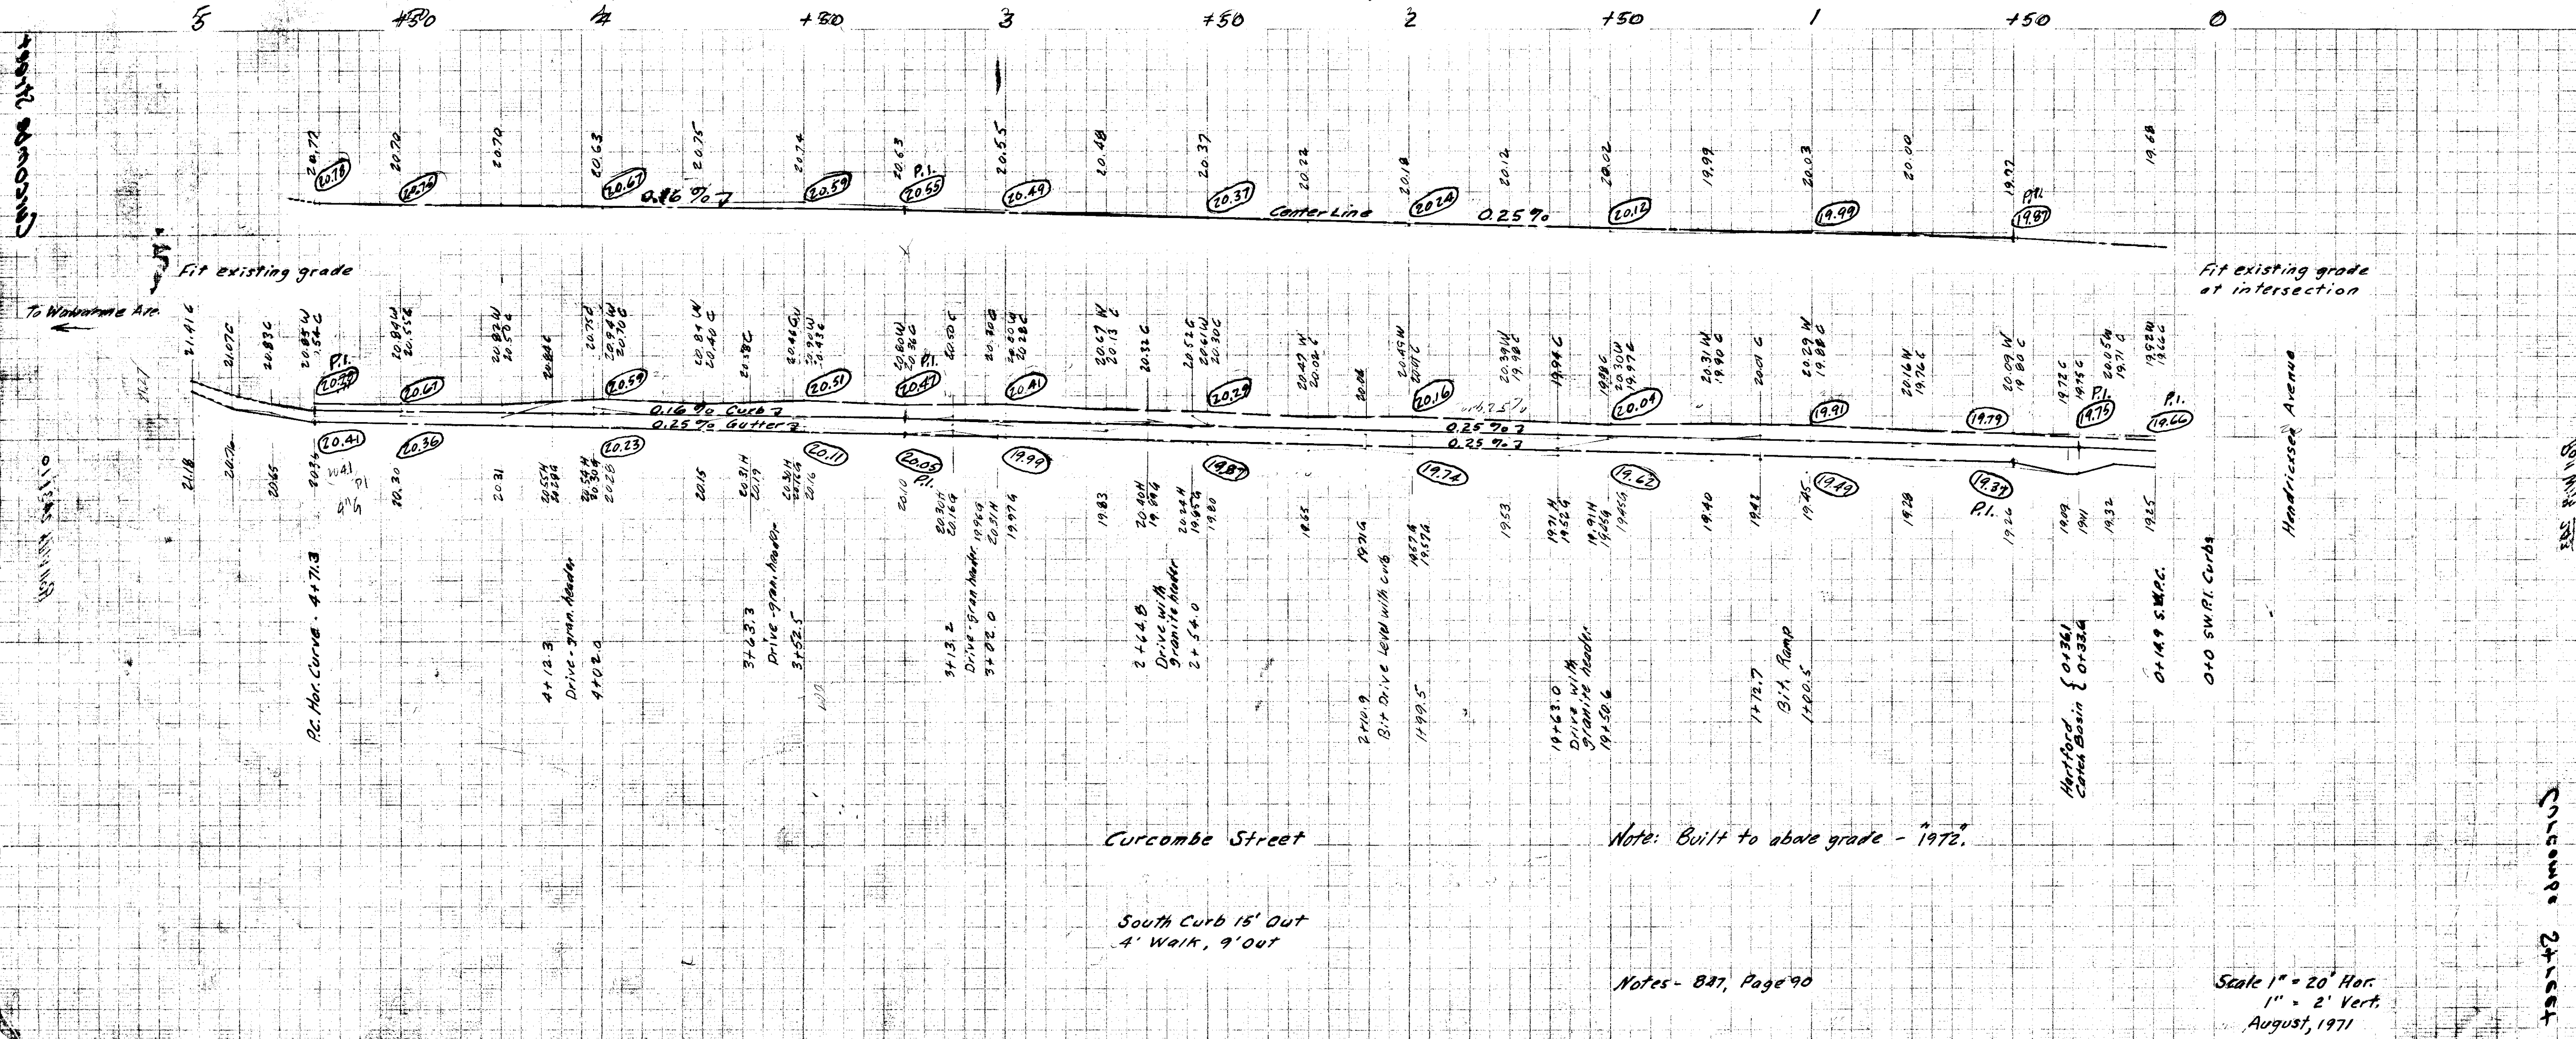

Curcombe Street

South Curb 15' Out
4' Walk, 9' Out

Note: Built to above grade - 1972.

Notes - 847, Page 90

Scale 1" = 20' Hor.
1" = 2' Vert.
August, 1971