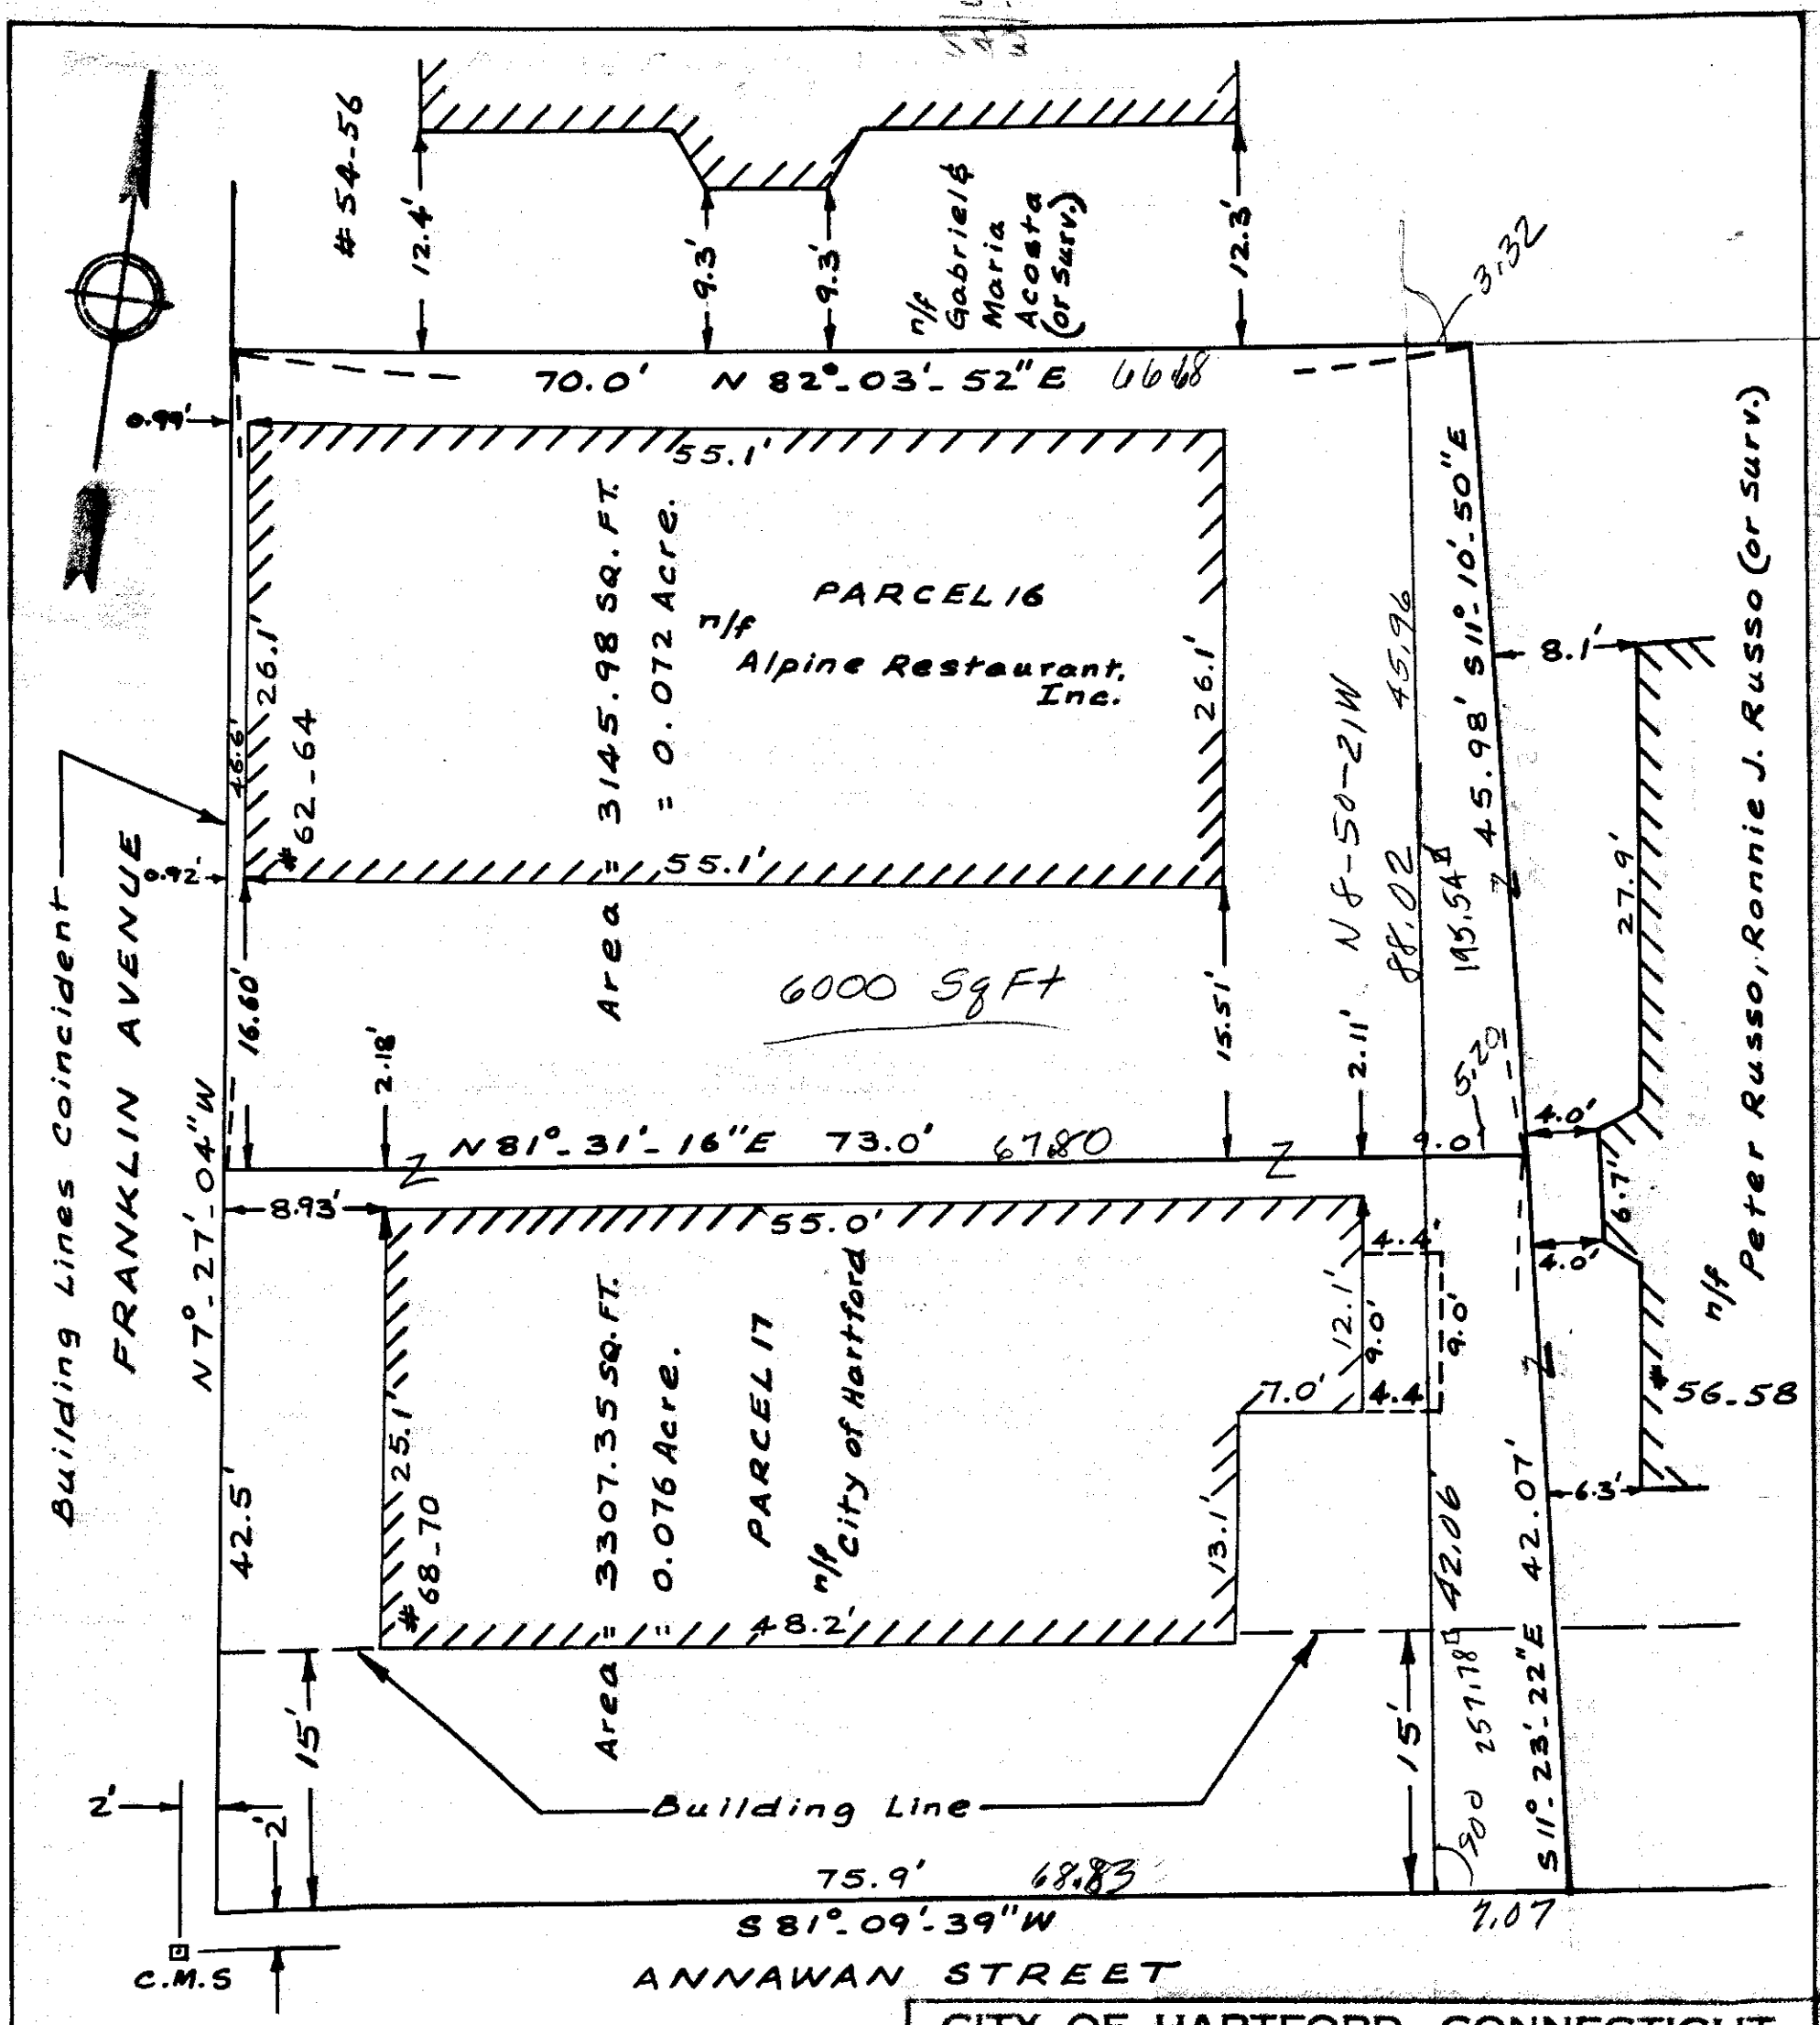


Note:
Information taken from the following sources:
a) Survey map prepared by the city of Hartford, Department of Engineering Scale 1"=40', dated September 1971, Day book No. 010291 File No. 92/9
b) Survey Note book 857/138; 829/124
c) Deeds - Hartford Land Records - 1415/304 & 1456/331

# CITY OF HARTFORD, CONNECTICUT

DEPARTMENT OF PUBLIC WORKS

BUREAU OF ENGINEERING SERVICES

BLOCK 15 PARCELS 16 & 17
CHARTER OAK - SOUTH GREEN SECTION - 1
CONN. R 112
HARTFORD, CONNECTICUT.

| SUBMITTED | RECOMMENDED | APPROVED |
|---|---|---|
| Seymour Bagulk<br>DIVISION ENGINEER | Russell E Dorg<br>CHIEF OF ENG. SERV. | George E. Heppner<br>ASS'T DIR. & CITY ENG. |

| | | |
|---|---|---|
| DRAWN R.G.V.A<br>CHECKED SB | SCALE<br>1 inch = 10 Ft | DAYBOOK NO. 010548<br>DATE January 6, 1976 |