



OFFICE OF CITY ENGINEER
 HARTFORD, CONN.
 Date _____
 Notes _____
 Day Book No. 01436
 City Engineer _____

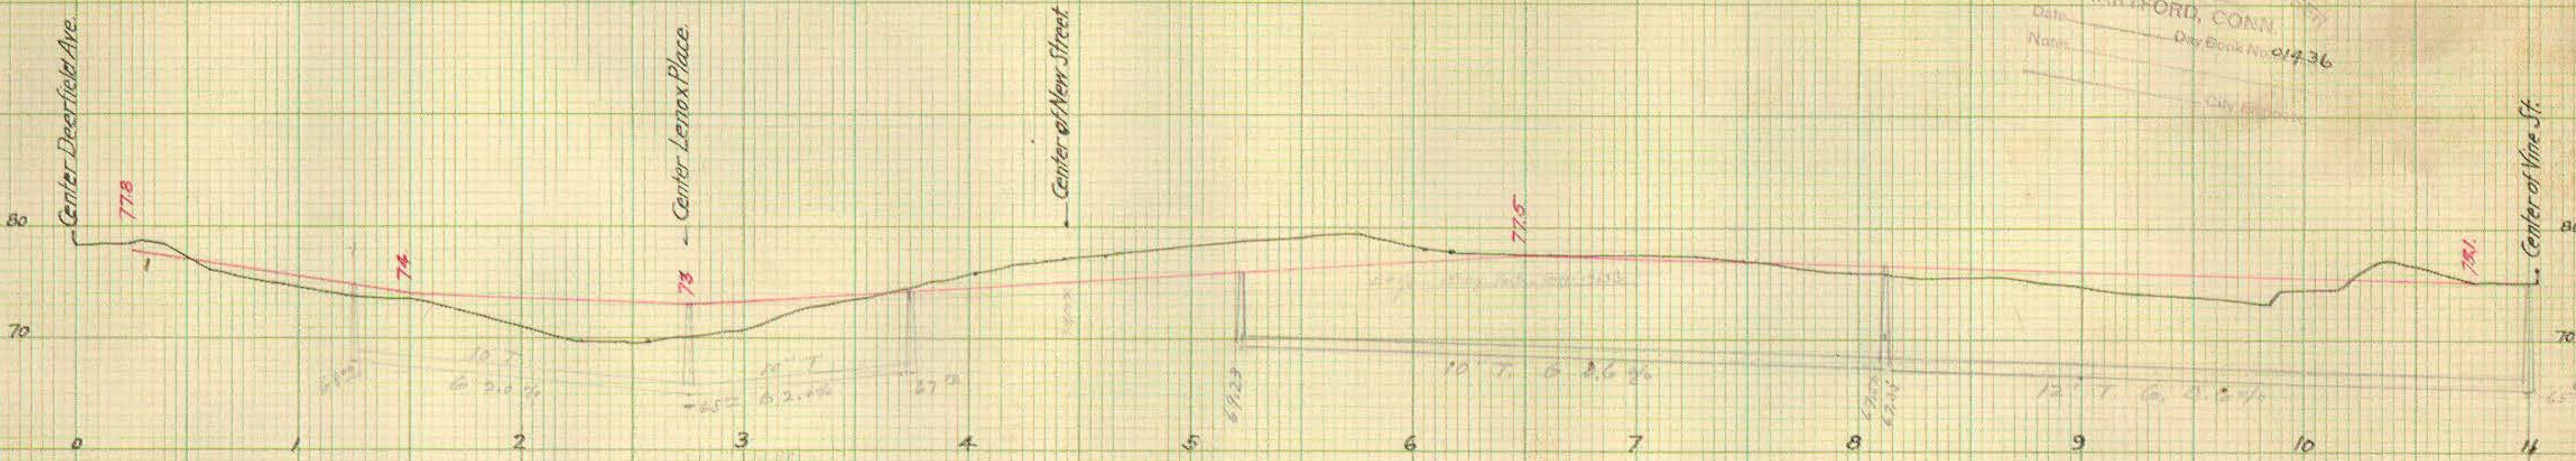

Profile of New Street from Deerfield Ave to Vine St.

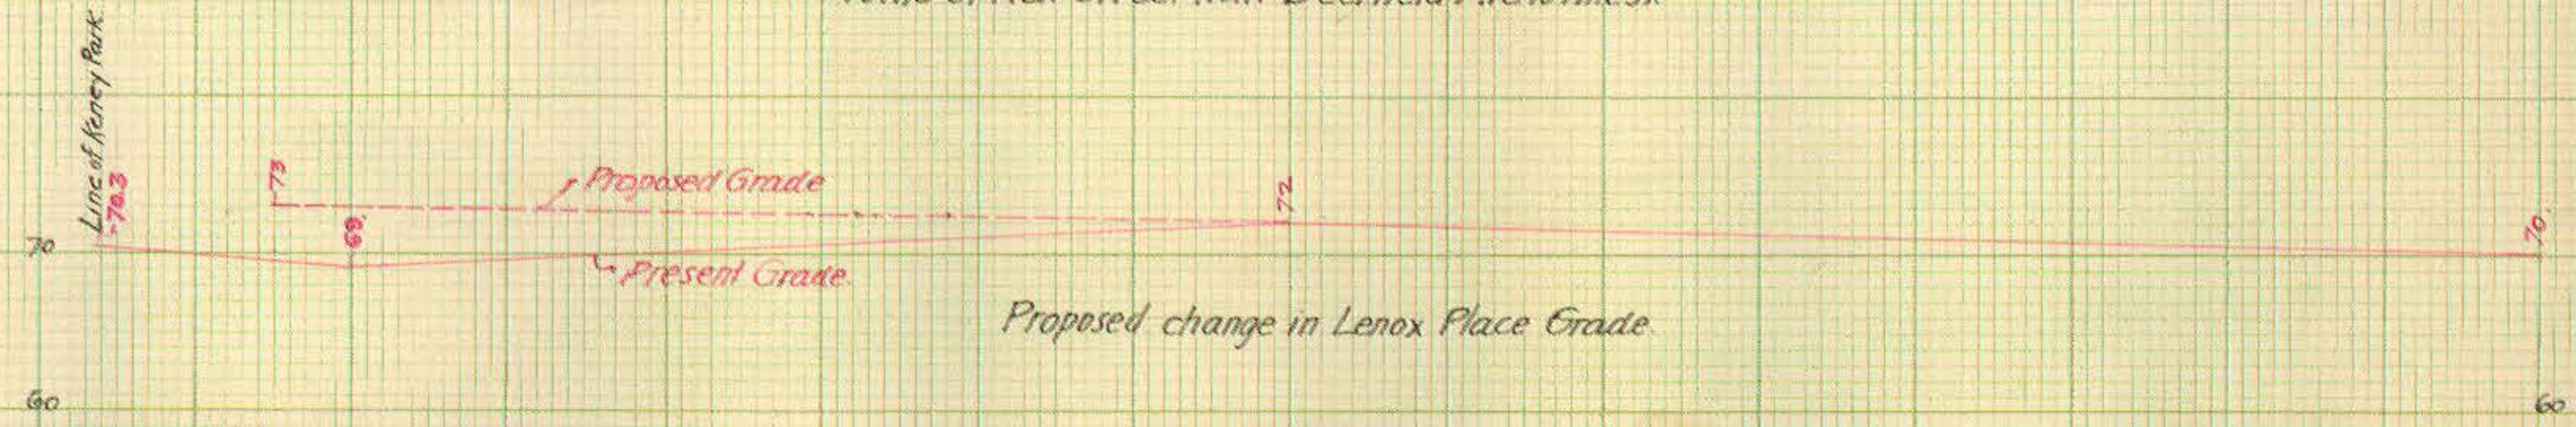

Proposed change in Lenox Place Grade.

C. A. Worrin
 June 1901. Engineer 80 Pearl St.