

ASYLUM ST.

MAIN STREET
555/9


PEARL ST.

STATE

STREET

CENTRAL ROW

AMERICAN ROW

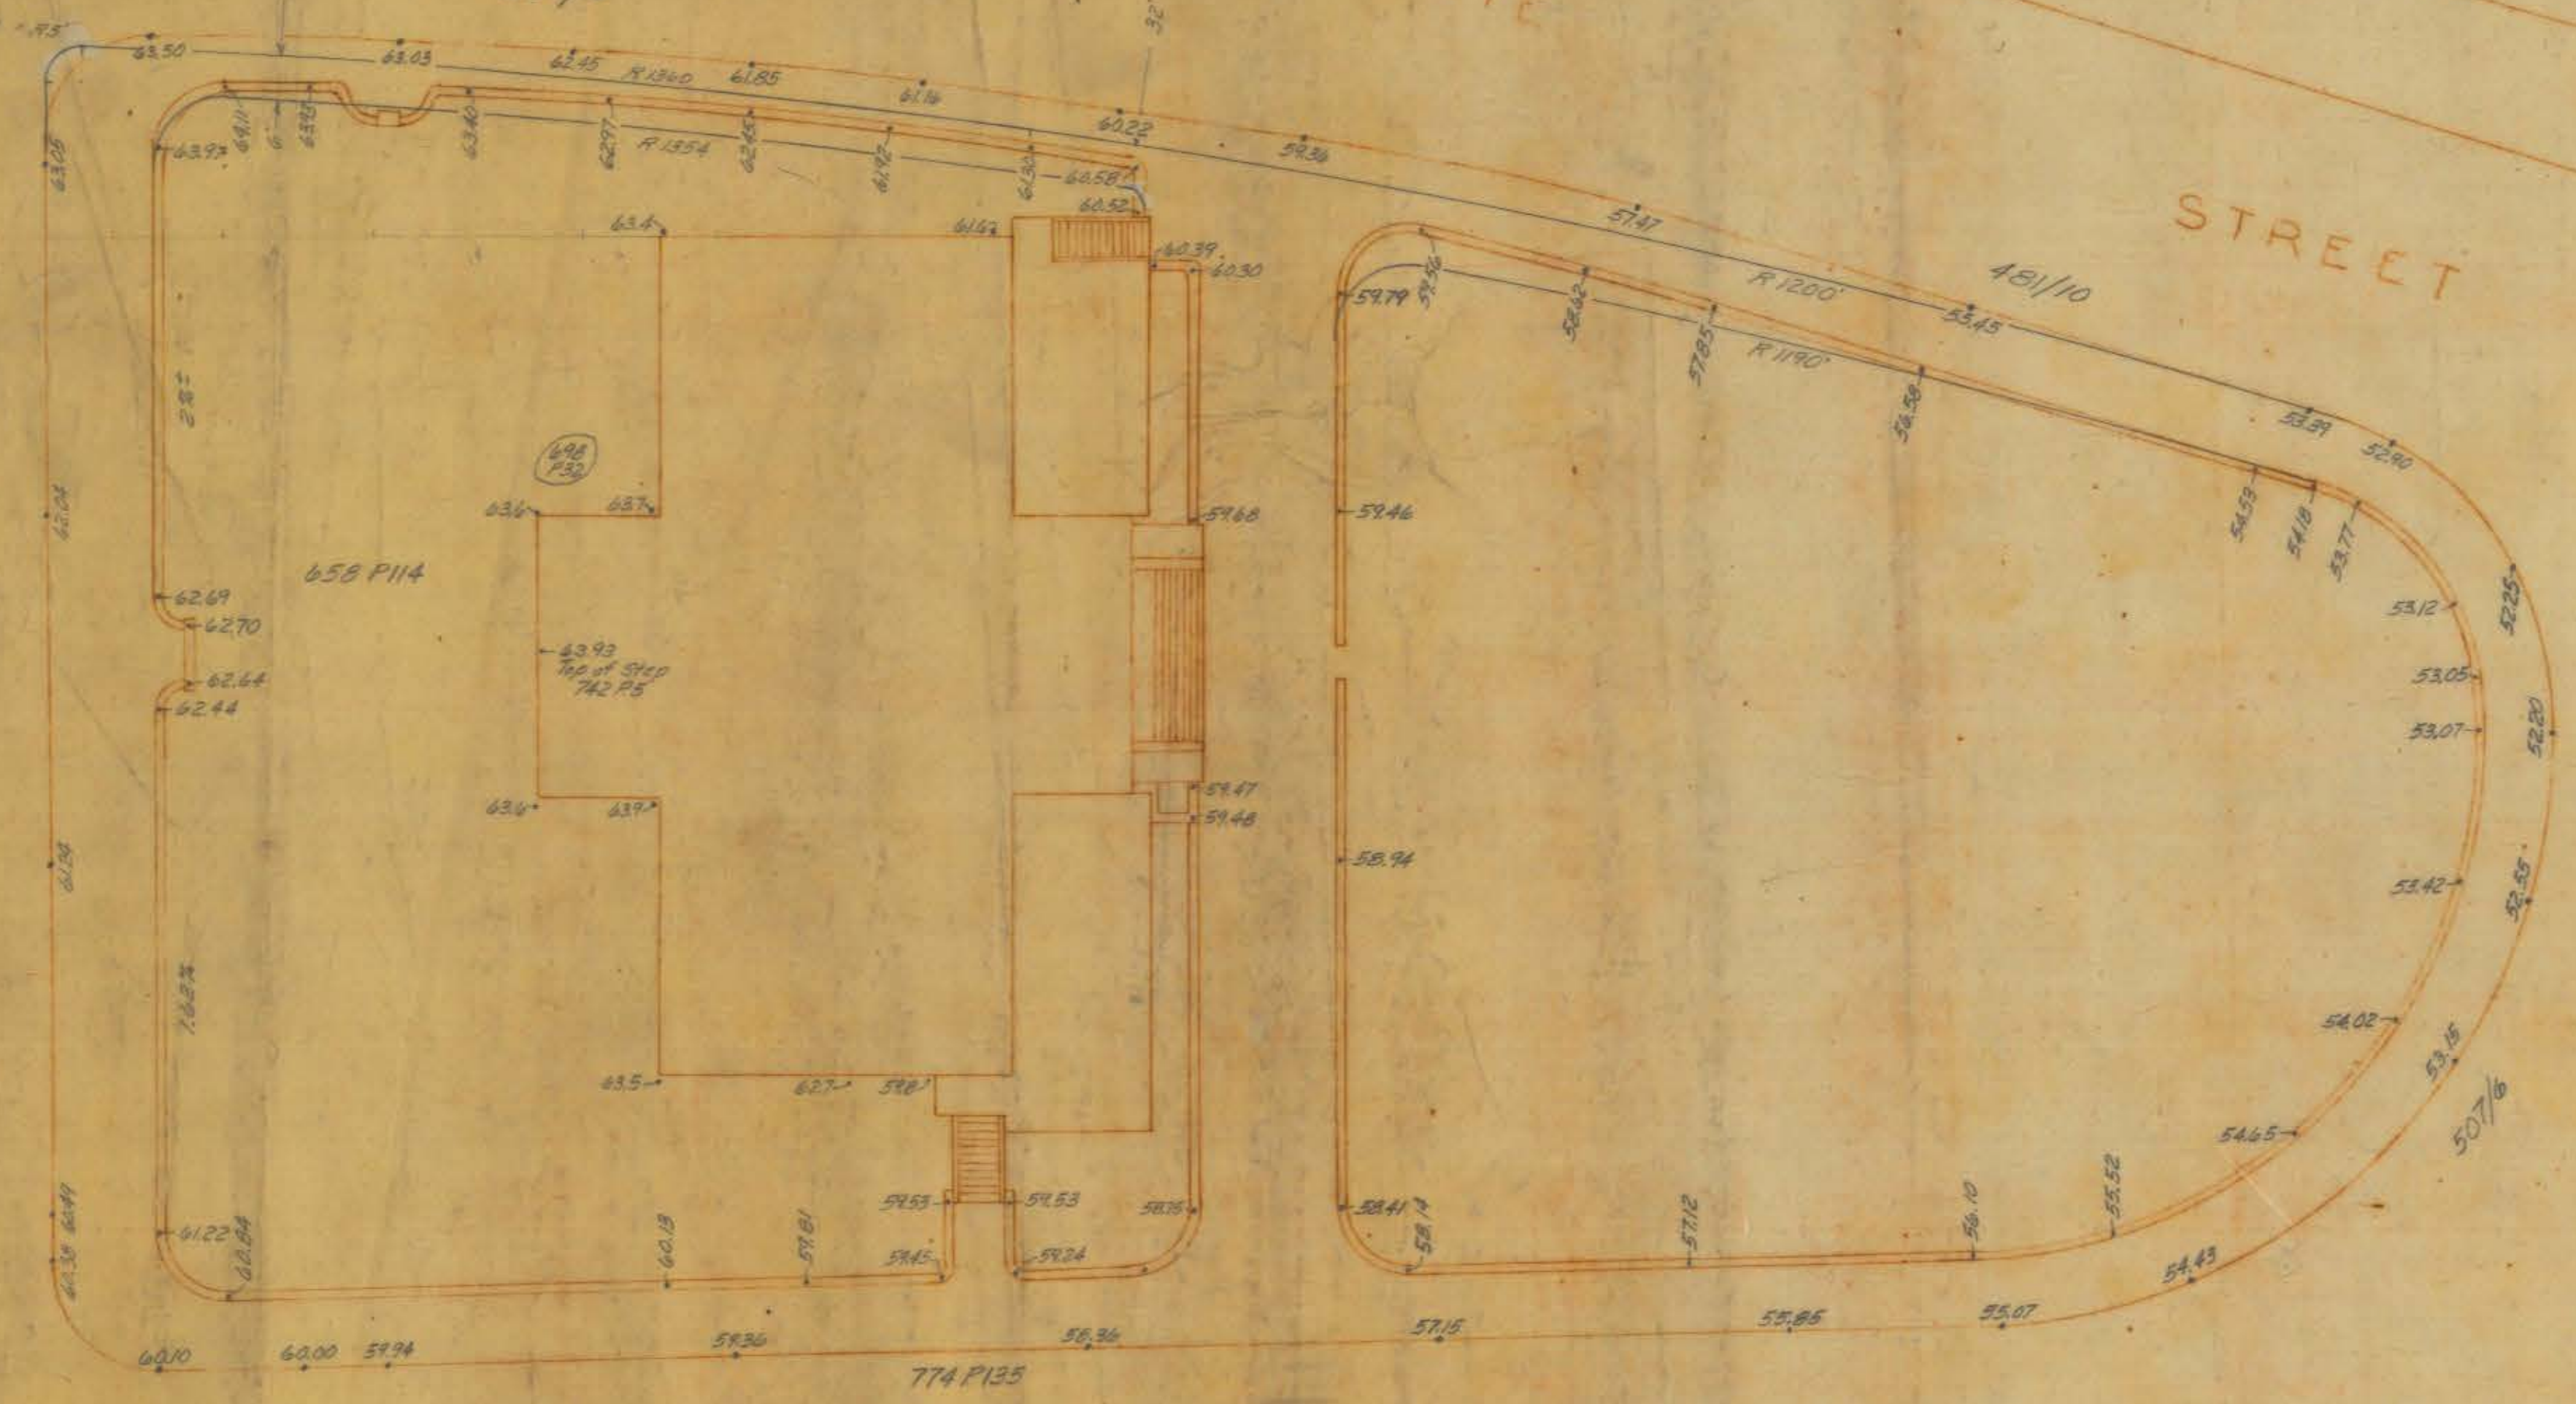

CITY OF HARTFORD
DEPARTMENT OF ENGINEERING
SCALE 1"=20' JANUARY 1965
DAY