


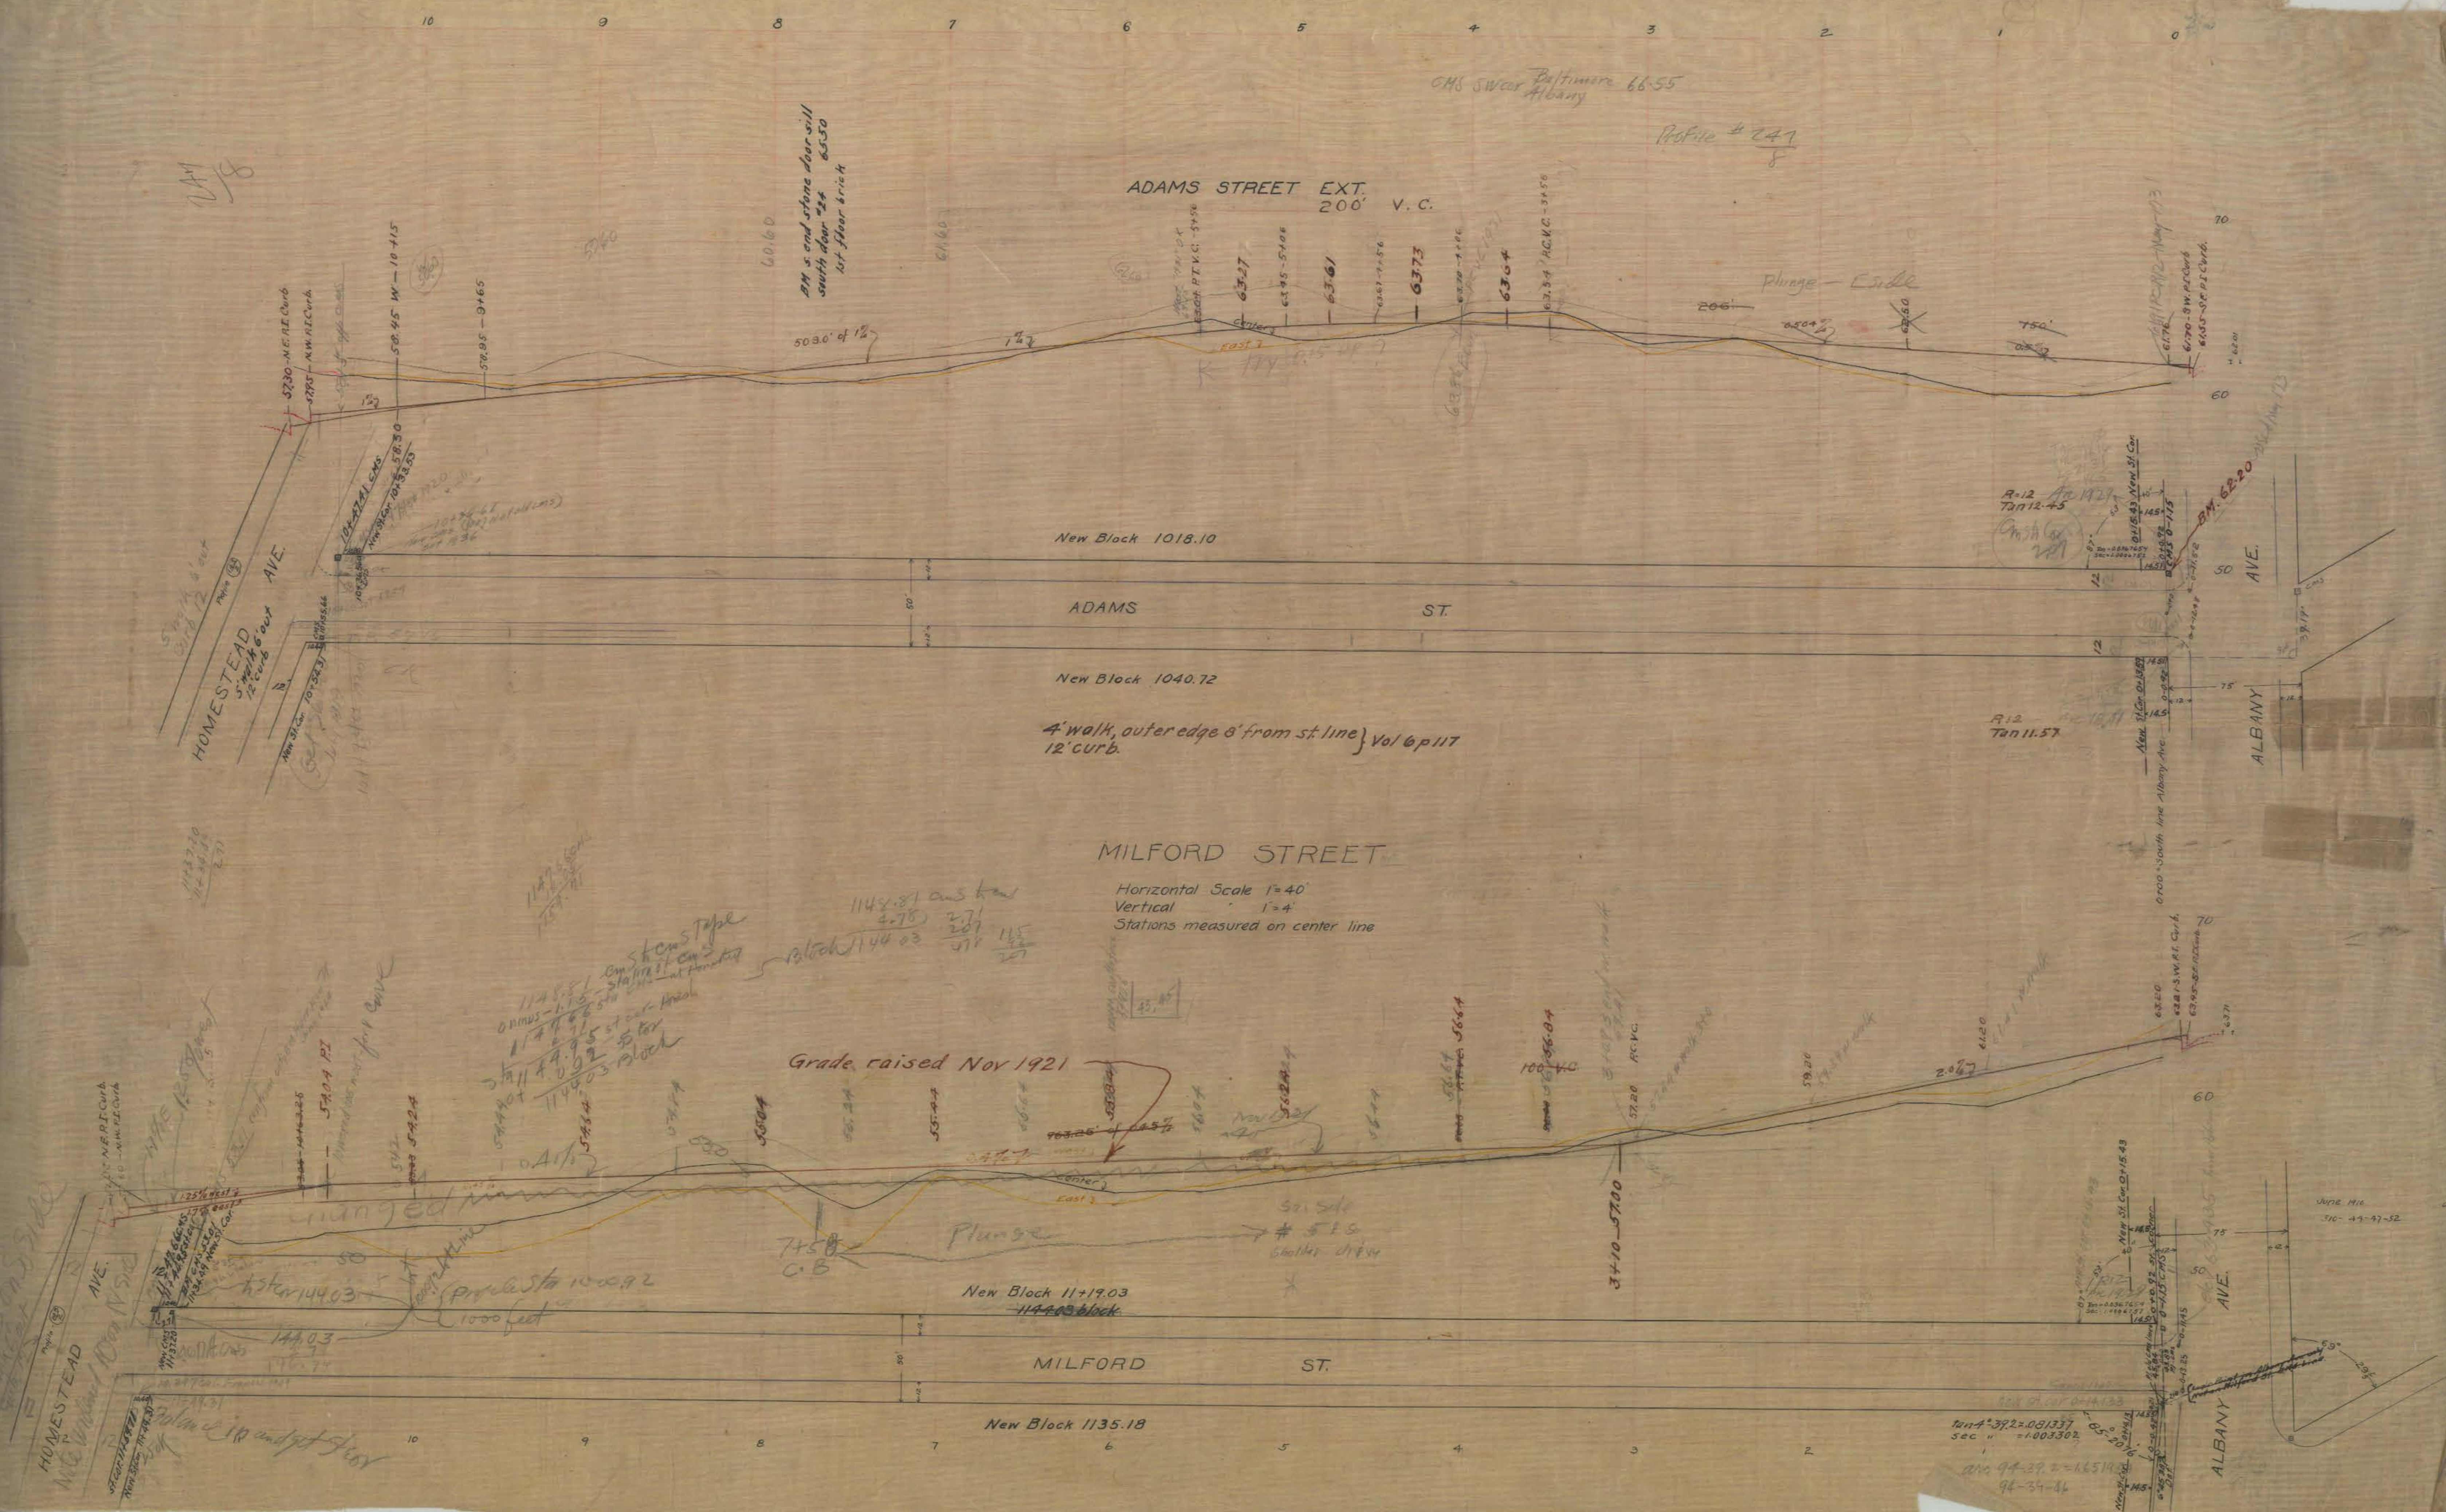

ADAMS STREET EXT.
200' V.C.

New Block 1018.10

ADAMS ST.

New Block 1040.72

4' walk, outer edge 8' from st. line } Vol 6 p 117
12' curb.

MILFORD STREET

Horizontal Scale 1"=40'
Vertical 1"=4'
Stations measured on center line

Grade raised Nov 1921

New Block 1119.03

MILFORD ST.

New Block 1135.18

CMS Swear Baltimore 66.55
Albany

Profile # 247
8

Plunge - Side

R=12
Tan 12.45

R=12
Tan 11.57







