

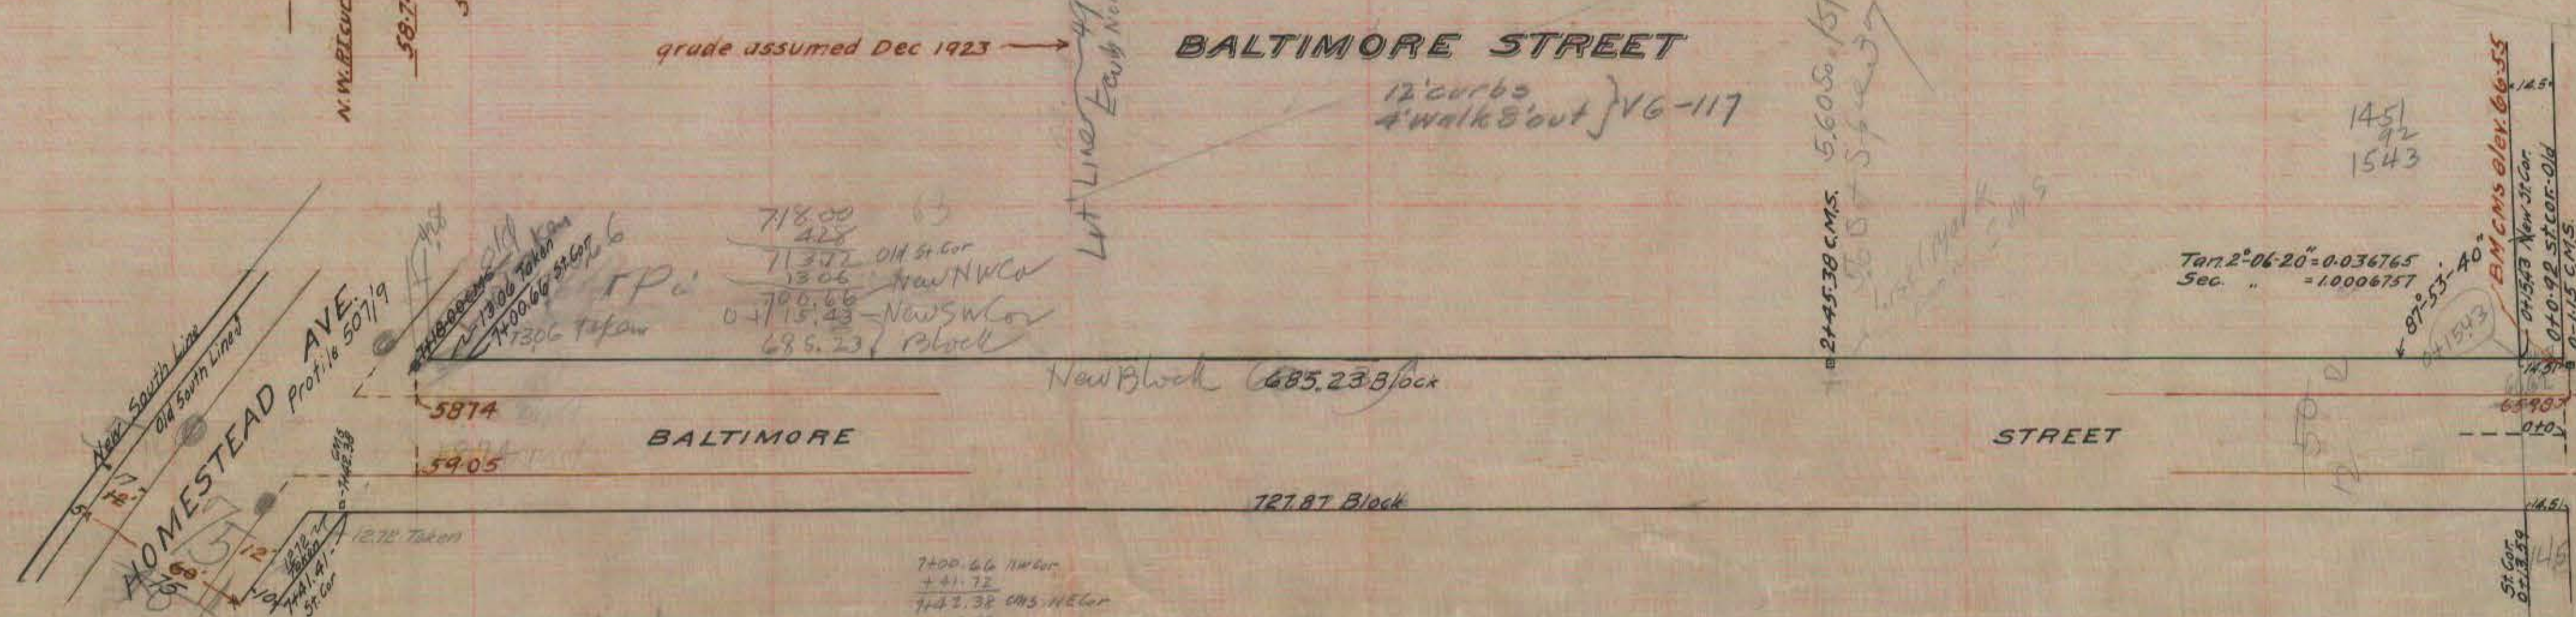


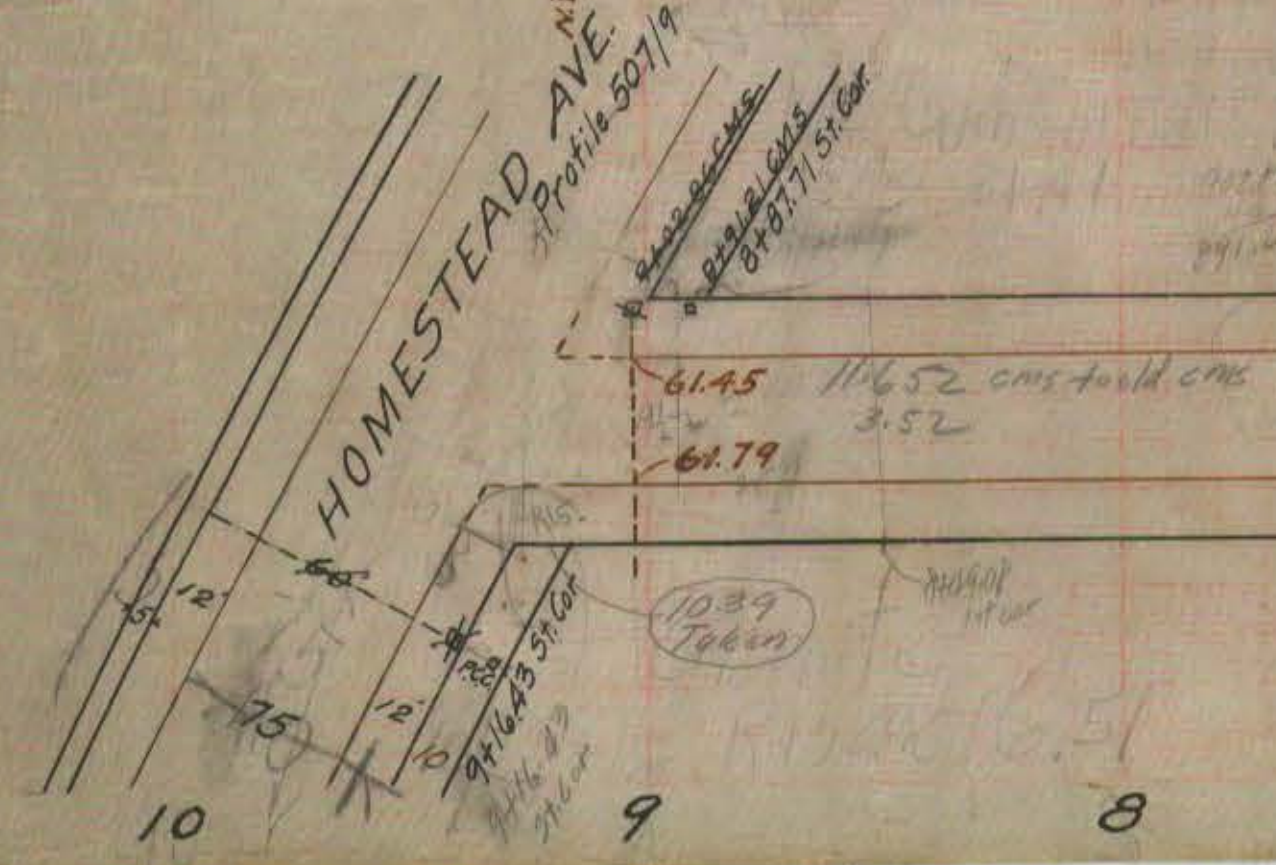

1916 02976
 F.N. Clark
 Superseeder old
 Profile under same
 day book no. and
 drawer and sheet no.

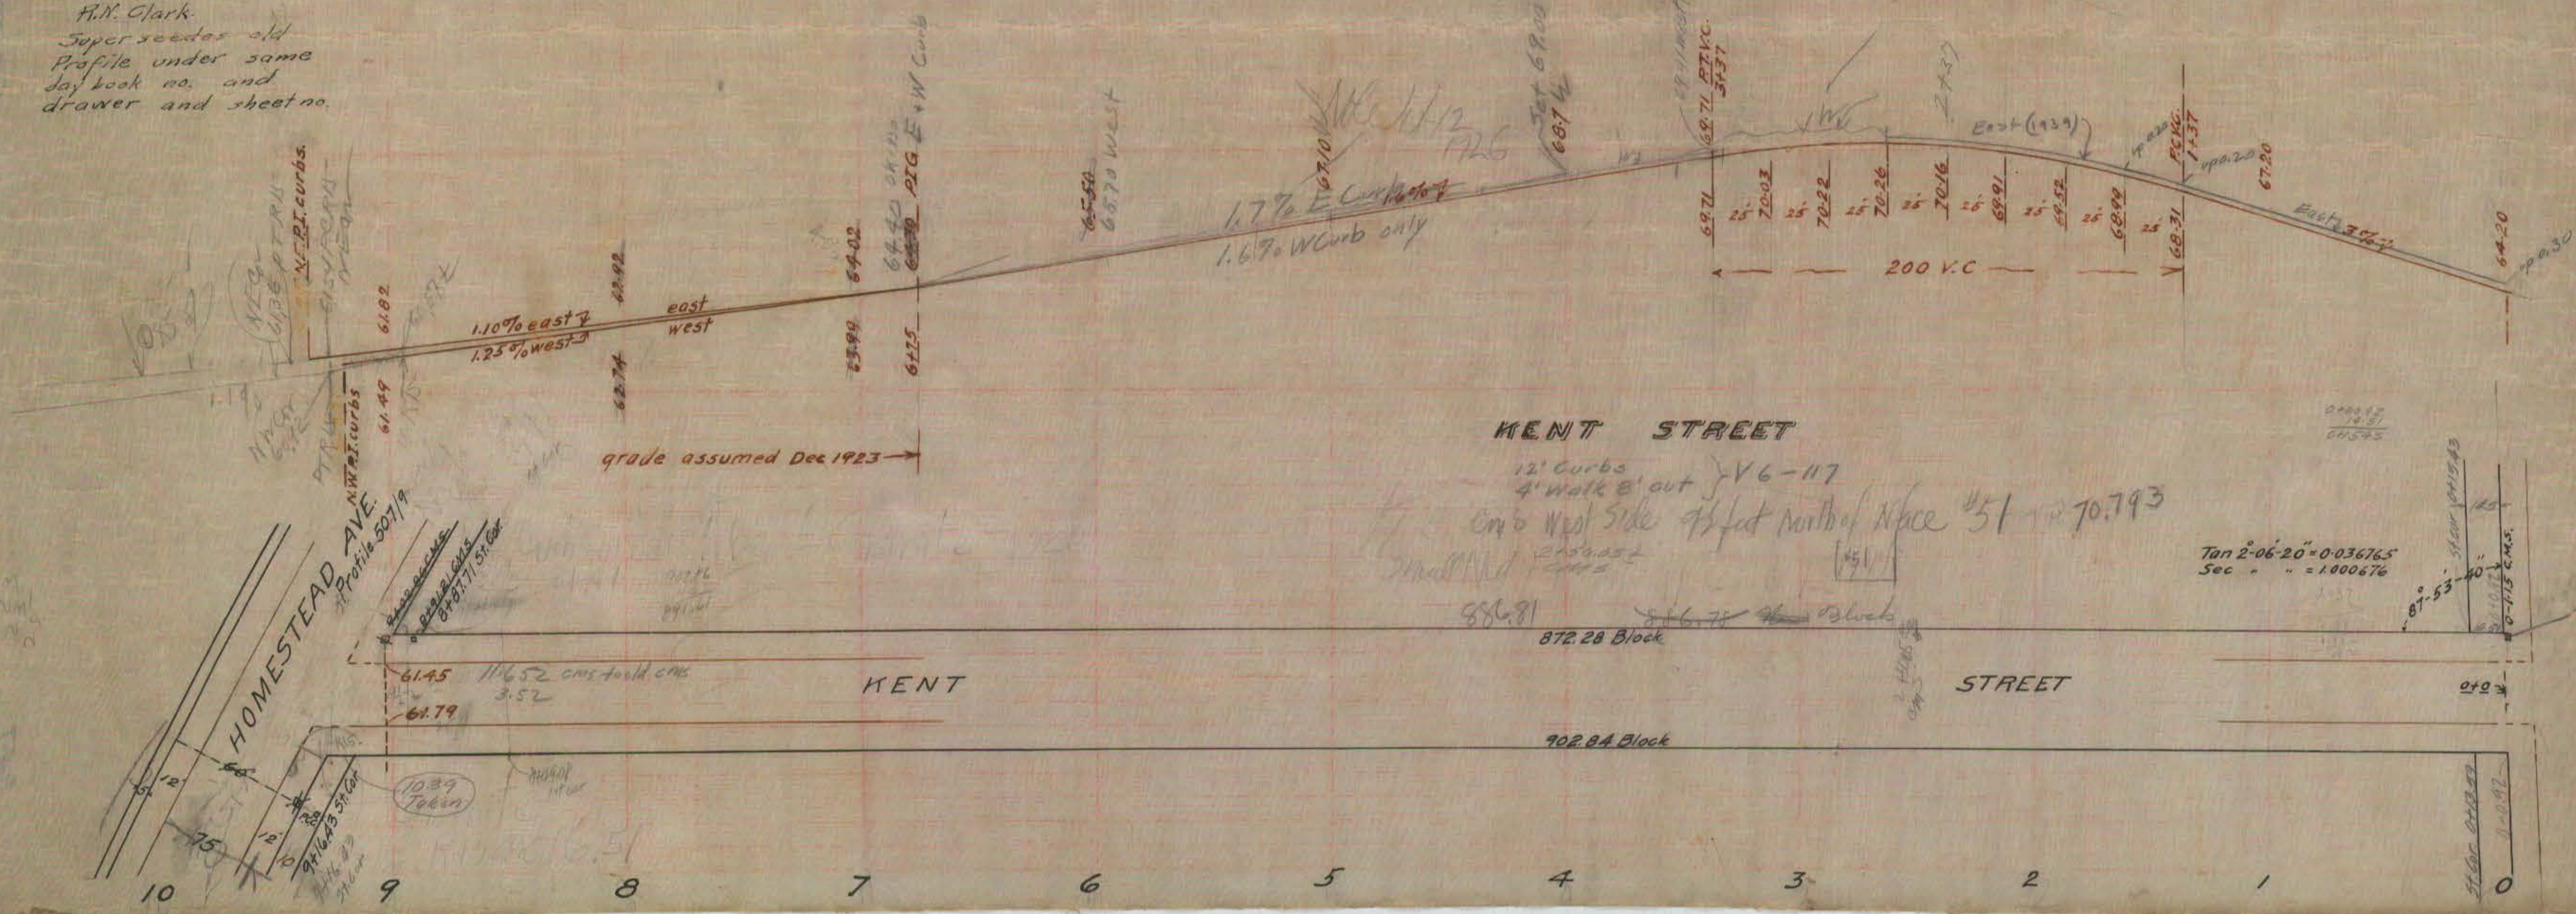

ALBANY AVE