


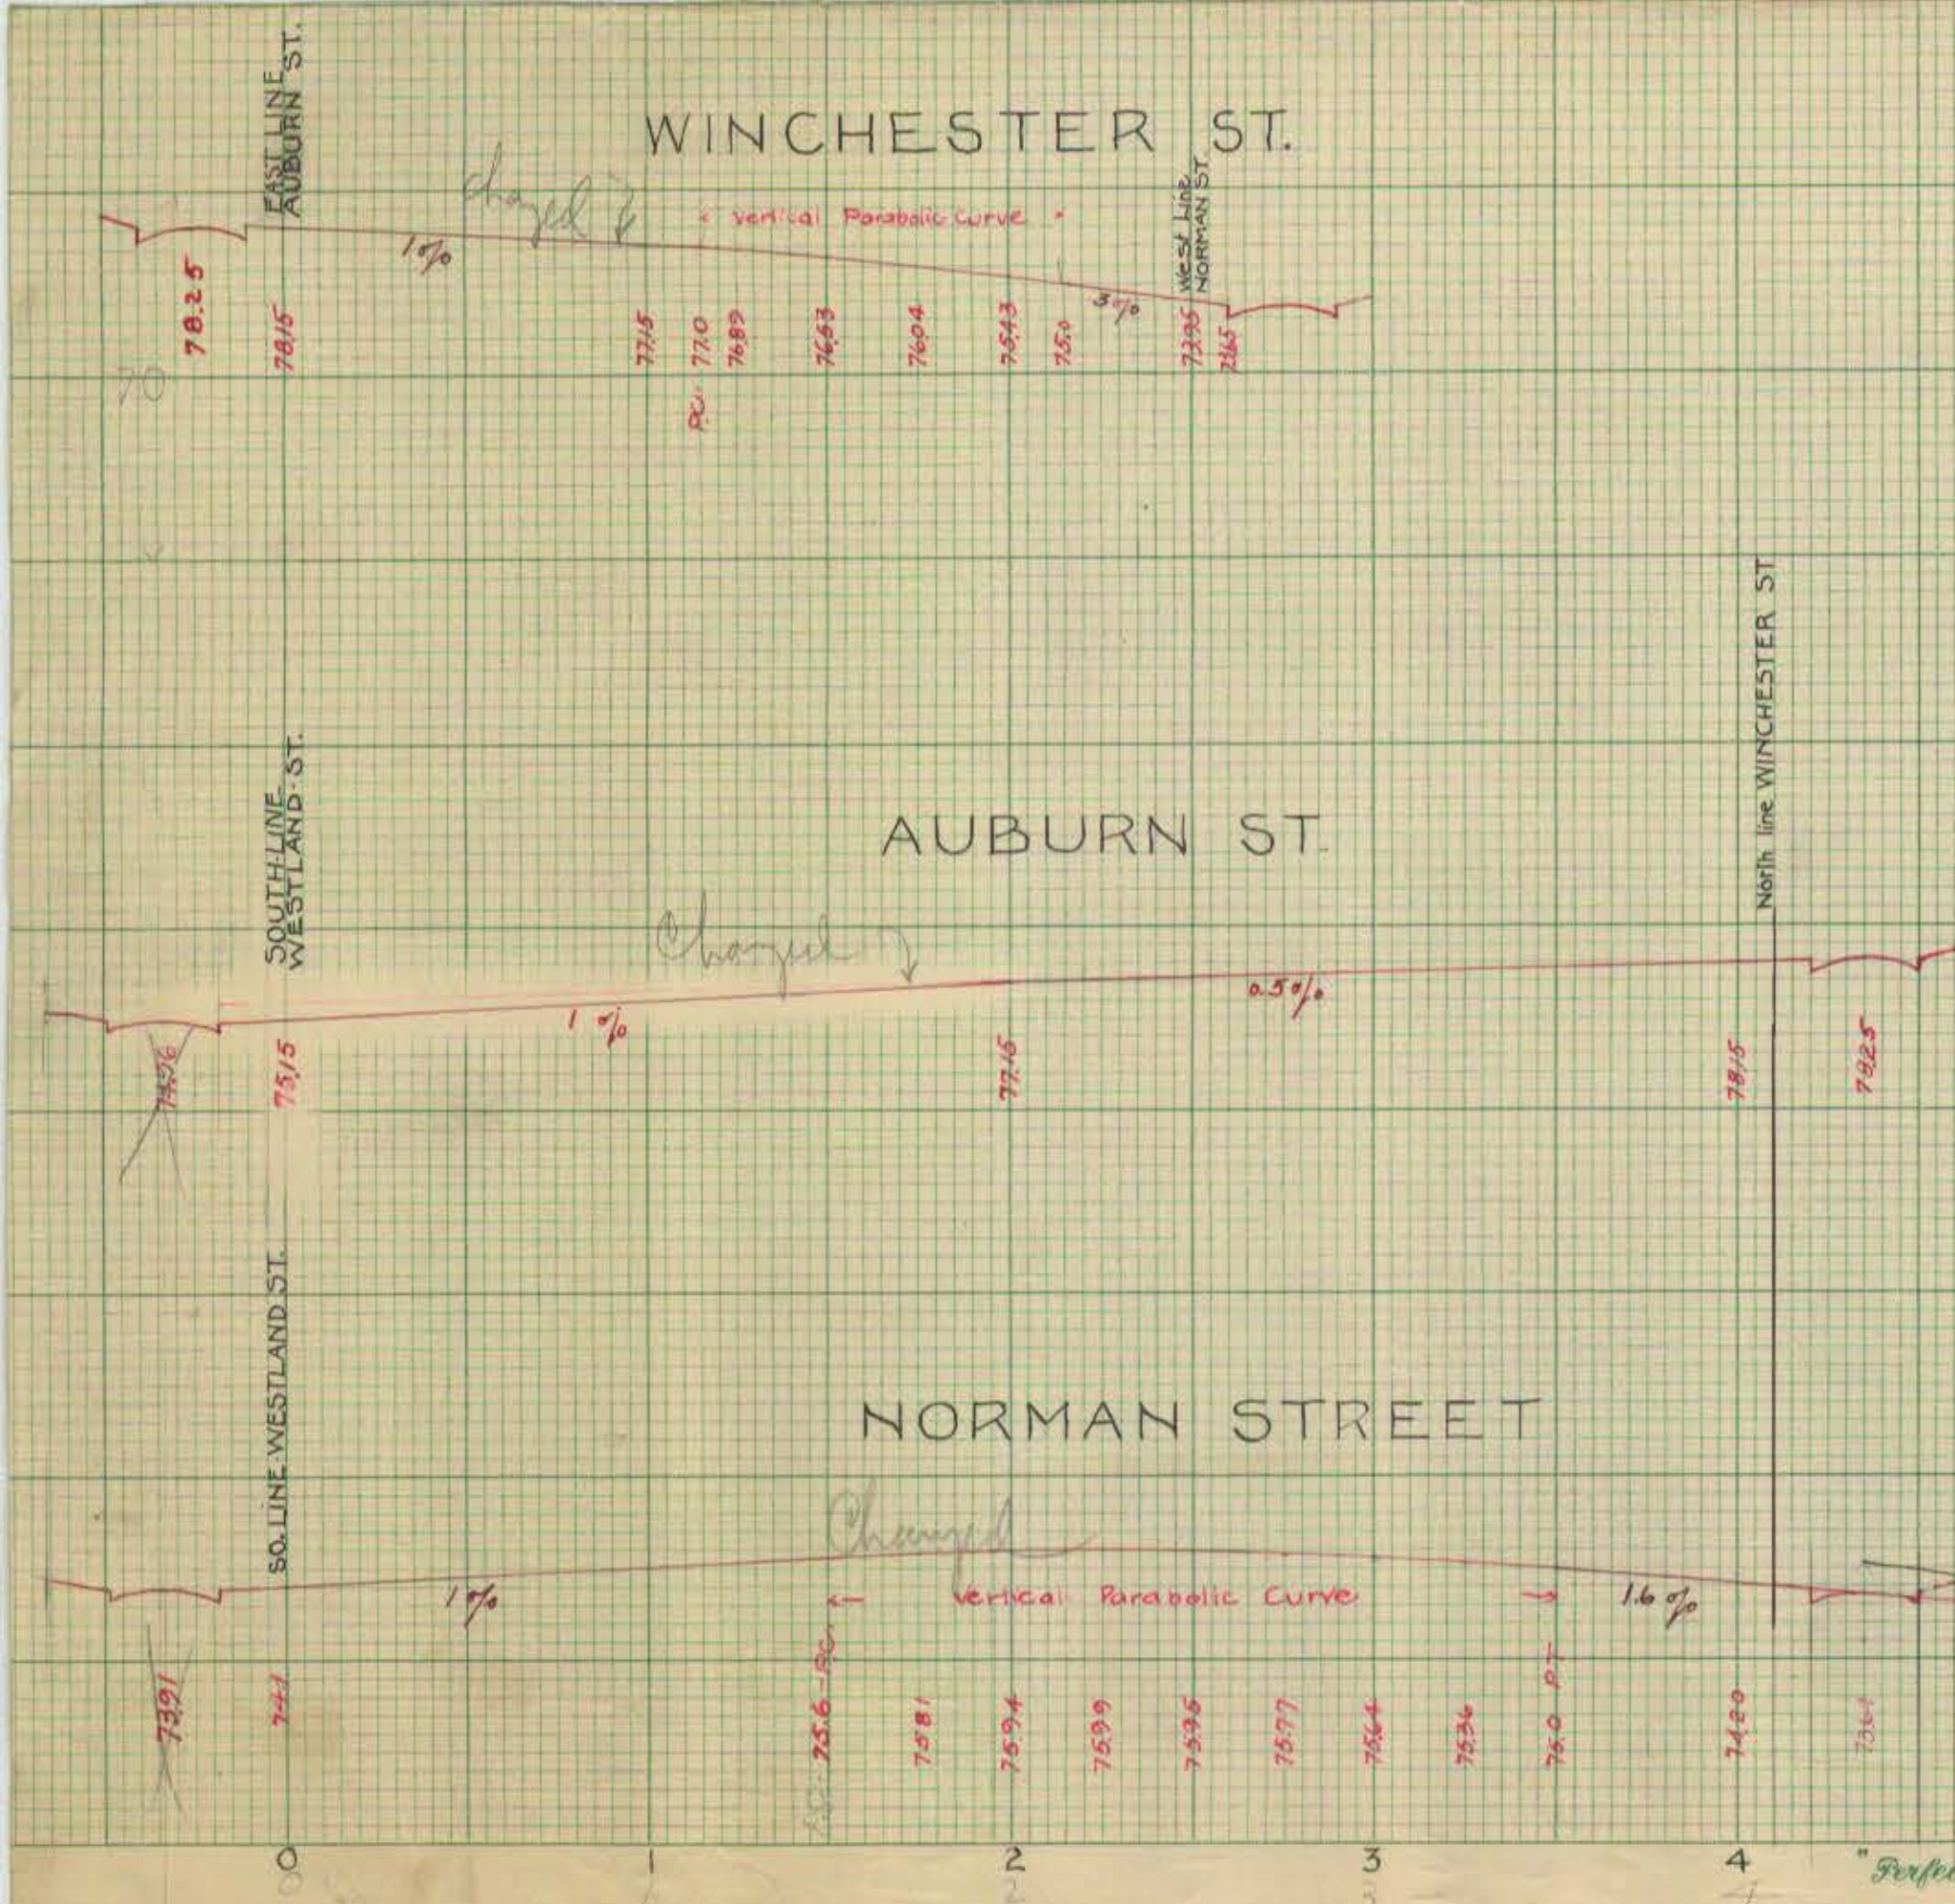

Profile of Streets south of Westland St.
on land of H.M. Whitney
May 1904: Scale 1"=50'

all changed - 11/05 see profile 1908

OFFICE OF CITY ENGINEER
HARTFORD, CONN.
Date May 1904. Day Book No. 01577
Notes: _____
_____ City Engineer