


MEADOW STREET 40' St

SCALE Hor 50' to 1" Vert 10' to 1"

40' St. Center Line 4629 North of N.E. Cor. Brick Fr. 49. Par Elev. 34.93 S of Stake at West Side of West Corner window 248 North Ave. 45.73 Not N.E. Cor. Brick with Last House Front

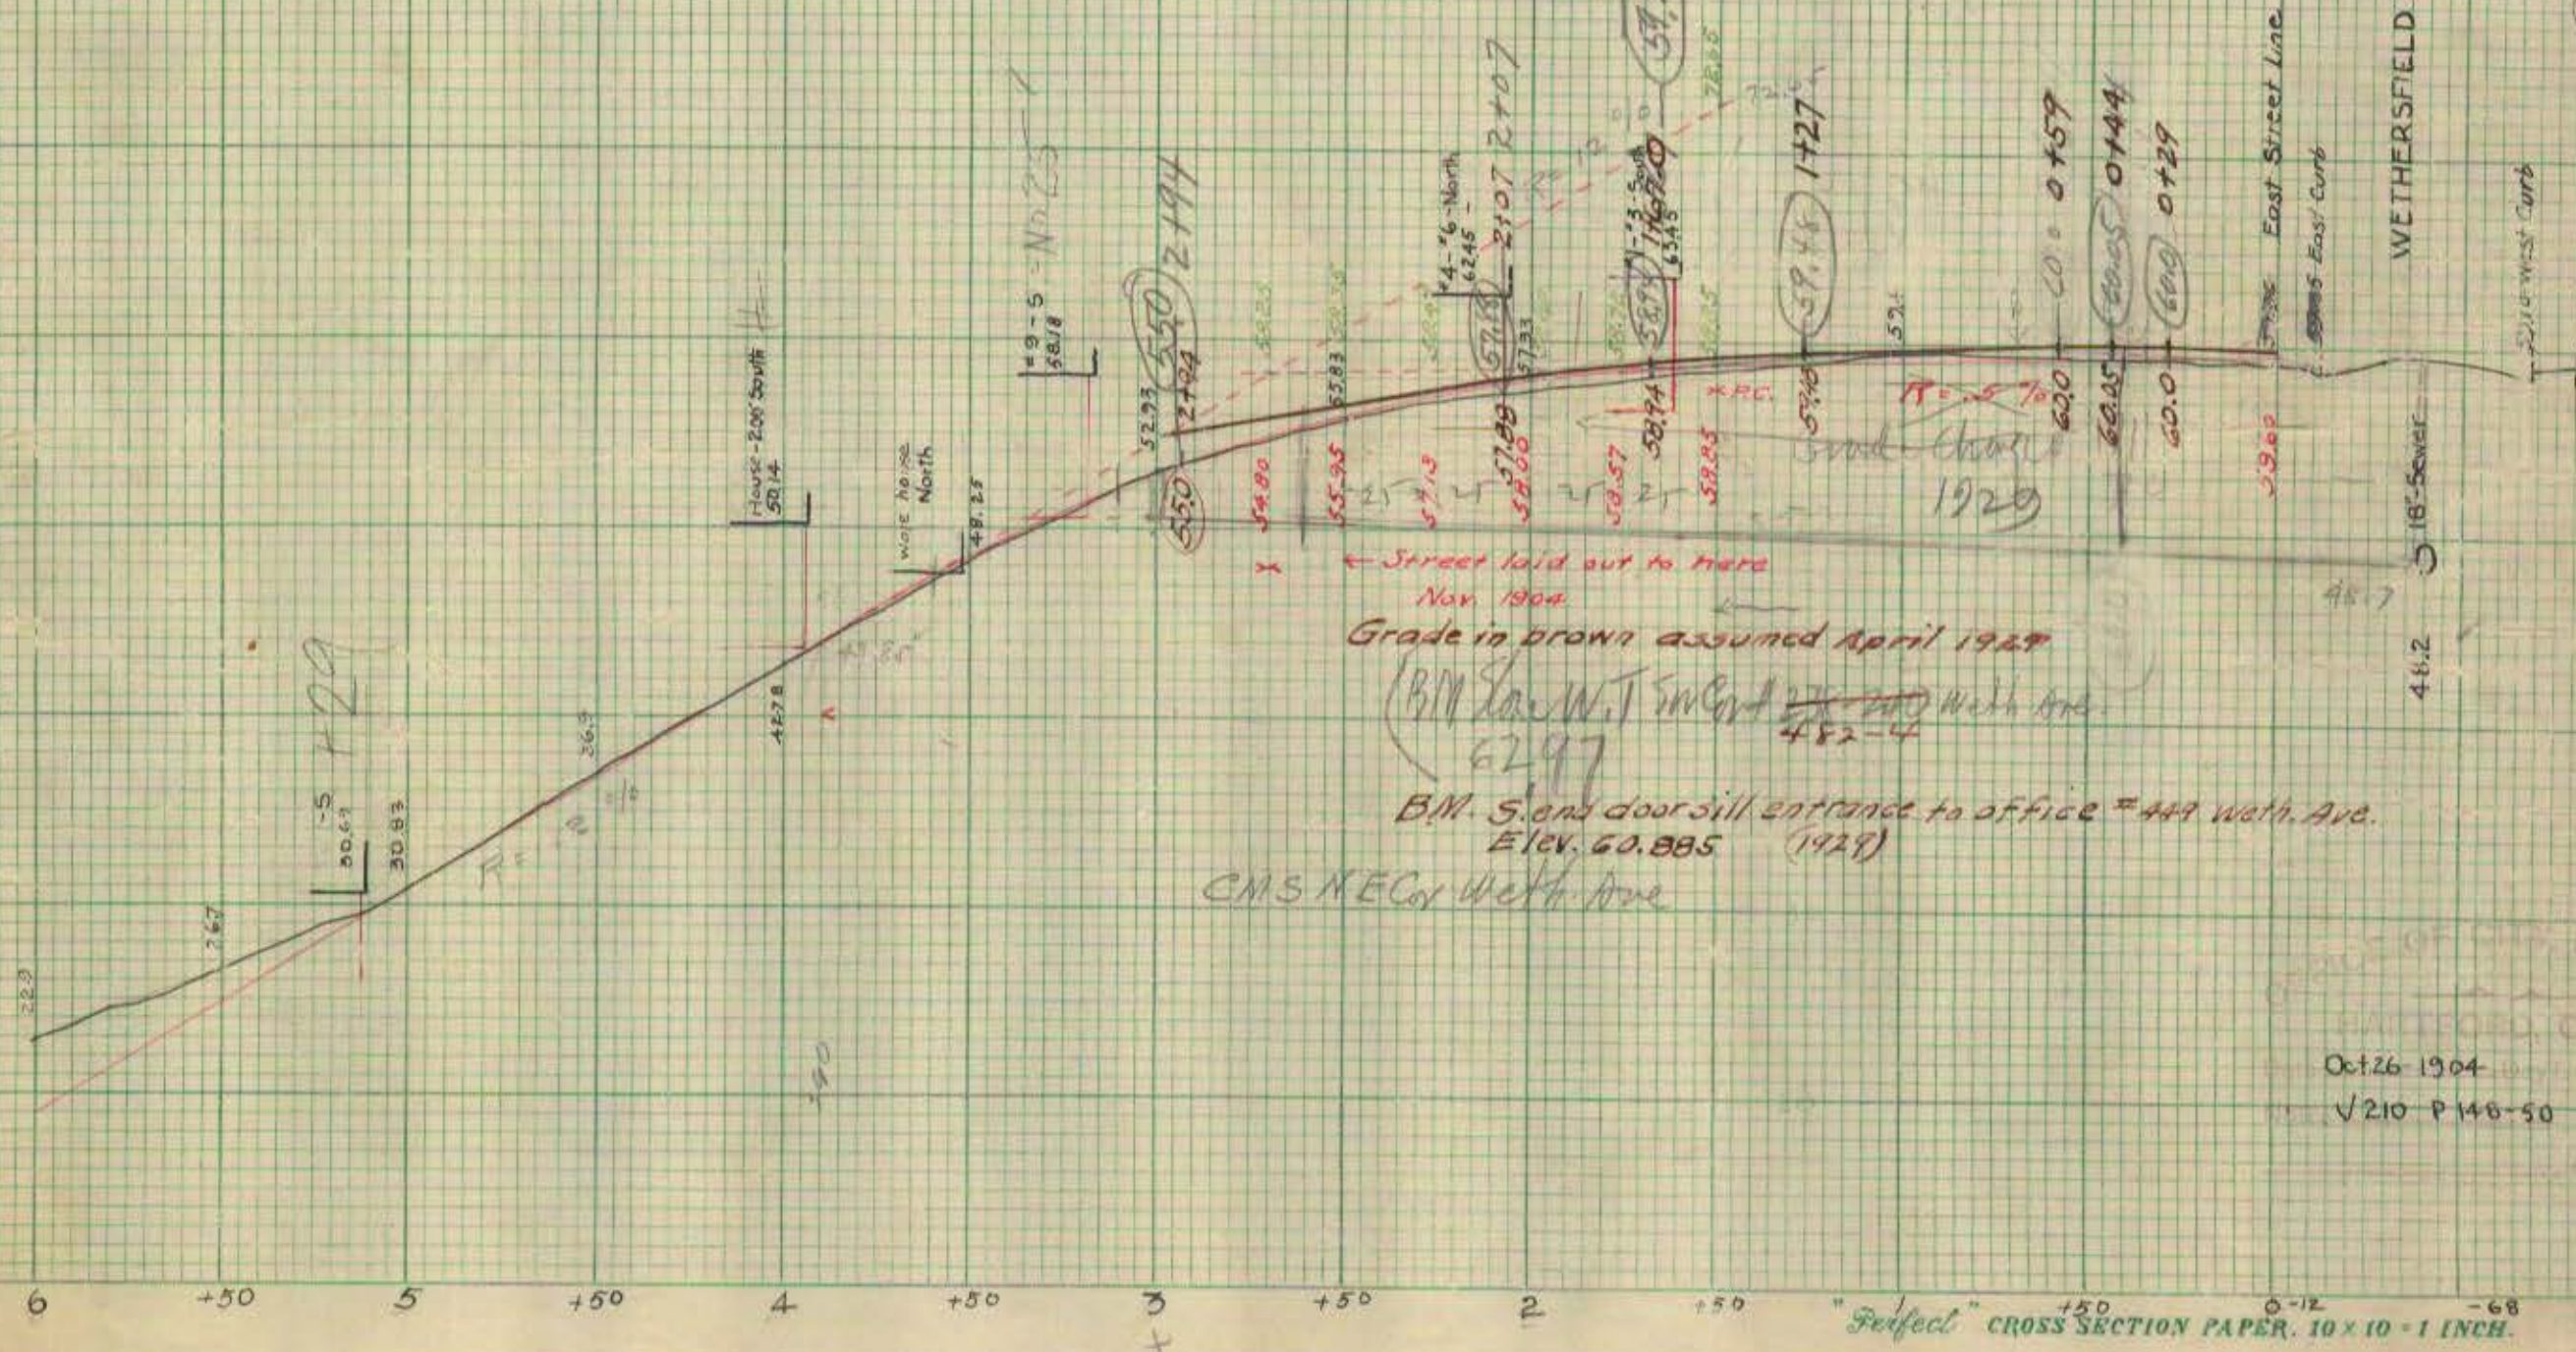

Street laid out to here Nov. 1904

Grade in brown assumed April 1929

(B.M. S. and door sill entrance to office #447 Weth. Ave. 62.97)

B.M. S. and door sill entrance to office #447 Weth. Ave. Elev. 60.885 (1929)

CMS N.E. Cor. Weth. Ave.

Oct 26 1904 01515
V210 P 146-50