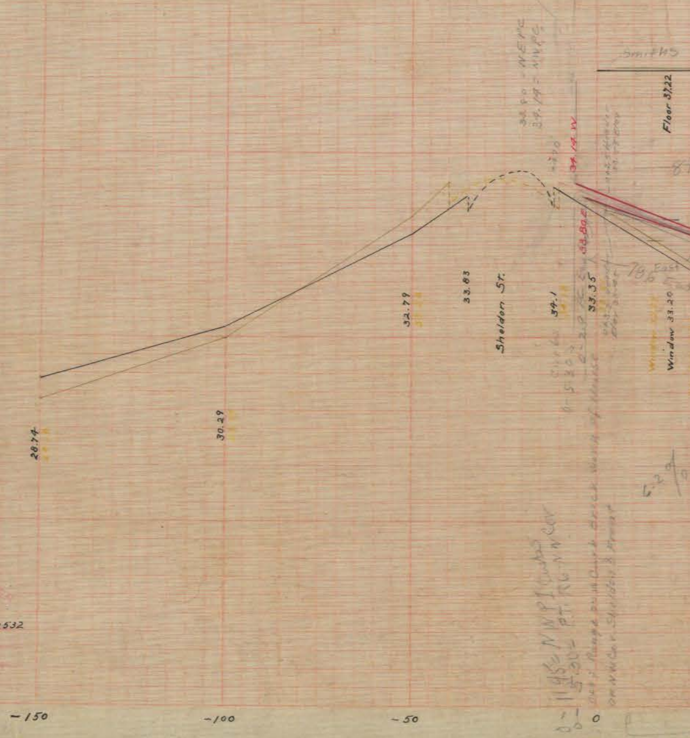
Smiths
34.80 - N.E. P.C.
34.14 = N.W. P.C.
Floor 37.22
34.14 W
33.80 E
East
Sheldon St.
28.74
30.29
32.79
33.83
34.1
33.35
Window 33.20
-150
-100
-50
0

Dec. 1910
318 -73-101
F. L. Ford

02532

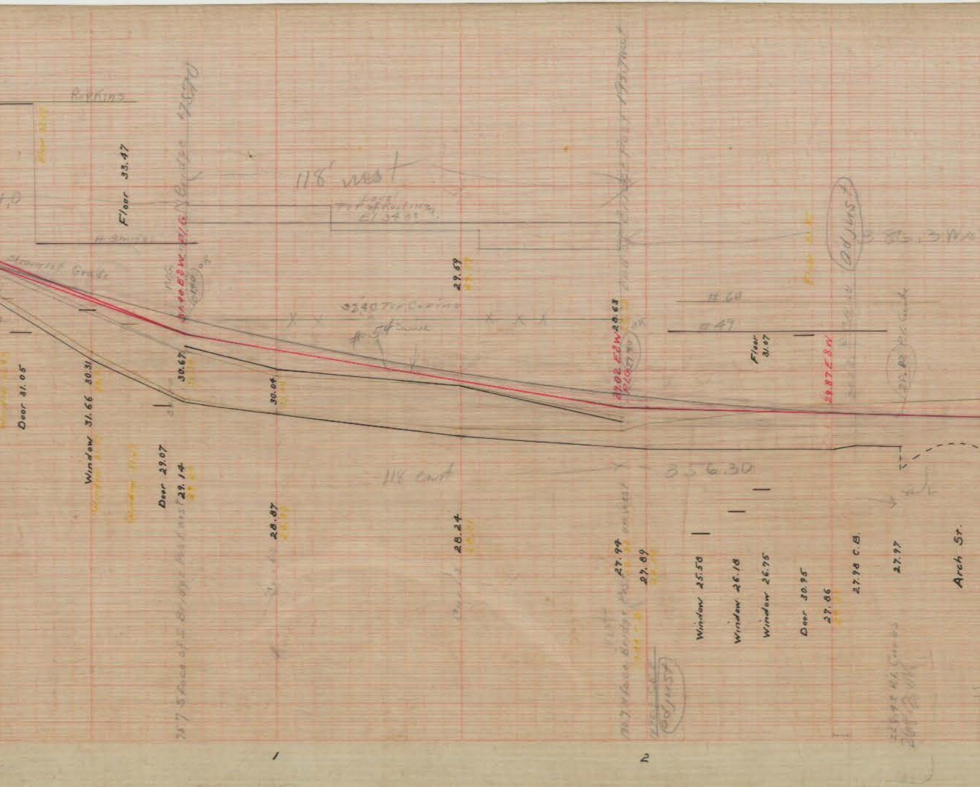

Perkins
Floor 33.47
Straight Grade
118' west
Level Top of Footing El 34.81
3240 Top Curbing
#5 Sewer
#69
#47
Floor 31.07
28.87 E&N
27.02 E&W
28.63
29.59
30.67
30.04
Door 31.05
Window 31.66 30.31
Door 29.07
29.14
28.87
28.24
118 east
356.30
Adjust
27.94
27.89
Window 25.58
Window 26.18
Window 26.75
Door 30.95
27.86
27.98 C.B.
27.97
Arch St.
1
2

Monday P.M. 4

PROFILE OF FRONT

SHELDON STREET TO STATE

HORIZONTAL SCALE 1" =
VERTICAL SCALE 1" =

Note:- West Curb is shown in Black.
Stations measured on W. Curb

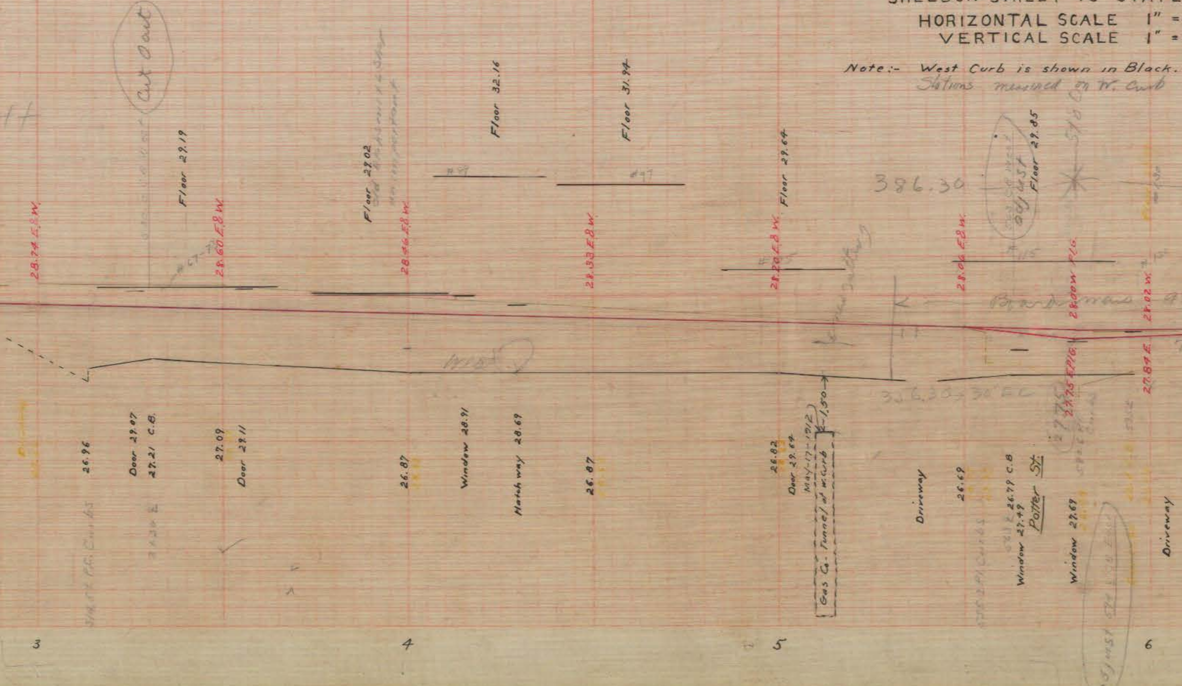

Cut Out
28.74 E.8 W.
Floor 29.19
28.60 E.8 W.
Floor 29.02
28.46 E.8 W.
#49
Floor 32.16
28.33 E.8 W.
#47
Floor 31.94
28.20 E.8 W.
Floor 29.64
386.30
28.06 E.8 W.
#115
adjust
Floor 29.85
28.00 W. P.I.G.
28.02 W.
27.75 E.P.I.G.
27.84 E.
26.96
Door 29.07
27.21 C.B.
27.09
Door 29.11
26.87
Window 28.91
Hatchway 28.69
26.87
26.82
Door 29.64
May-17-1912
Gas Co. Tunnel at W. Curb
1.50
Driveway
26.69
26.79 C.B
Window 27.49
Potter St.
Window 27.69
Driveway
3
4
5
6

Ace 18

STREET
STREET.
20'
2'

Showing Curbs Doors Windows Etc

East Curb in Green.

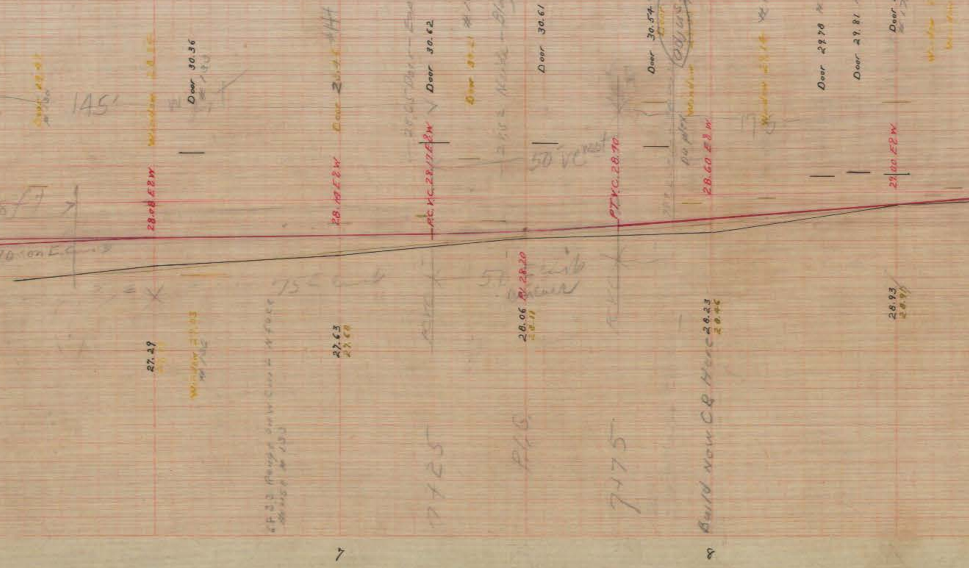
Door 30.36
Door 30.62
Door 30.61
Door 30.54 #158
Door 29.78 #167
Door 29.81 #169
Door 29.80
Window
145'
28.08 E&W
28.18 E&W
PC VC 28.17 E&W
PT VC 28.70
28.60 E&W
29.00 E&W
50 VC
75
27.29
27.63
28.06
28.23
28.93
Window
CB 33 Ready on W Curb
7+25
PG
7+75
Build New CB Here
7
8

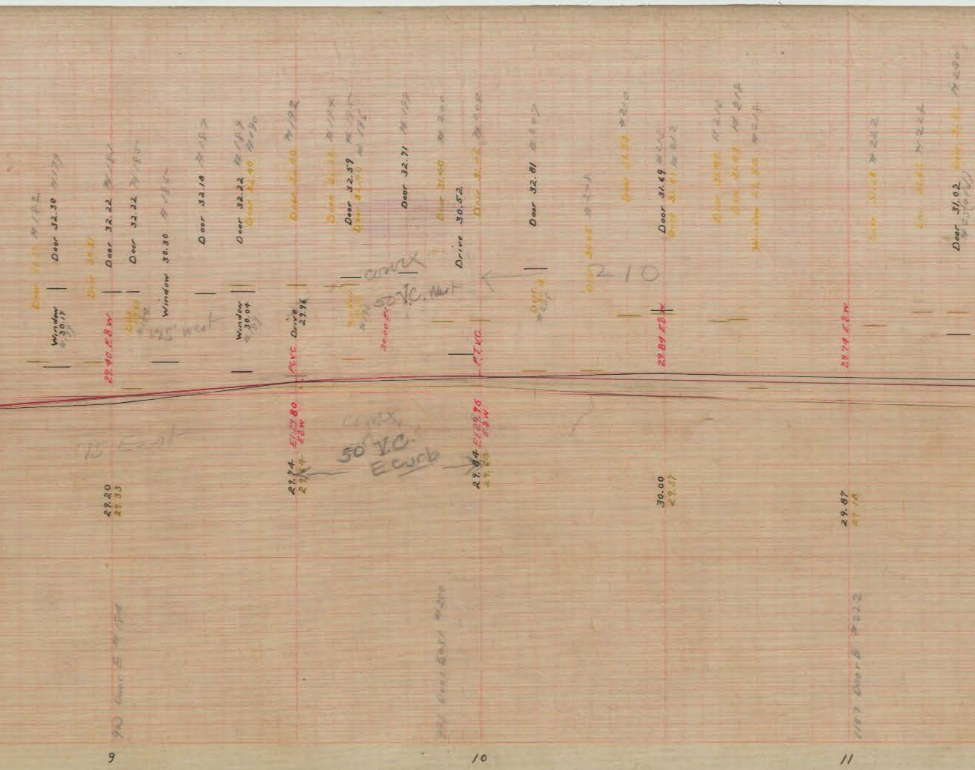
Door 32.30
Window 30.17
29.40 E8W
Door 32.22
Door 32.22
Window 30.30
175' West
Door 32.18
Door 32.22
Window 30.04
P.V.C.
Drive 29.96
Door 32.59
Door 32.71
Drive 30.52
P.T.V.C.
convex
50' V.C. West
Door 32.81
210
Door 31.69
29.89 E8W
29.74 E8W
Door 31.02
175' East
E/29.80 E8W
29.74
convex
50' V.C. E curb
E/29.75 E8W
29.84
29.20
29.33
30.00
29.57
29.87
9
10
11

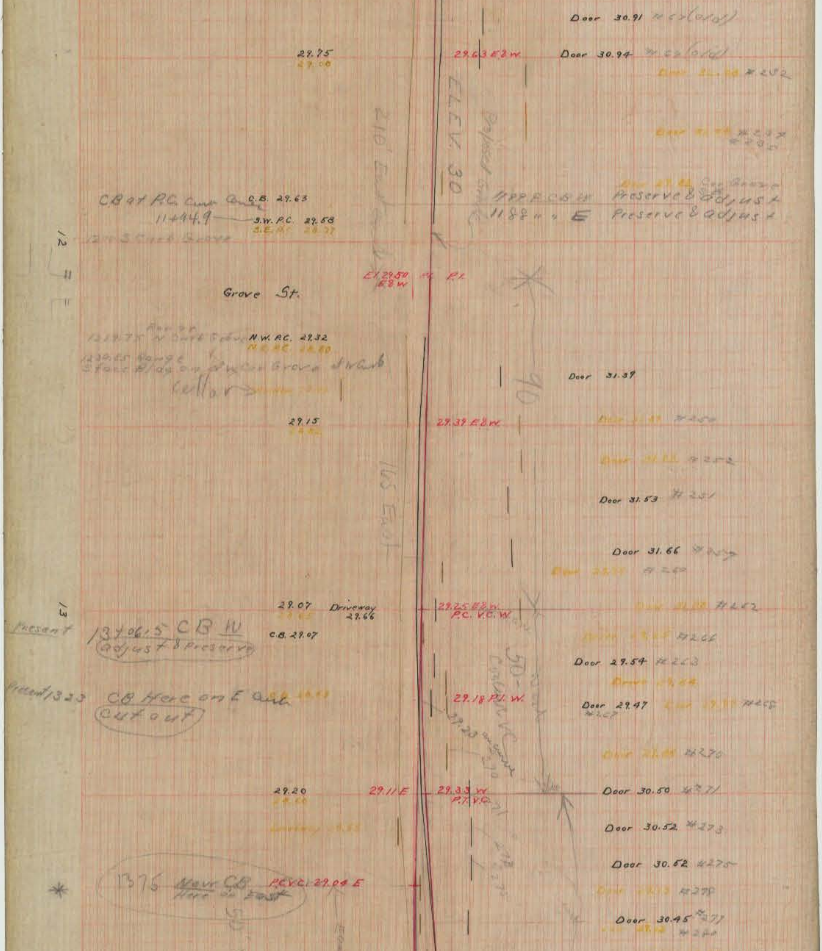

Door 30.91 #52 (old)
29.75
29.00
29.63 E2W
Door 30.94 #52 (old)
#252
ELEV. 30
Proposed Grade
210' East
#257
#255
Car Barn
1188 R.C.B. W Preserve & adjust
1188 " " E Preserve & adjust
CB at P.C. Curb Corner C.B. 29.63
11+44.9 S.W. P.C. 29.58
S.E. P.C.
12
11
El. 29.50 E.&W. P.I.
Grove St.
N.W. P.C. 29.32
N.E. P.C.
Garage
Store Bldg on Grove St. curb
Cellar
90
Door 31.39
29.15
29.39 E&W
#250
#252
165 East
Door 31.53 #251
Door 31.66 #257
#260
13
29.07 Driveway 29.66
29.25 E&W
P.C. V.C. W
#262
#266
Present
13+06.5 CB W
adjust & preserve
C.B. 29.07
Door 29.54 #263
50-
Curve V.C.
Present 1323
CB Here on E curb
cut out
29.18 P.I. W.
Door 29.47 #267
#268
29.23
#270
29.20
29.11 E
29.33 W
P.T. V.C.
Door 30.50 #271
Door 30.52 #273
Door 30.52 #275
1375 New CB
Here on East
P.C.V.C. 29.04 E
#278
Door 30.45 #277
#280

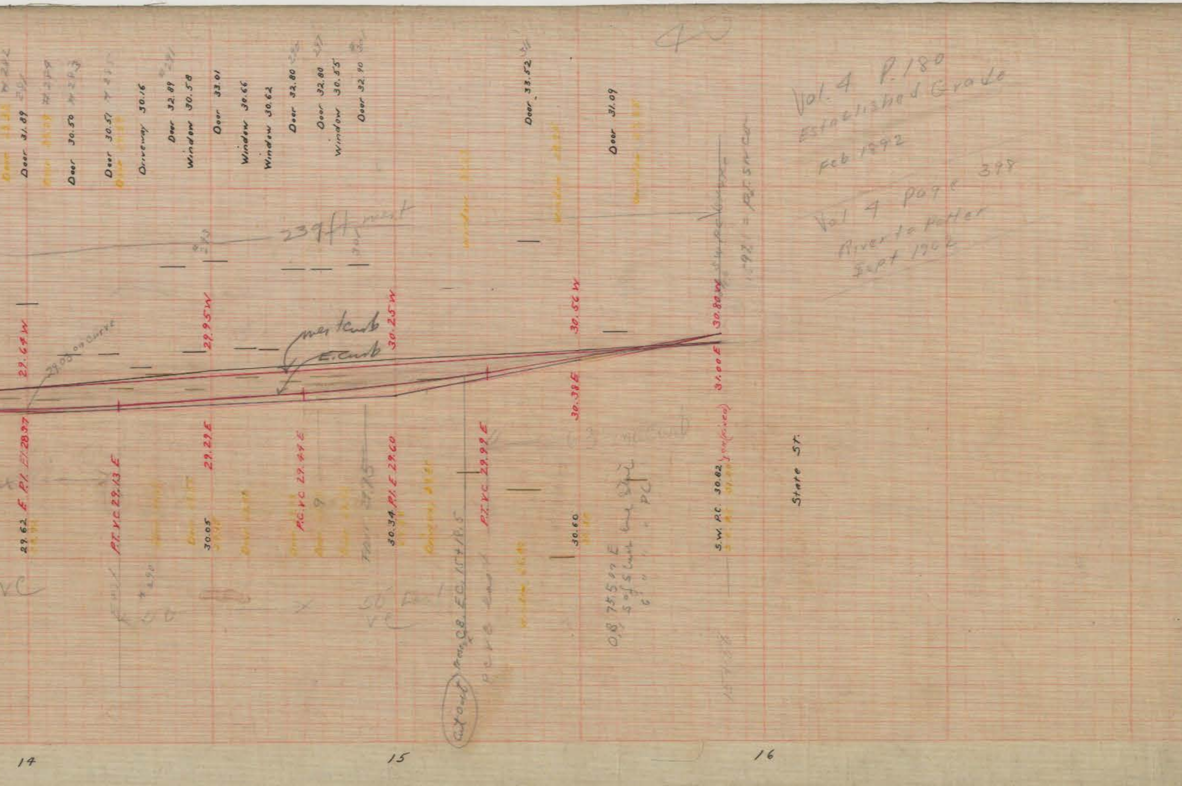

Door 31.89
Door 30.50
Door 30.51
Driveway 30.16
Door 32.89
Window 30.58
Door 33.01
Window 30.66
Window 30.62
Door 32.80
Door 32.80
Window 30.55
Door 32.90
Door 33.52
Door 31.09
29.64 W
29.95 W
30.25 W
30.56 W
30.80 W
29.62 E P.I. E 28.97
P.T. V.C 29.13 E
29.29 E
30.05
P.C. V.C 29.49 E
30.34 P.I. E 29.60
P.T. V.C 29.99 E
30.38 E
31.00 E
30.60
S.W. P.C. 30.82
State St.
29.00 on curve
W curb
E. curb
239 ft west
Cut out
0.8 75.5 99 E
Vol. 4 P. 180
Established Grade
Feb 1892
Vol 4 page 398
Rivers to Potter
Sept 1904
14
15
16