
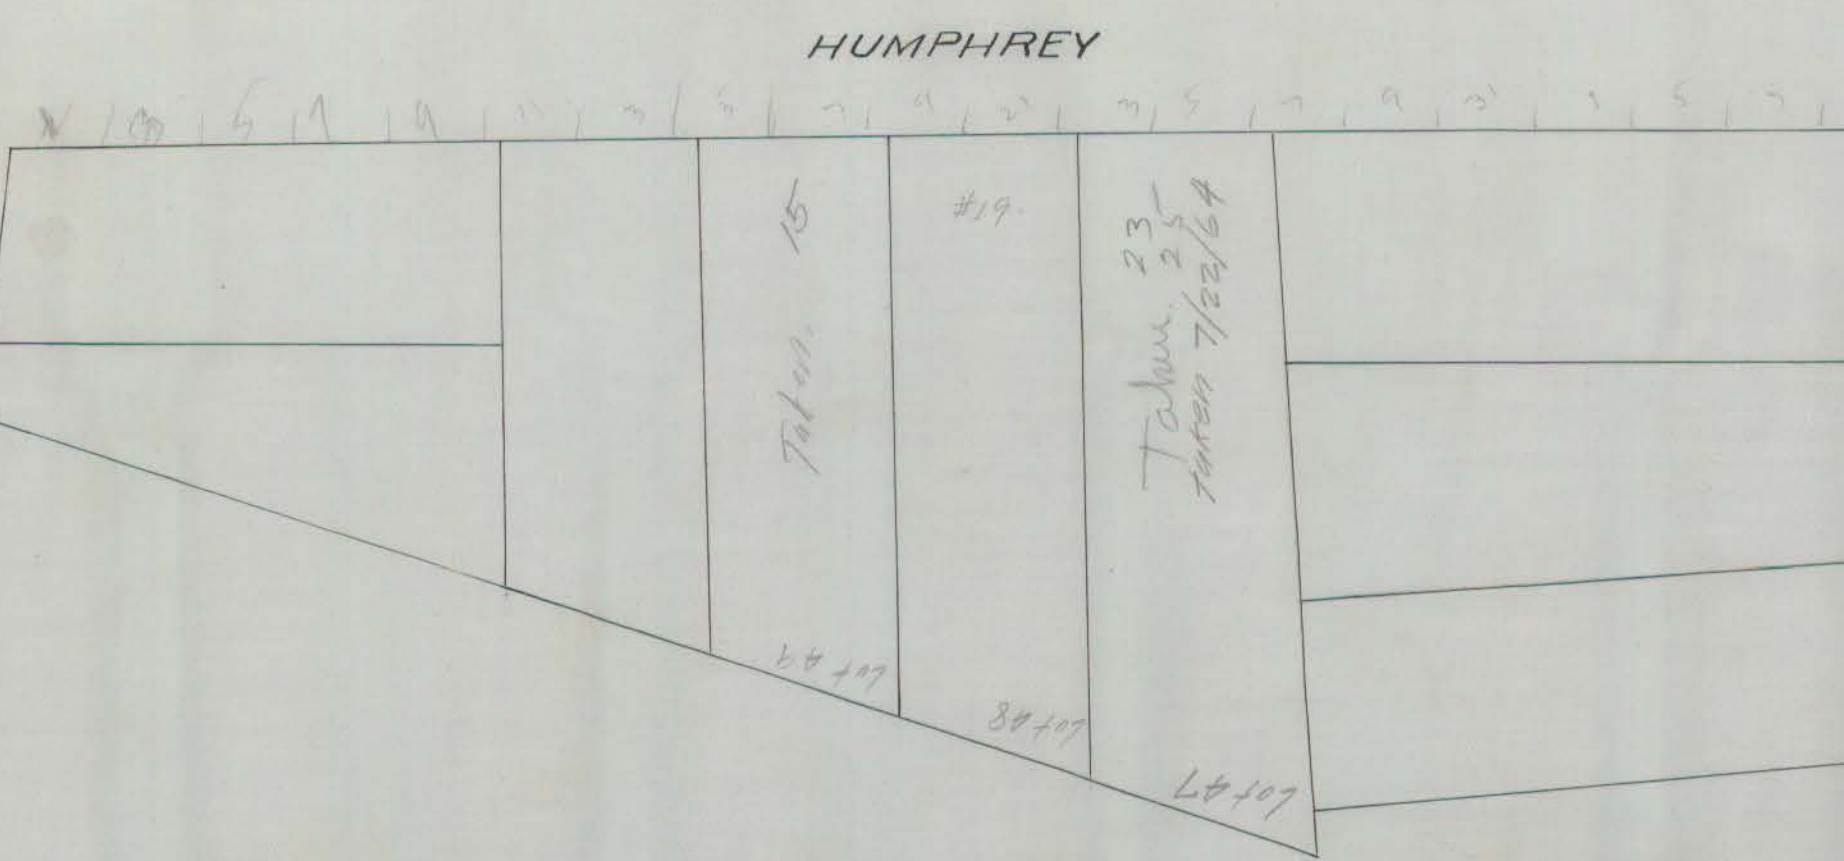





OLIVER ST

ST

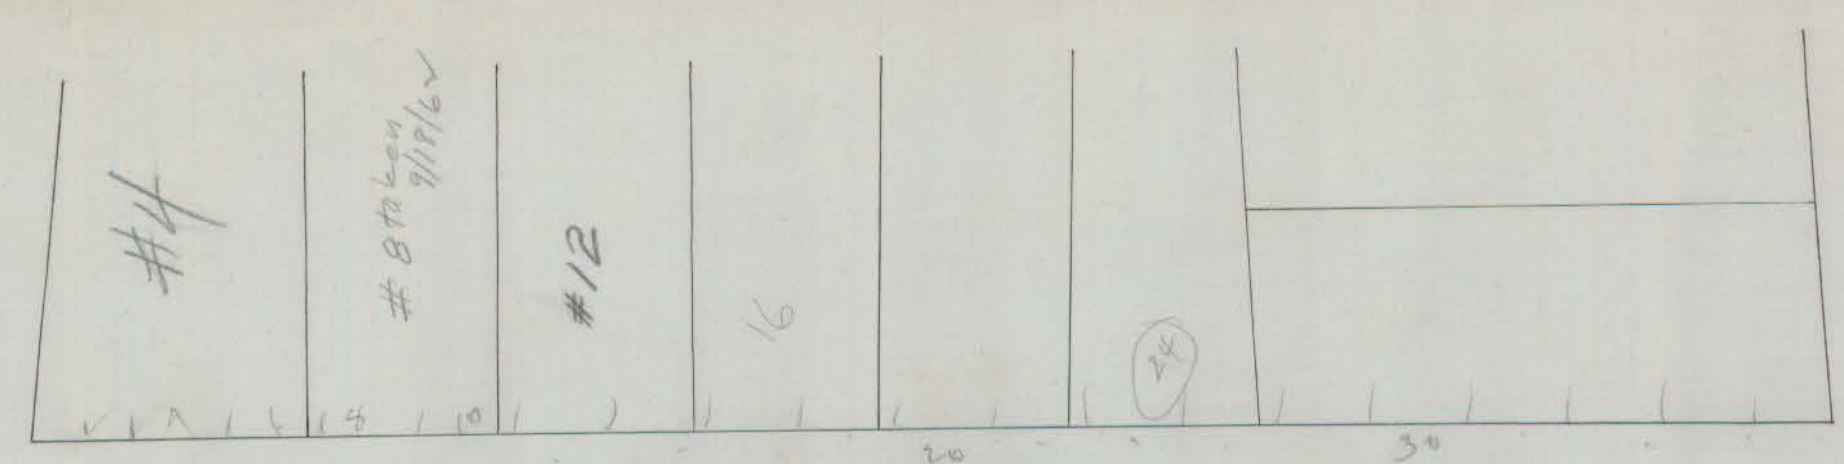

HUMPHREY and KELSEY STREET PLAN
for
STREET NUMBERS
SCALE 1"=50' JUNE 1915
NUMBERS -25'

WHITE STREET

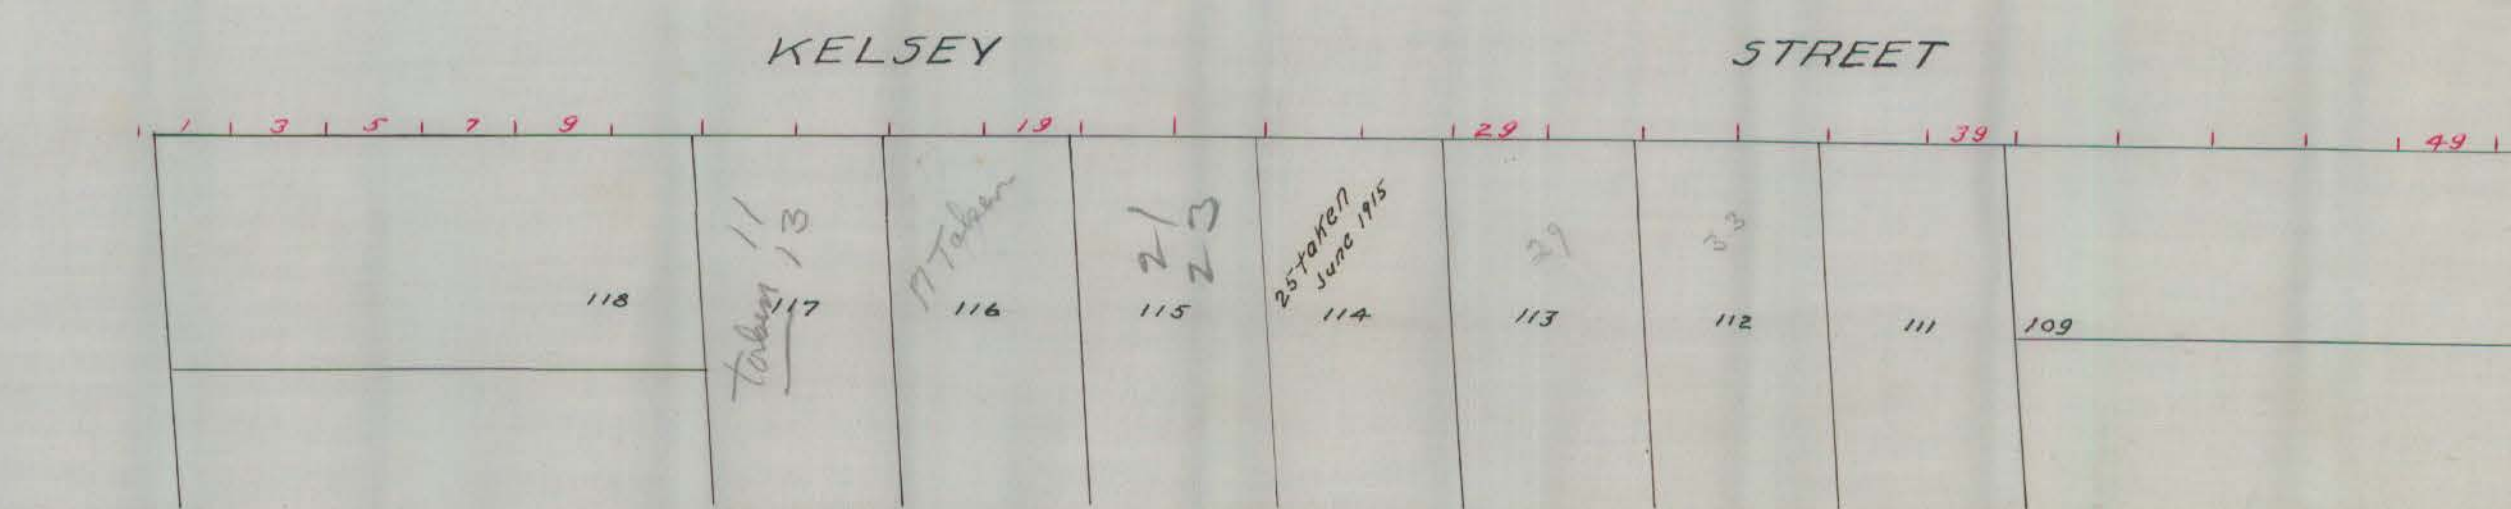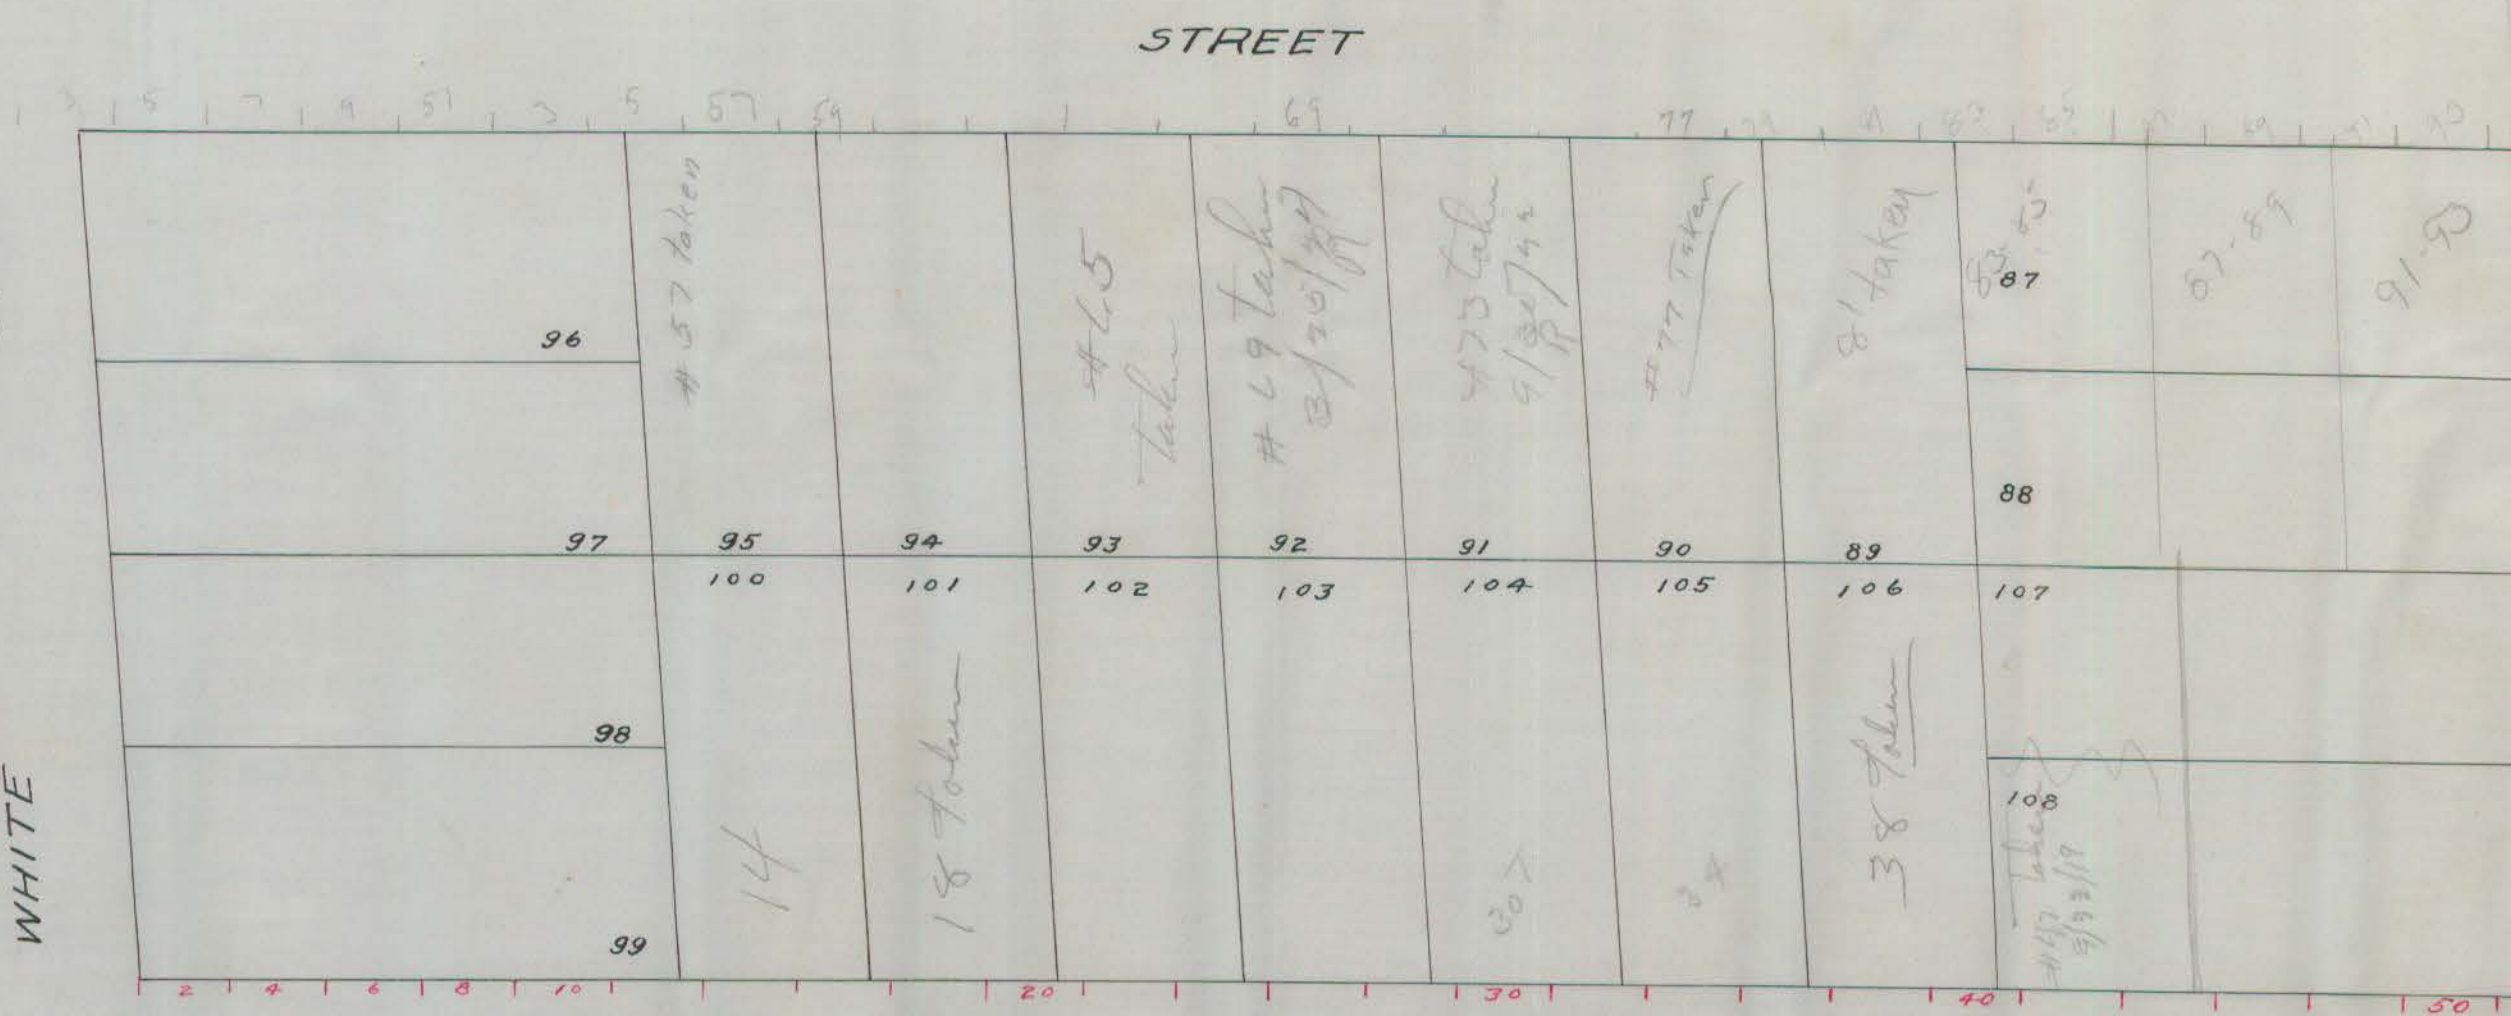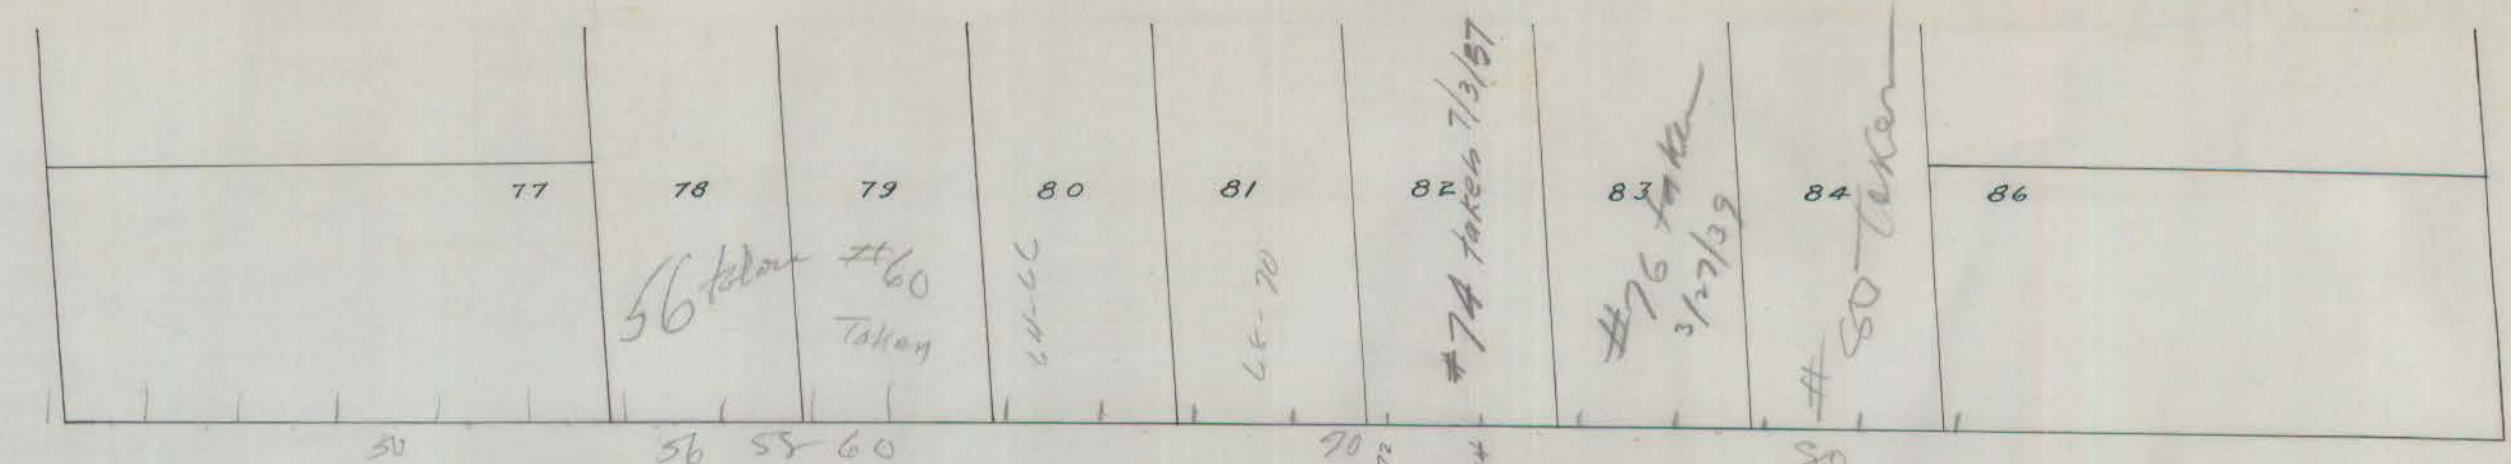

WHITE STREET

LINNMOORE STREET

KELSEY STREET

STREET