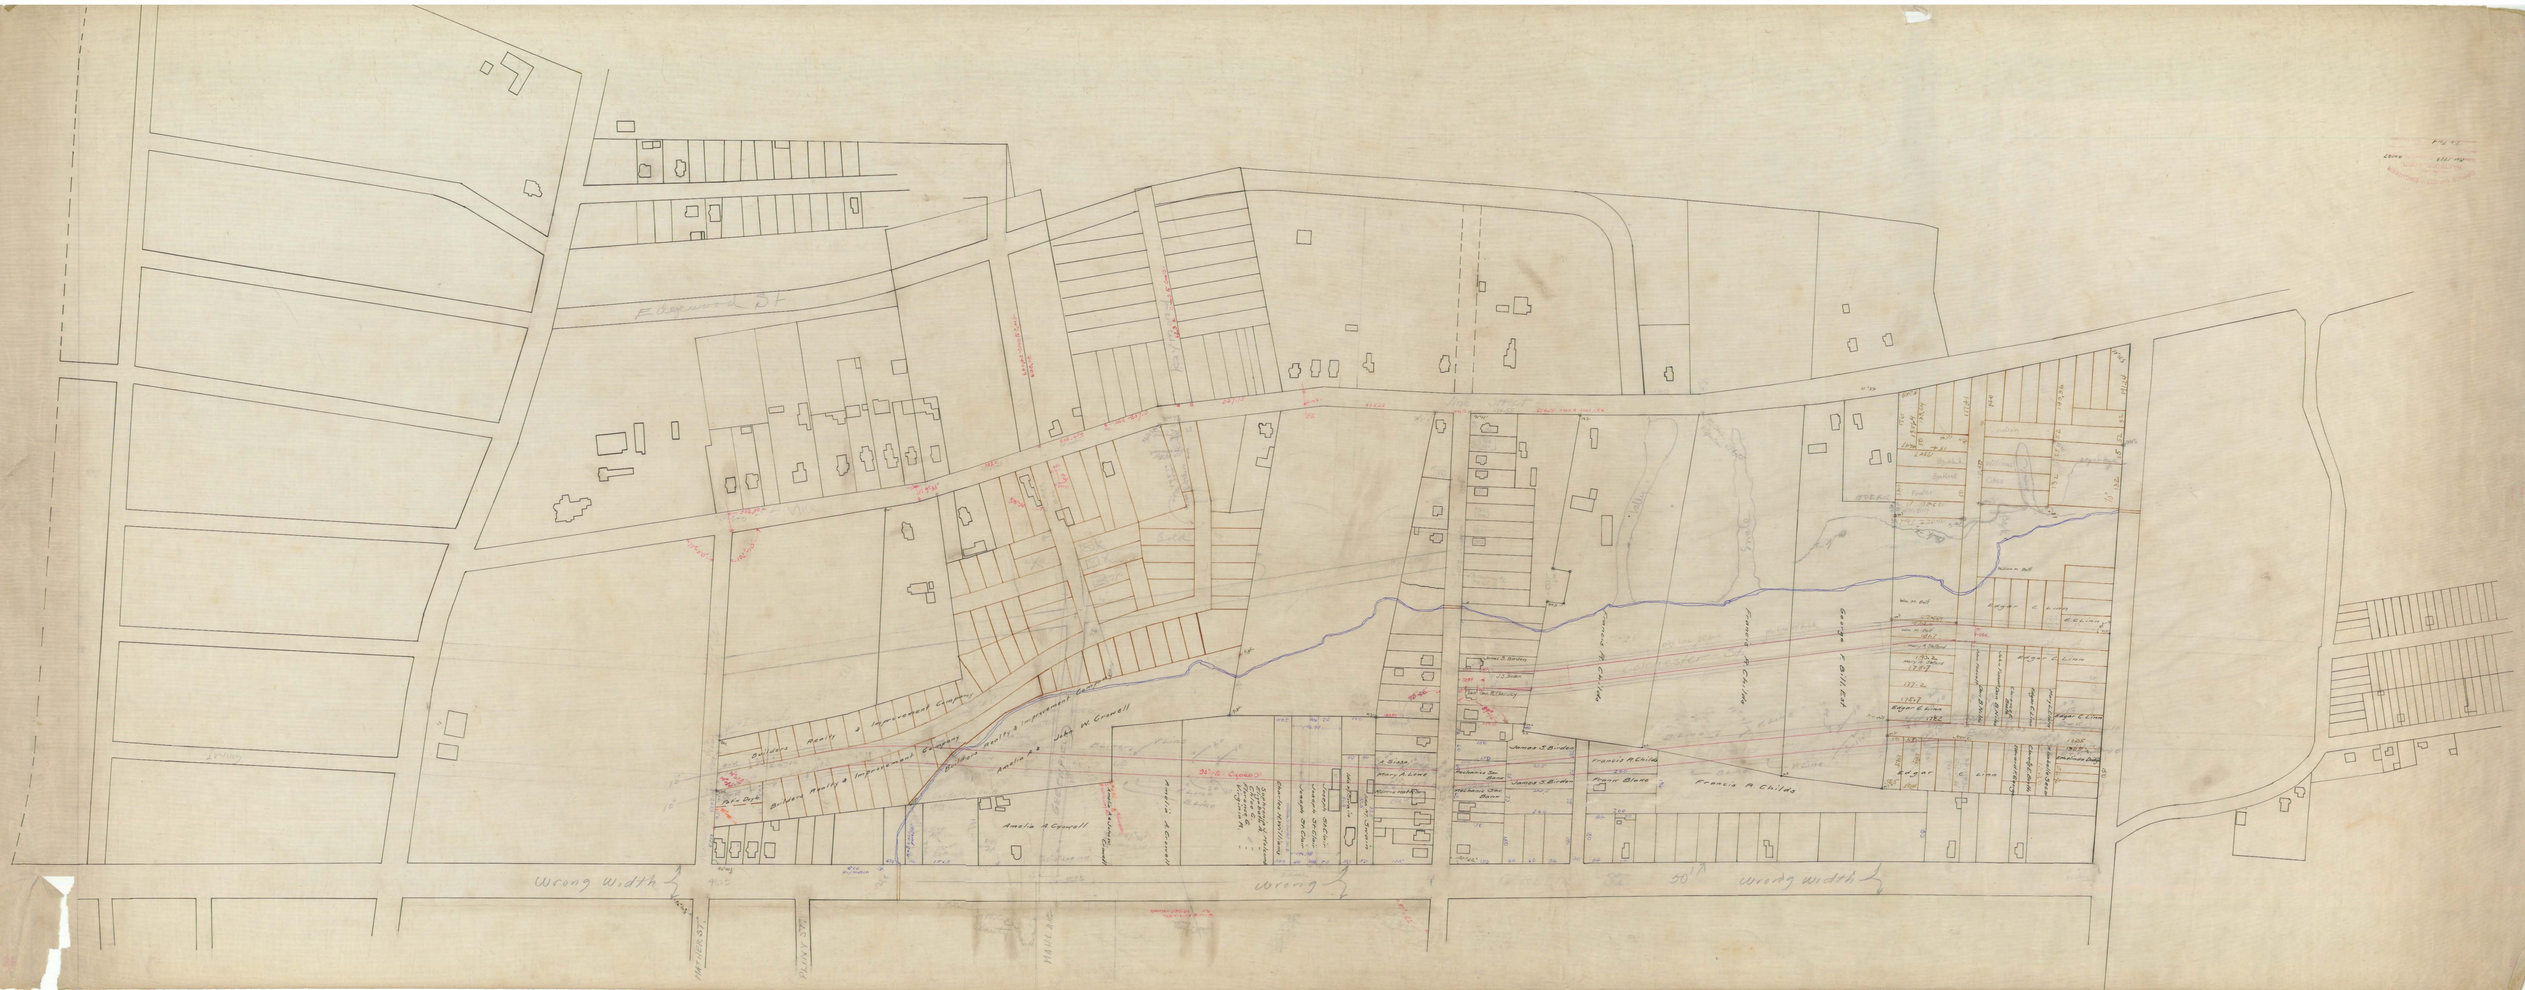
E. Dogwood St
Wrong Width
Wrong
Wrong Width
Miller St
Amelia A. Crowell
Francis A. Childs
Edgar C. Lines
James J. Birden