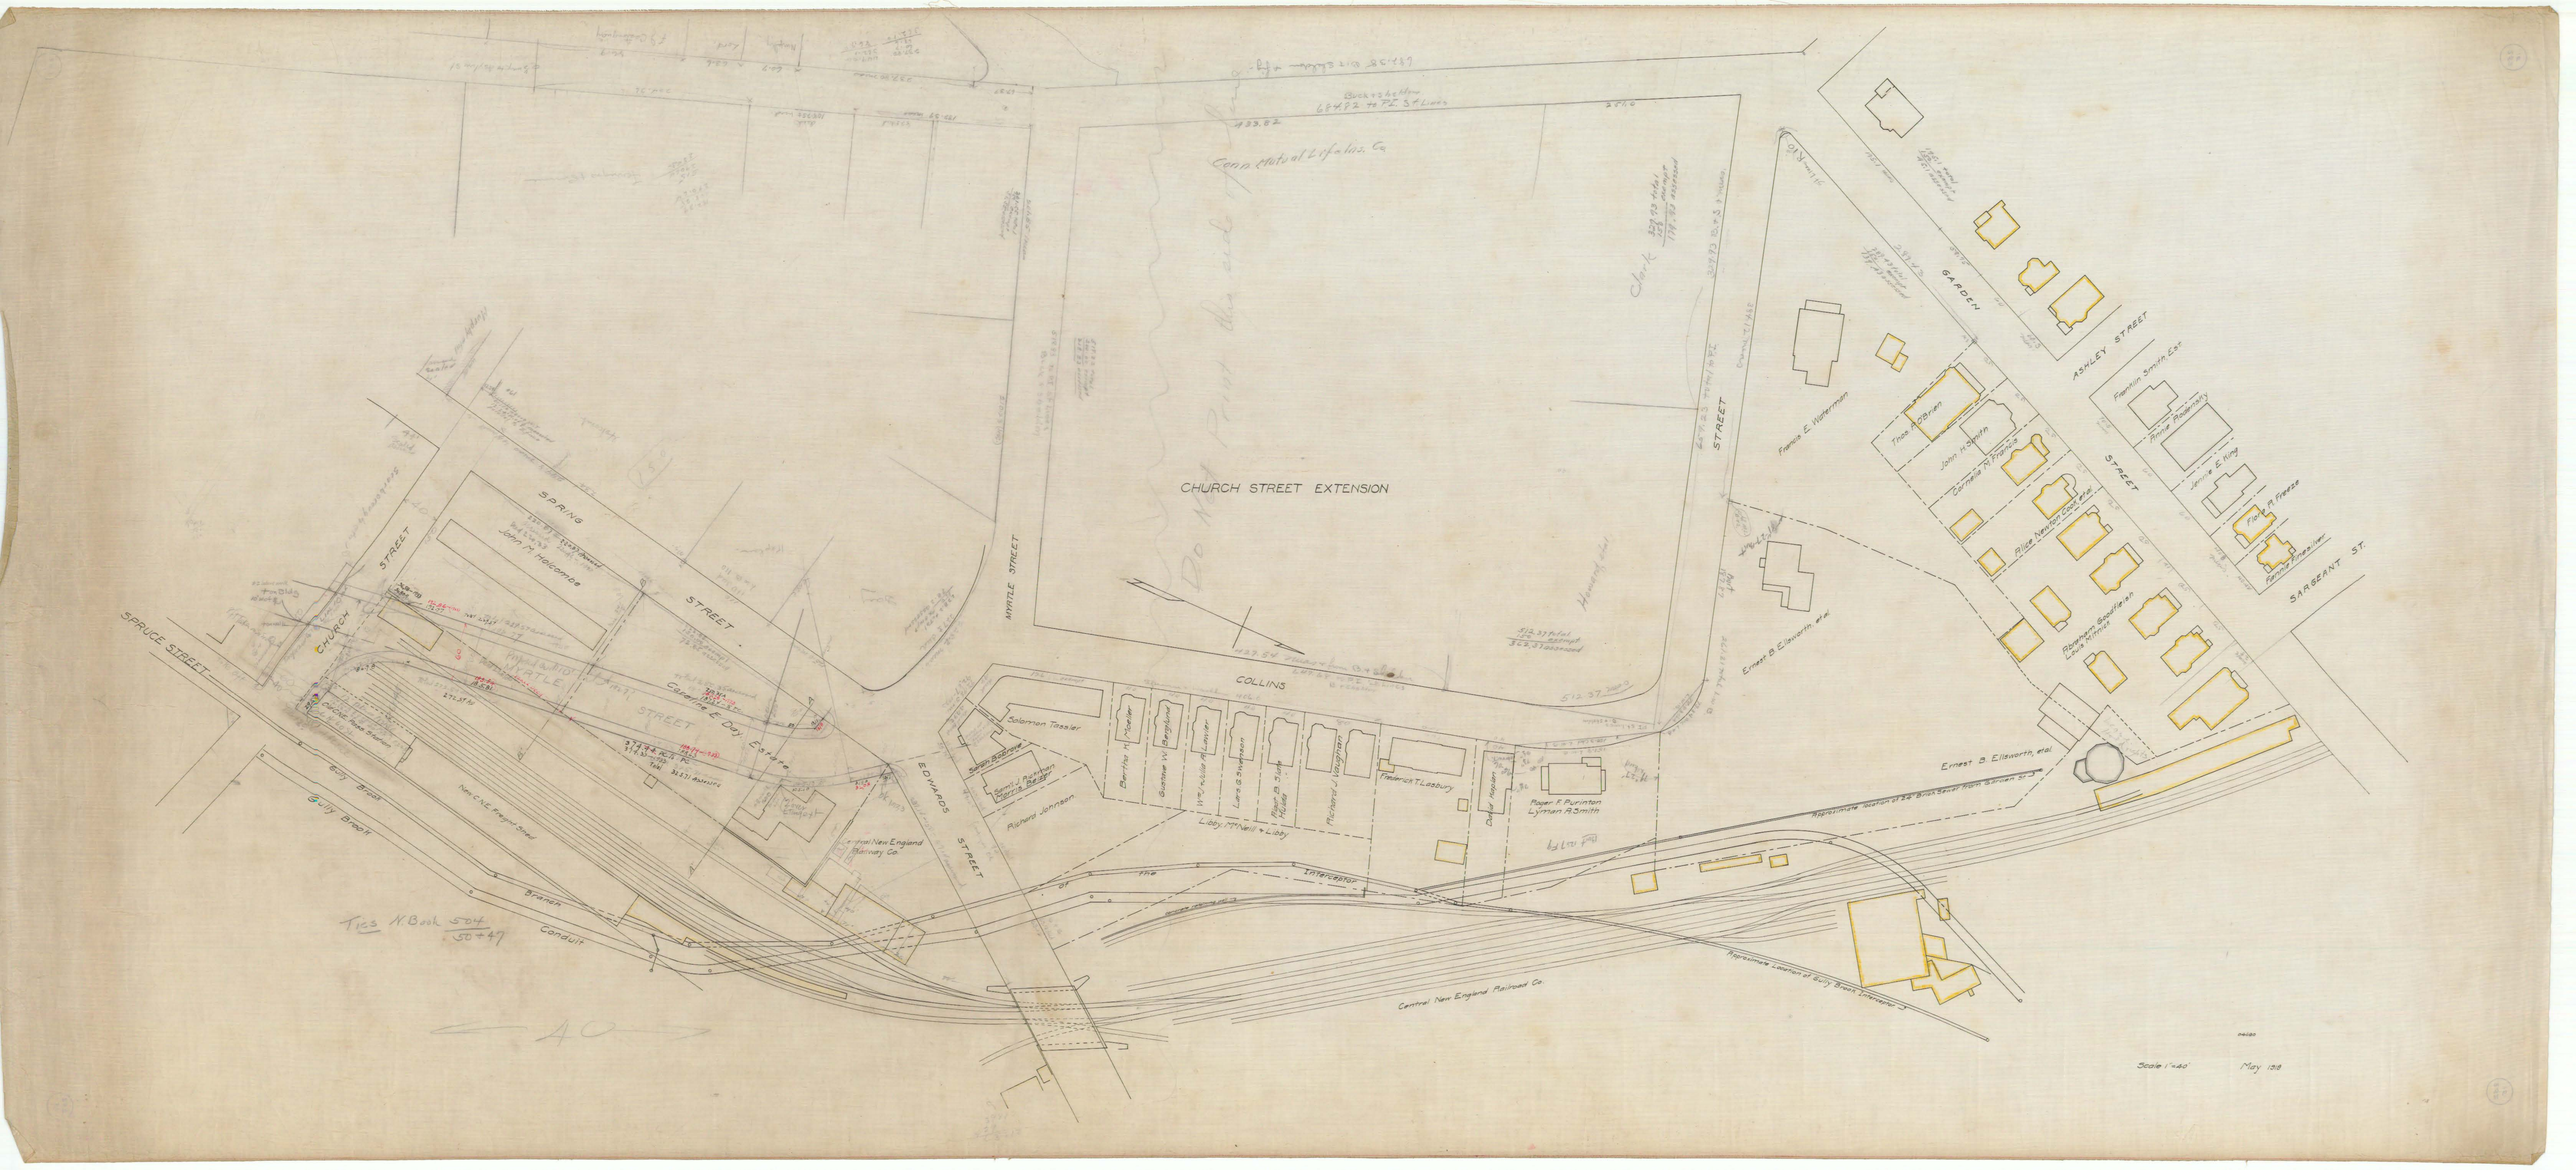
CHURCH STREET EXTENSION
Conn. Mutual Life Ins. Co.
Do Not Print this side
Clark
COLLINS
STREET
SPRING
STREET
CHURCH
STREET
SPRUCE STREET
EDWARDS
STREET
GARDEN
ASHLEY STREET
STREET
SARGEANT ST.
John H. Holcombe
Gazzaniga & Day, Estate
Solomon Tessler
Richard Johnson
Bertha H. Porter
Gaston W. Bergeron
Wm. Hale Munier
Lars G. Swanson
Peter B. Jude
Richard Vaughan
Frederick T. Lasbury
Roger F. Purinton
Lyman R. Smith
Liby, McNeil & Liby
Francis E. Waterman
Ernest B. Ellsworth, et al.
Thos. F. O'Brien
John H. Smith
Curtiss H. Prince
Alice Newton Cook Est.
Raymond Gaudiesen
Louis Nichols
Franklin Smith Est.
Frank Pudlowski
Jennie E. King
Fred H. Freeze
Harriet Fineseiler
Central New England Railway Co.
Gully Brook
Branch
Conduit
Interceptor
Approximate location of 24" Brick Sewer from Garden St.
Approximate location of Gully Brook Interceptor
Central New England Railroad Co.
Scale 1"=40'
May 1918