


DATE  
BY  
SCALE

51  
525  
15

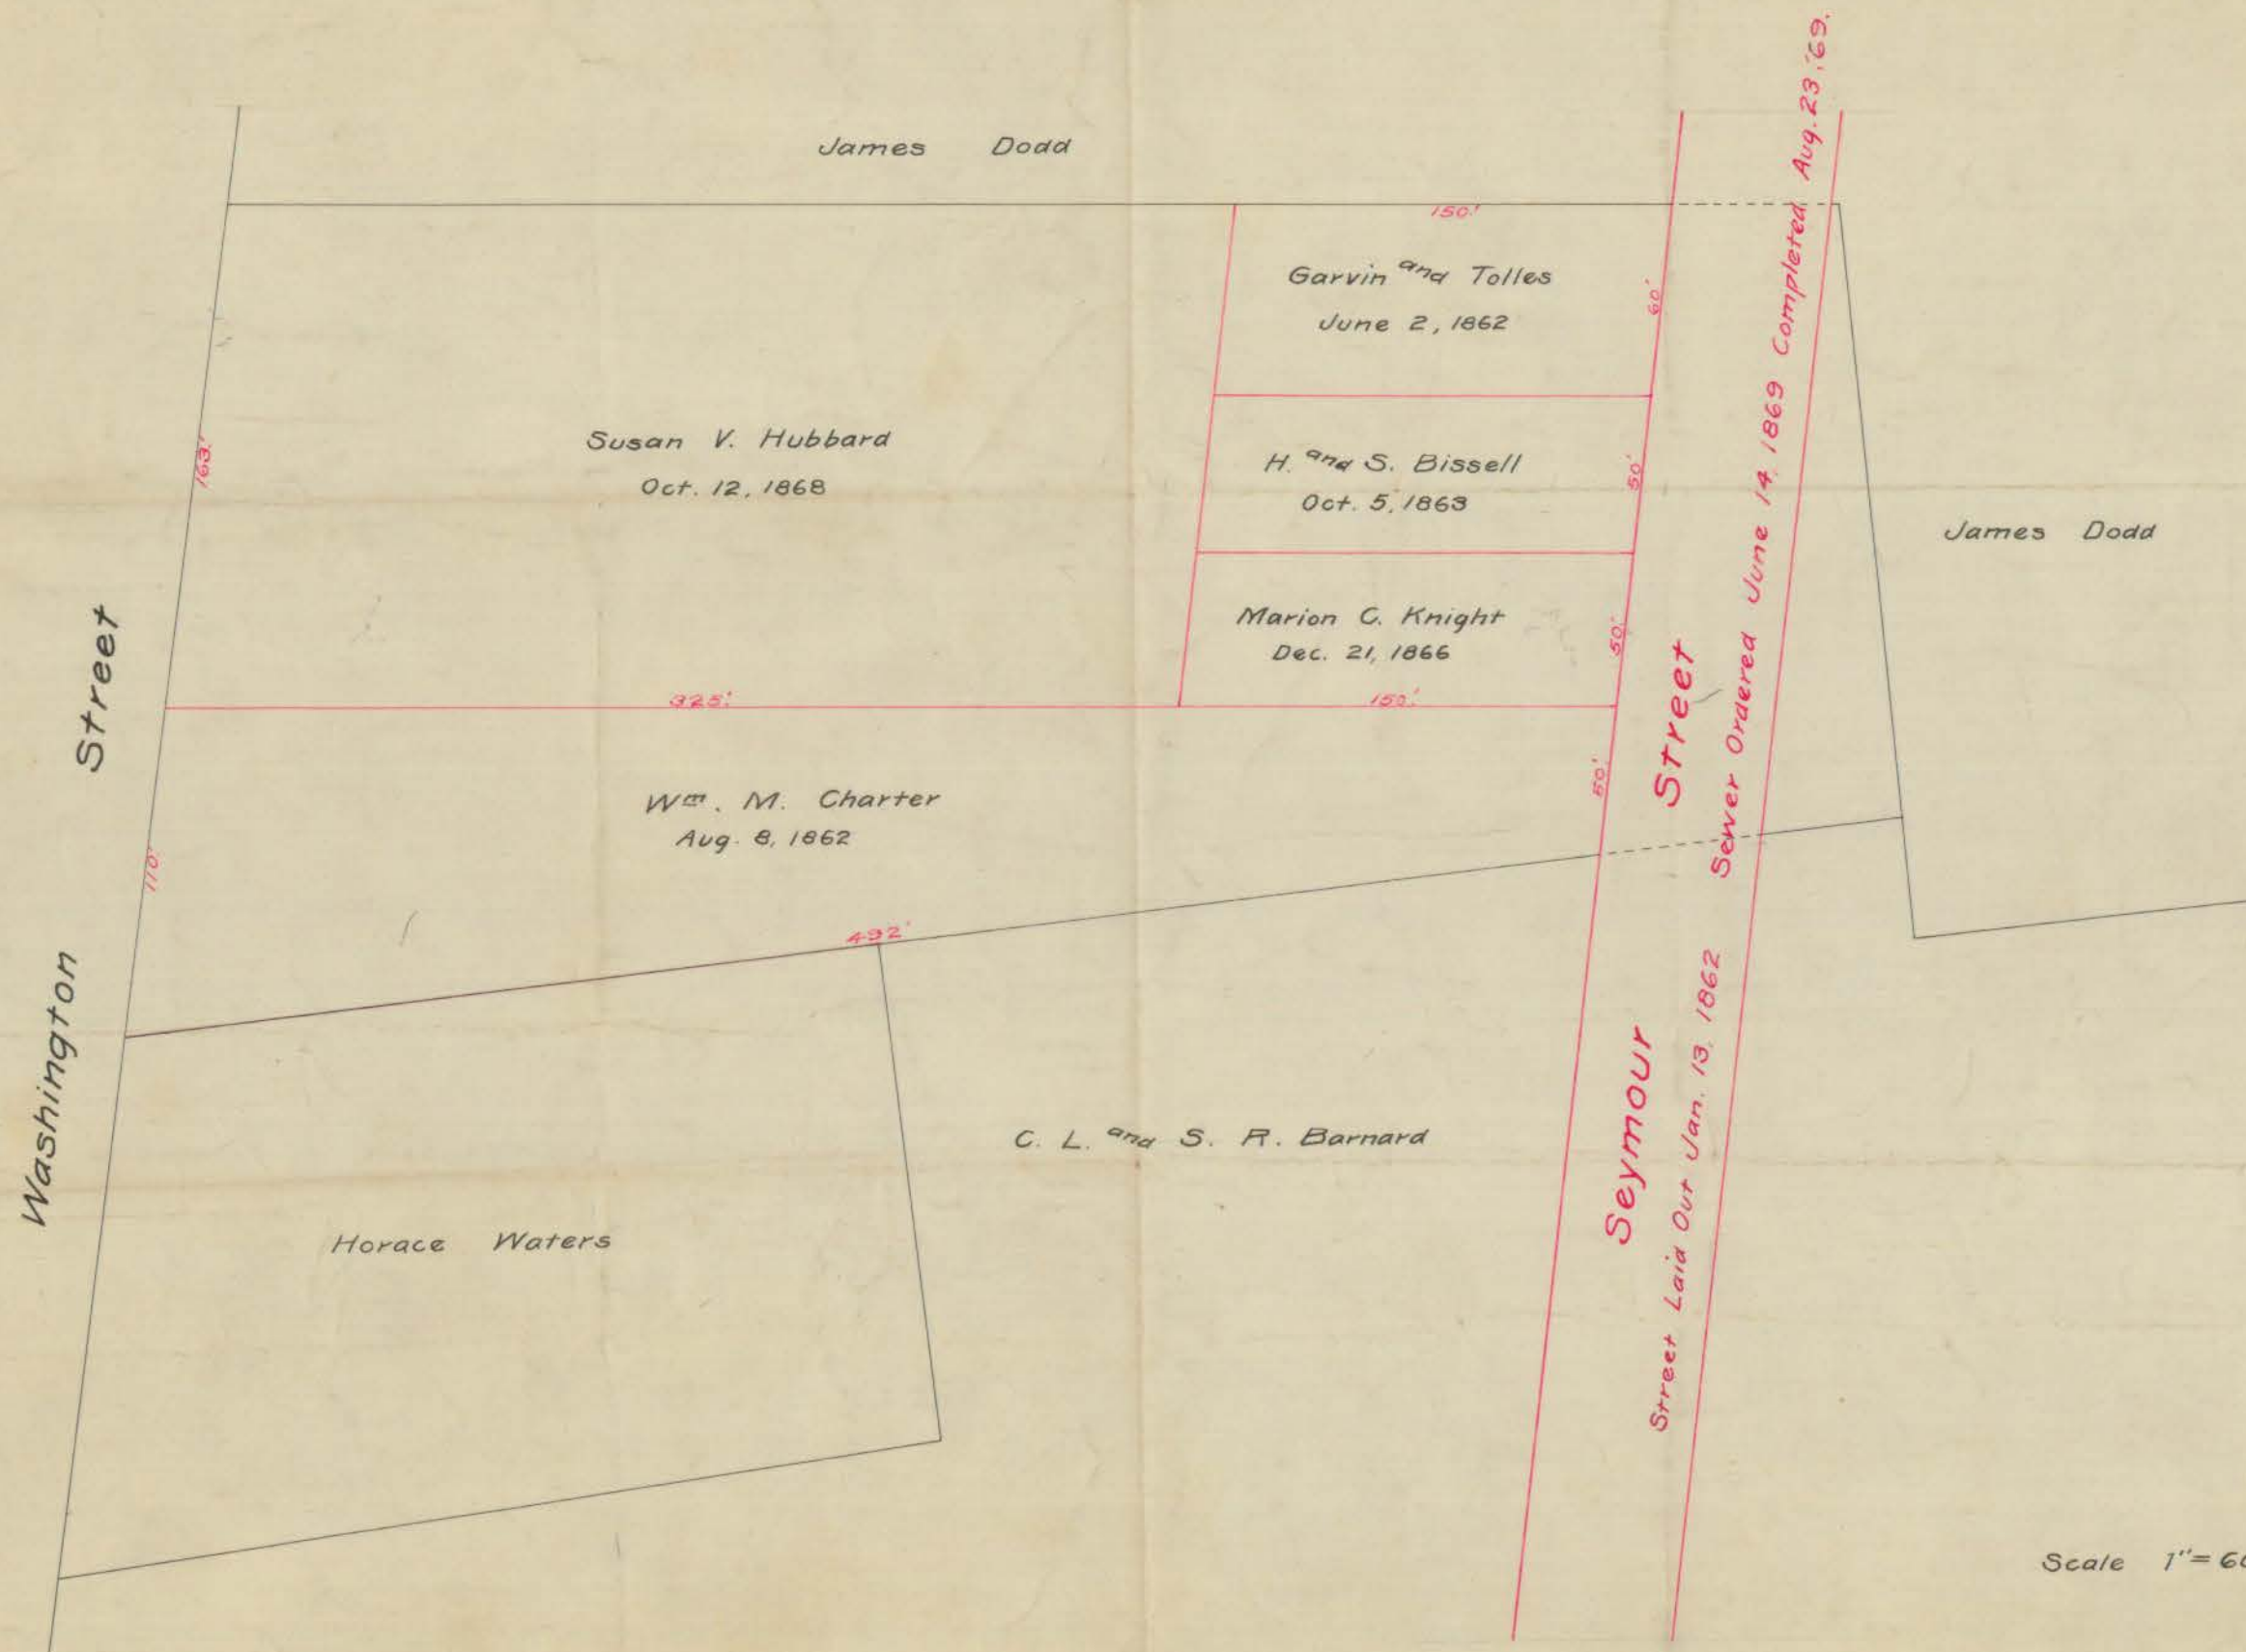

Scale 1" = 60'

51  
525  
15

OFFICE NO.  
DRAWER  
SHEET