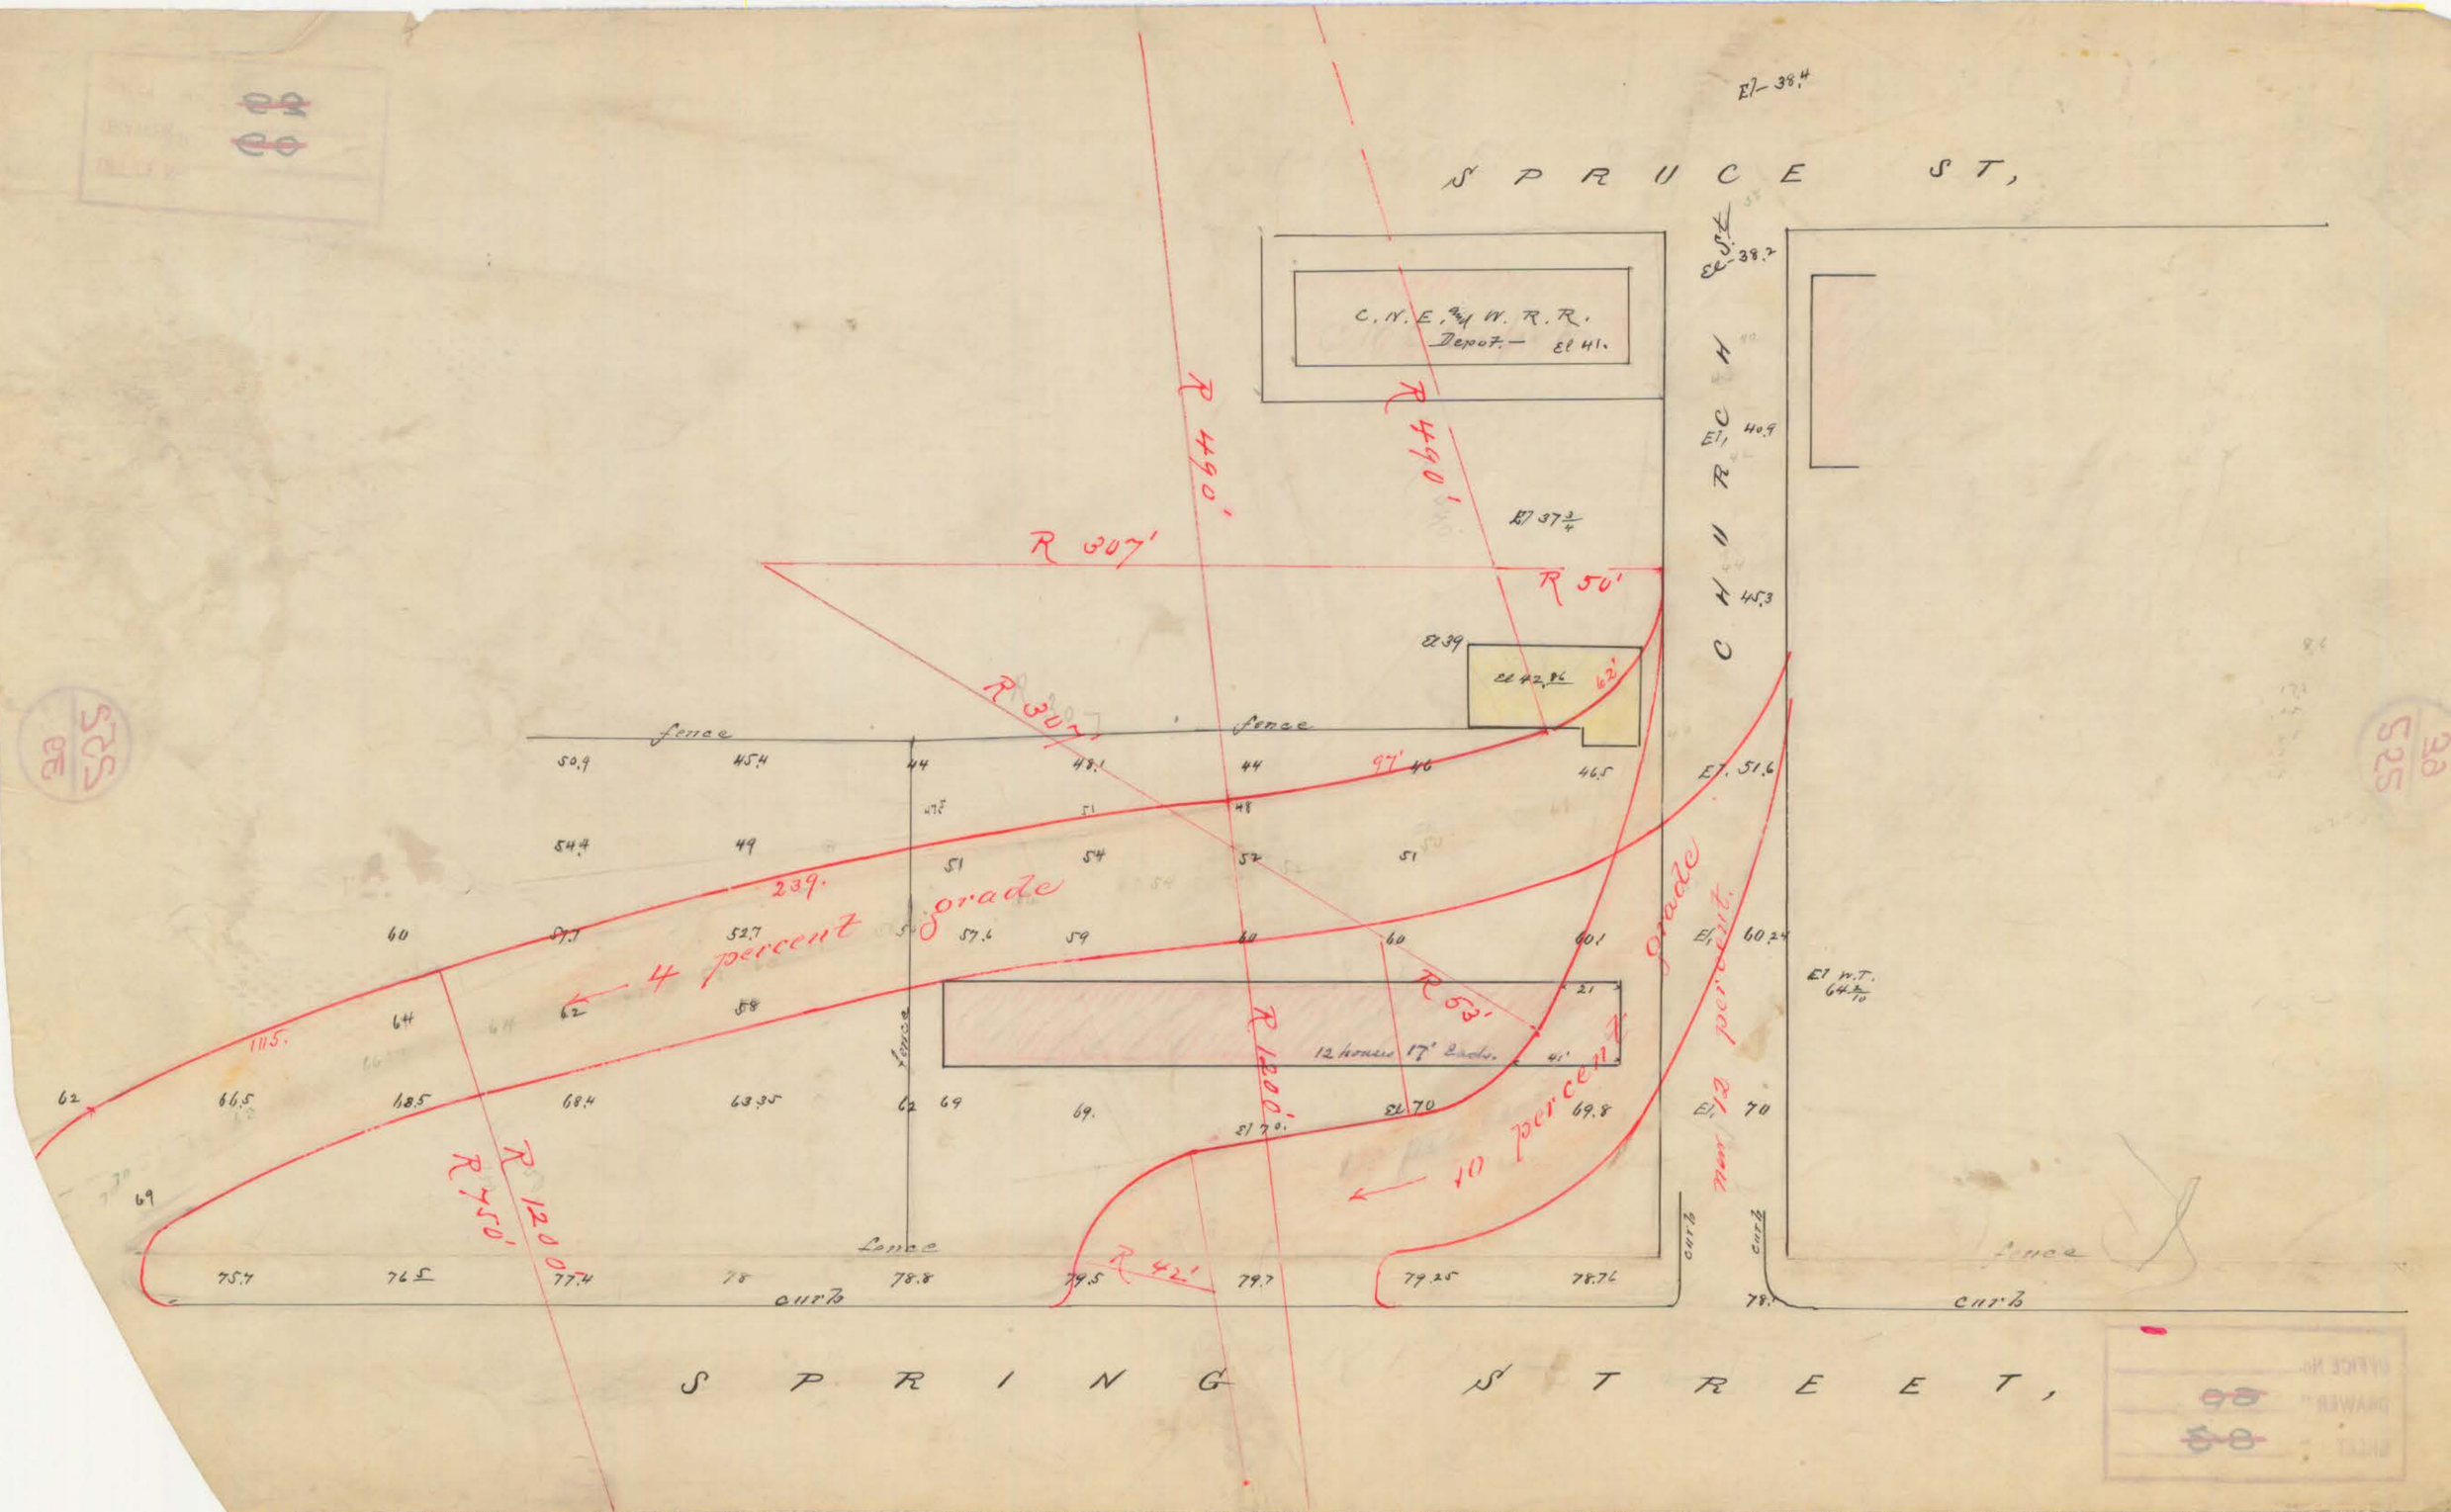
SPRUCE ST,
SPRING STREET,
CHURCH
C. N. E. & W. R. R. Depot. — El 41.
R 490'
R 490'
R 307'
R 50'
R 307'
R 63'
R 1200'
R 1200'
R 42'
239.
115.
4 percent grade
10 percent grade
12 houses 17' Lots.
fence
curb
El 38.4
El 38.2
El 40.9
El 37 3/4
El 45.3
El 39
El 42.86
El 51.6
El 60.24
El W.T. 64 7/10
El 70
El 69.8
El 70
El 69.
El 69
El 70.
El 78.
El 78.8
El 79.5
El 79.7
El 79.25
El 78.76
El 77.4
El 75.7
El 76.5
El 78
El 66.5
El 68.5
El 68.4
El 63.35
El 62
El 64
El 58
El 52.7
El 57.6
El 59
El 60
El 60.1
El 51
El 54
El 57
El 48
El 44.7
El 49
El 50.9
El 45.4
El 44
El 48.1
El 46
El 46.5
El 97'