


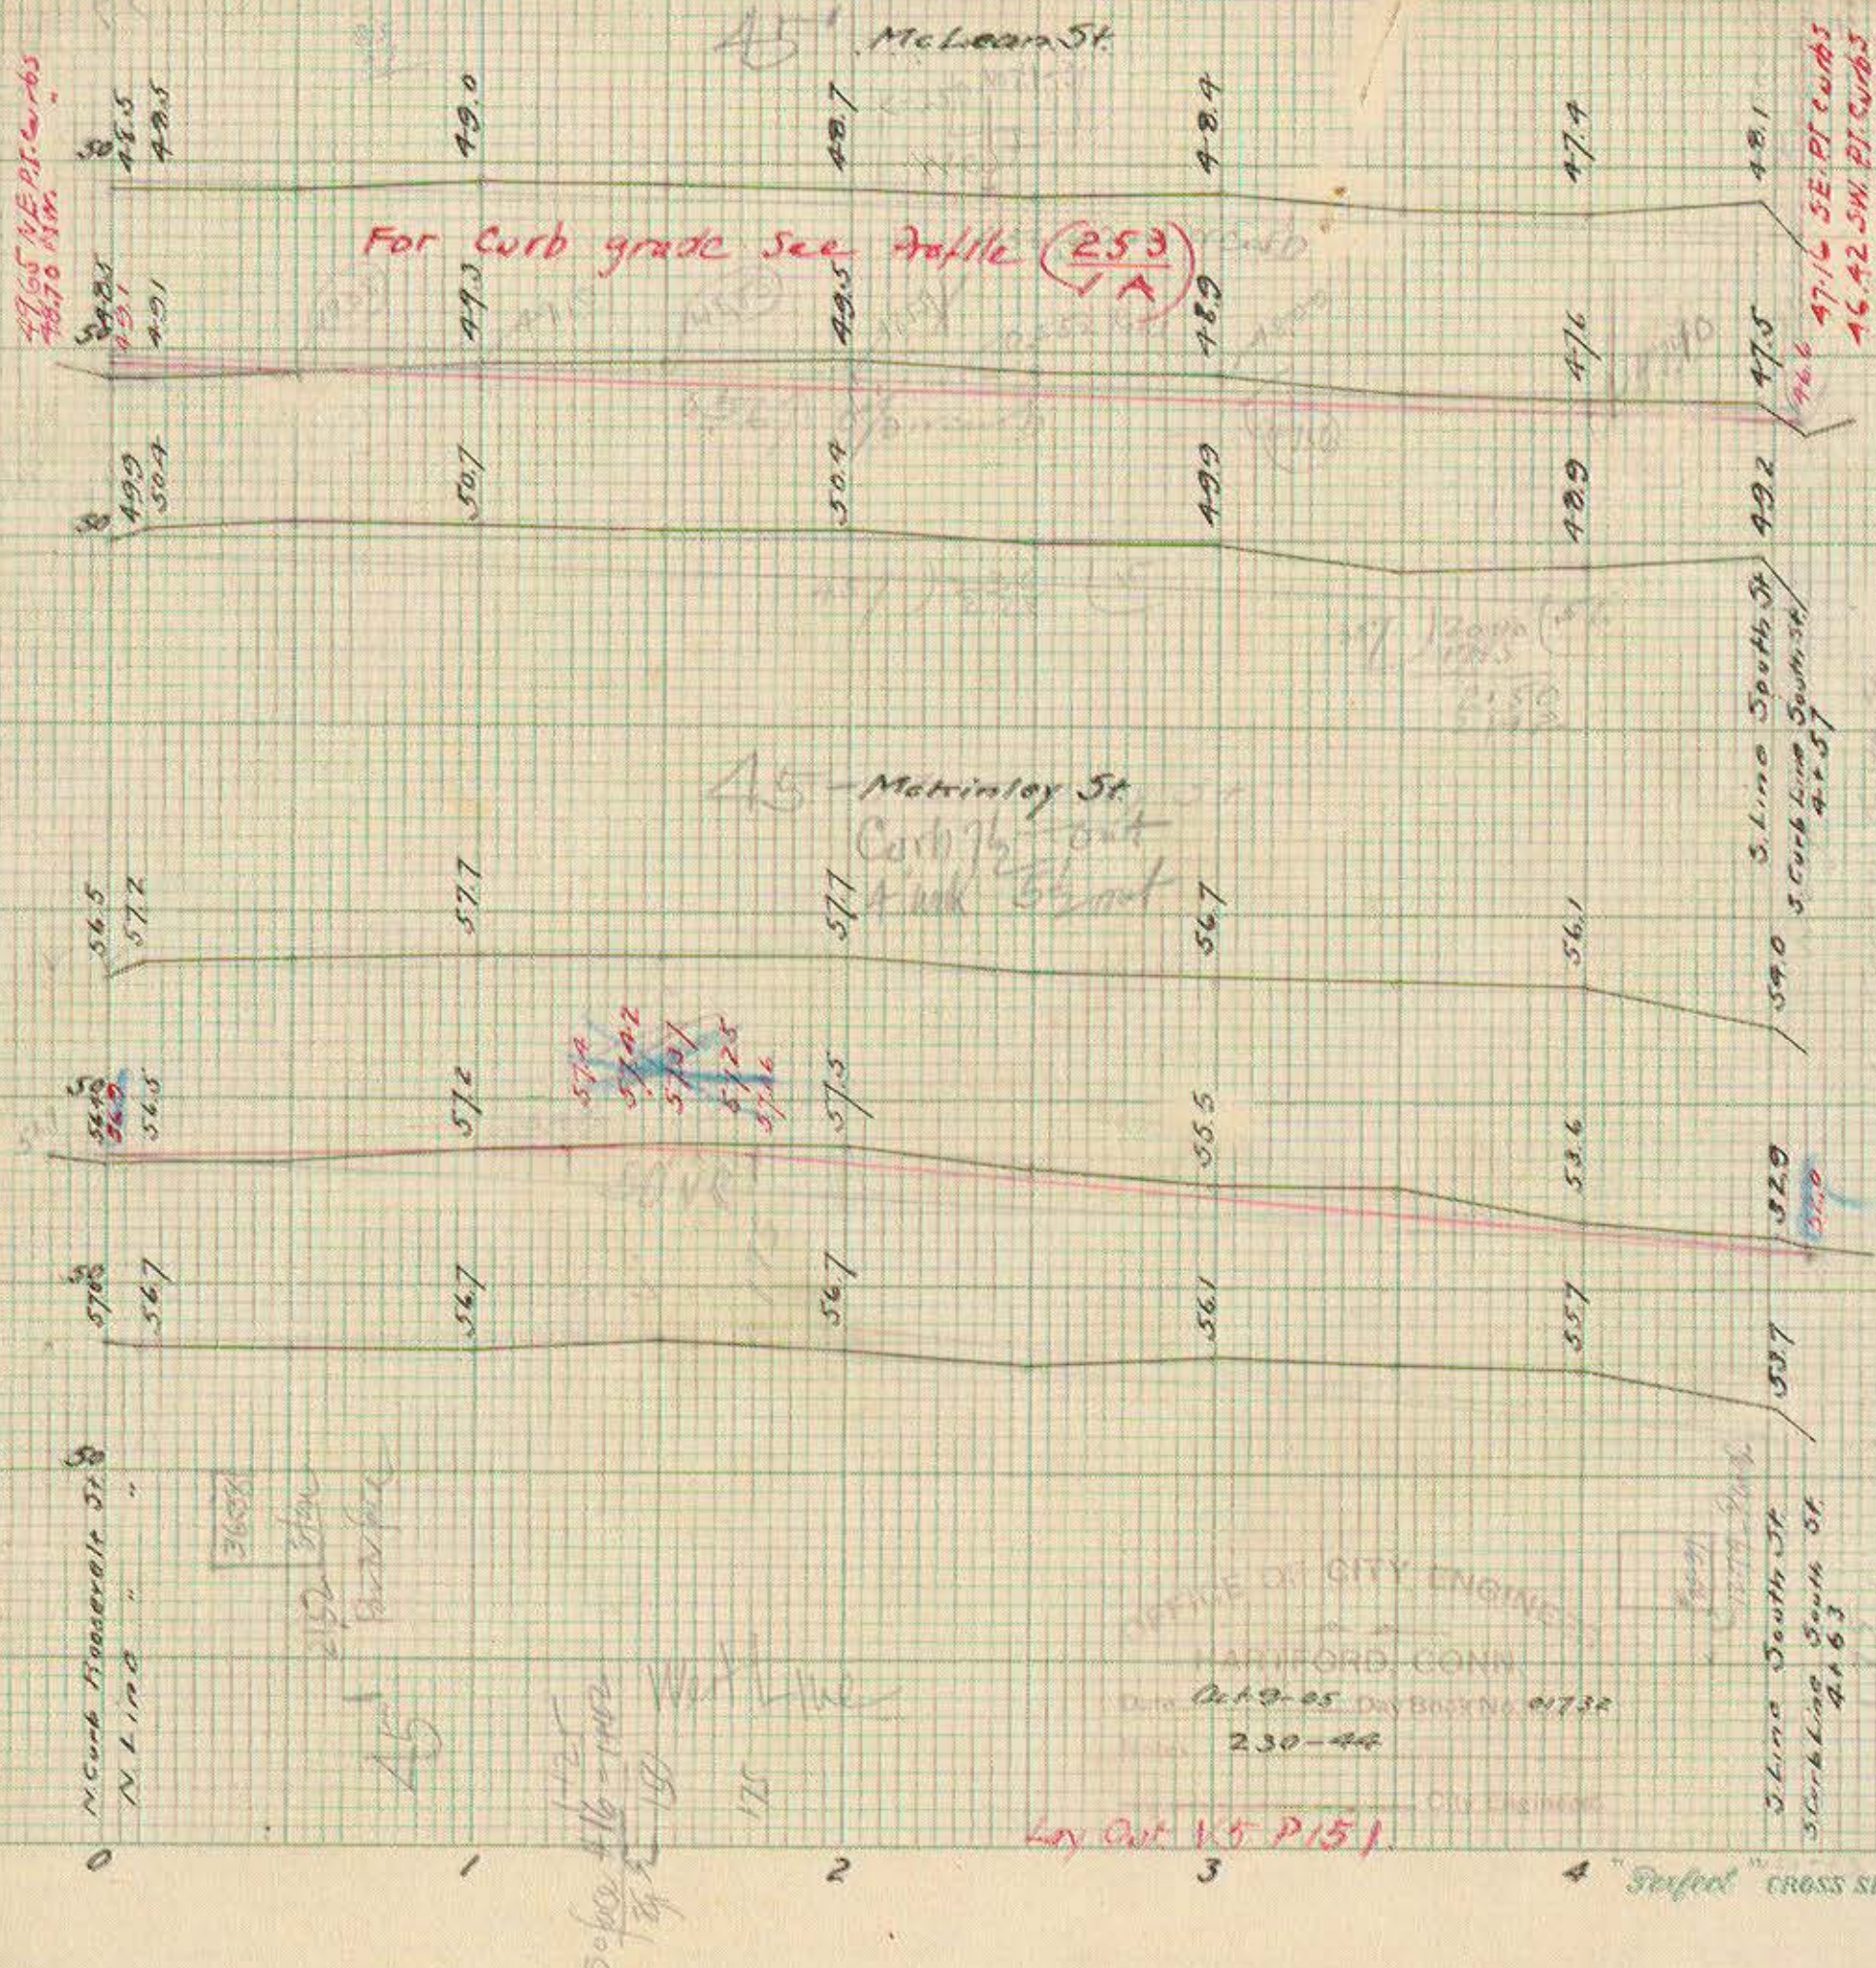

For curb grade see Profile (253) 1A

47.65 NE P.I. Curve
46.70 SW P.I. Curve
47.16 SE P.I. Curve
46.42 SW P.I. Curve