



500 400 300 200 100 0 -100 -200

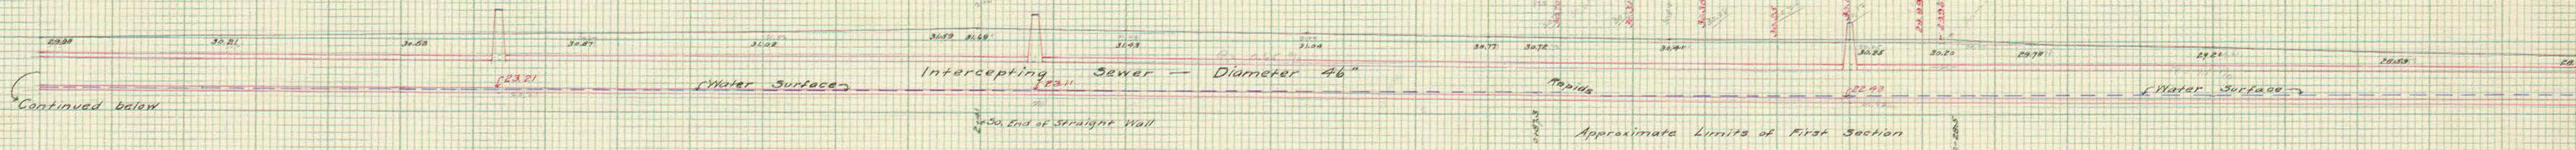

Profile along East and South Sides of
Park River
Adjacent to Grounds of State Capitol at
Hartford, Conn.
Horizontal Scale - 1" = 20'
Vertical Scale 1" = 10'
May 3, 1905

Note: Water Surface Shown as Existing
on Afternoon of May 3, 1905
All Elevations in Black were determined
at same date.
Levels taken on top of Coping as found

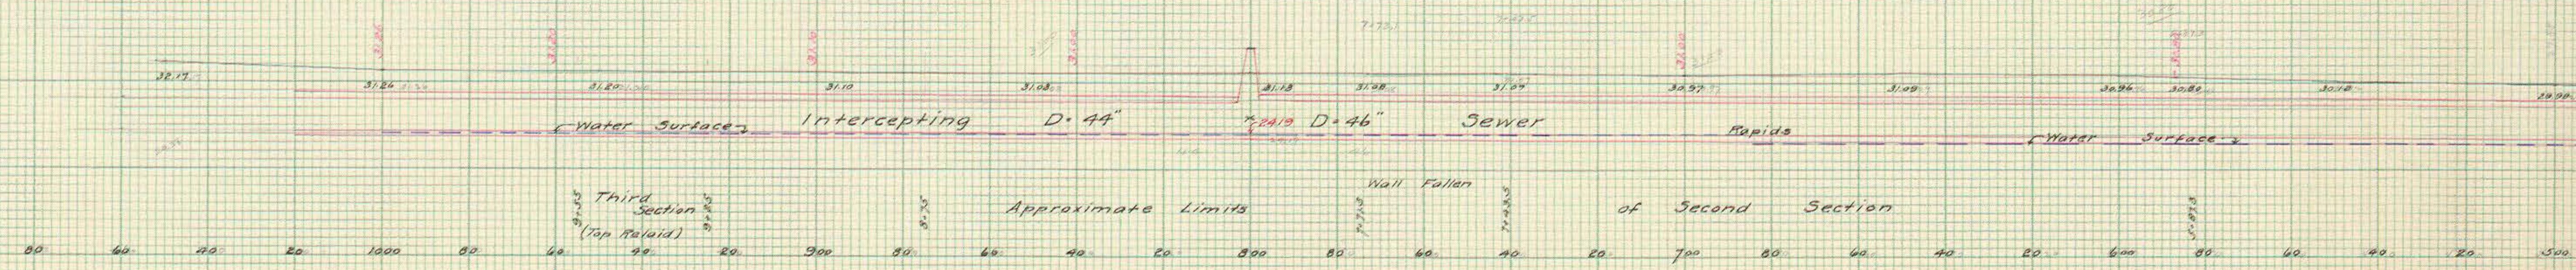

Third
Section
(Top Relaid)

Approximate Limits

Wall Fallen

of Second Section

80 60 40 20 1000 80 60 40 20 900 80 60 40 20 800 80 60 40 20 700 80 60 40 20 600 80 60 40 20 500